PLAT OF SURVEY
OF

LOT 22, GRA DEN WOODS, A SUBDIVISION LOCATED IN THE N 1/2 OF THE SE 1/4 OF SECTION 26, T. 1N., R. 18 E. TOWN OF BLOOMFIELD, WALWORTH COUNTY, WISCONSIN.

FOR: GINO AND MELISSA SANTI
W 534 GRA DEN WOOD LANE
GENOA CITY, WI. 53128

RECEIVED
SEP 16 1985

SCALE 1" = 60'

o = IRON PIPE STAKE SET.
● = SOLID IRON BAR FOUND.
ø = IRON PIPE STAKE FOUND.

BEARING DATUM IS THAT OF RECORDED PLAT.

I have surveyed the above-described property and the map hereon is a true representation thereof and shows the size and location of the property, its exterior boundaries, the location and dimensions of [illegible] structures thereon, fences, apparent [illegible] and roadways [illegible] visible on the [illegible]

This survey [illegible] the present owners of the property, and all those who purchase [illegible] or grantees the title thereto, [illegible] hereof,

Dated at Burlington, Wis. 26th day of July, 1985

John F. Degen
John F. Degen, Land Surveyor S-[illegible]

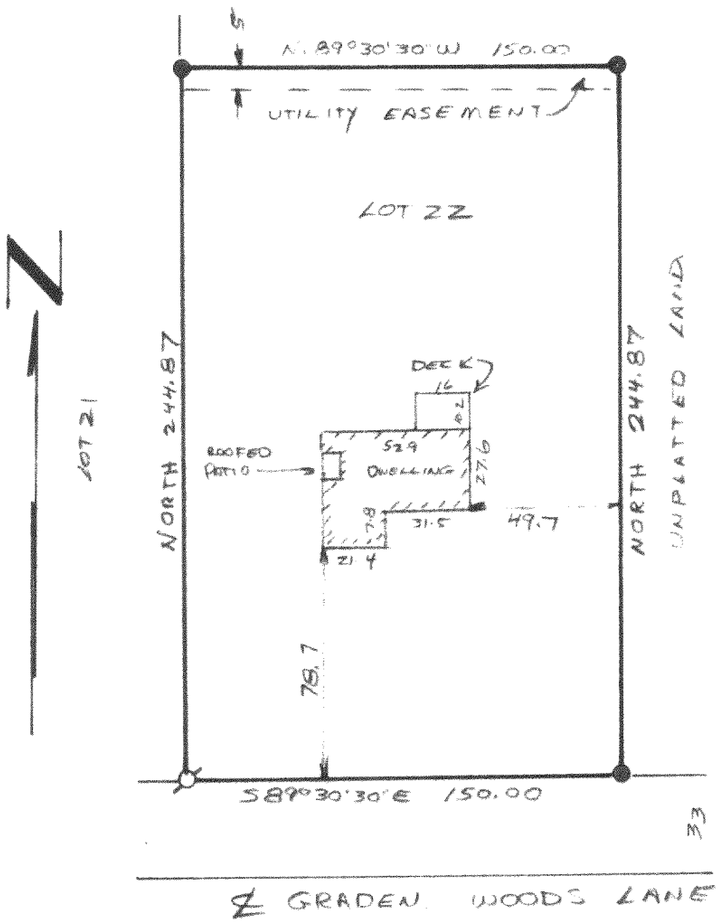

WISCONSIN
JOHN F. DEGEN
BURLINGTON, WIS.
LAND SURVEYOR

118-671-D
11-13-3 #44

MGDW-00022