
WALWORTH COUNTY
SURVEYING & MAPPING
LAKE GENEVA, WISCONSIN

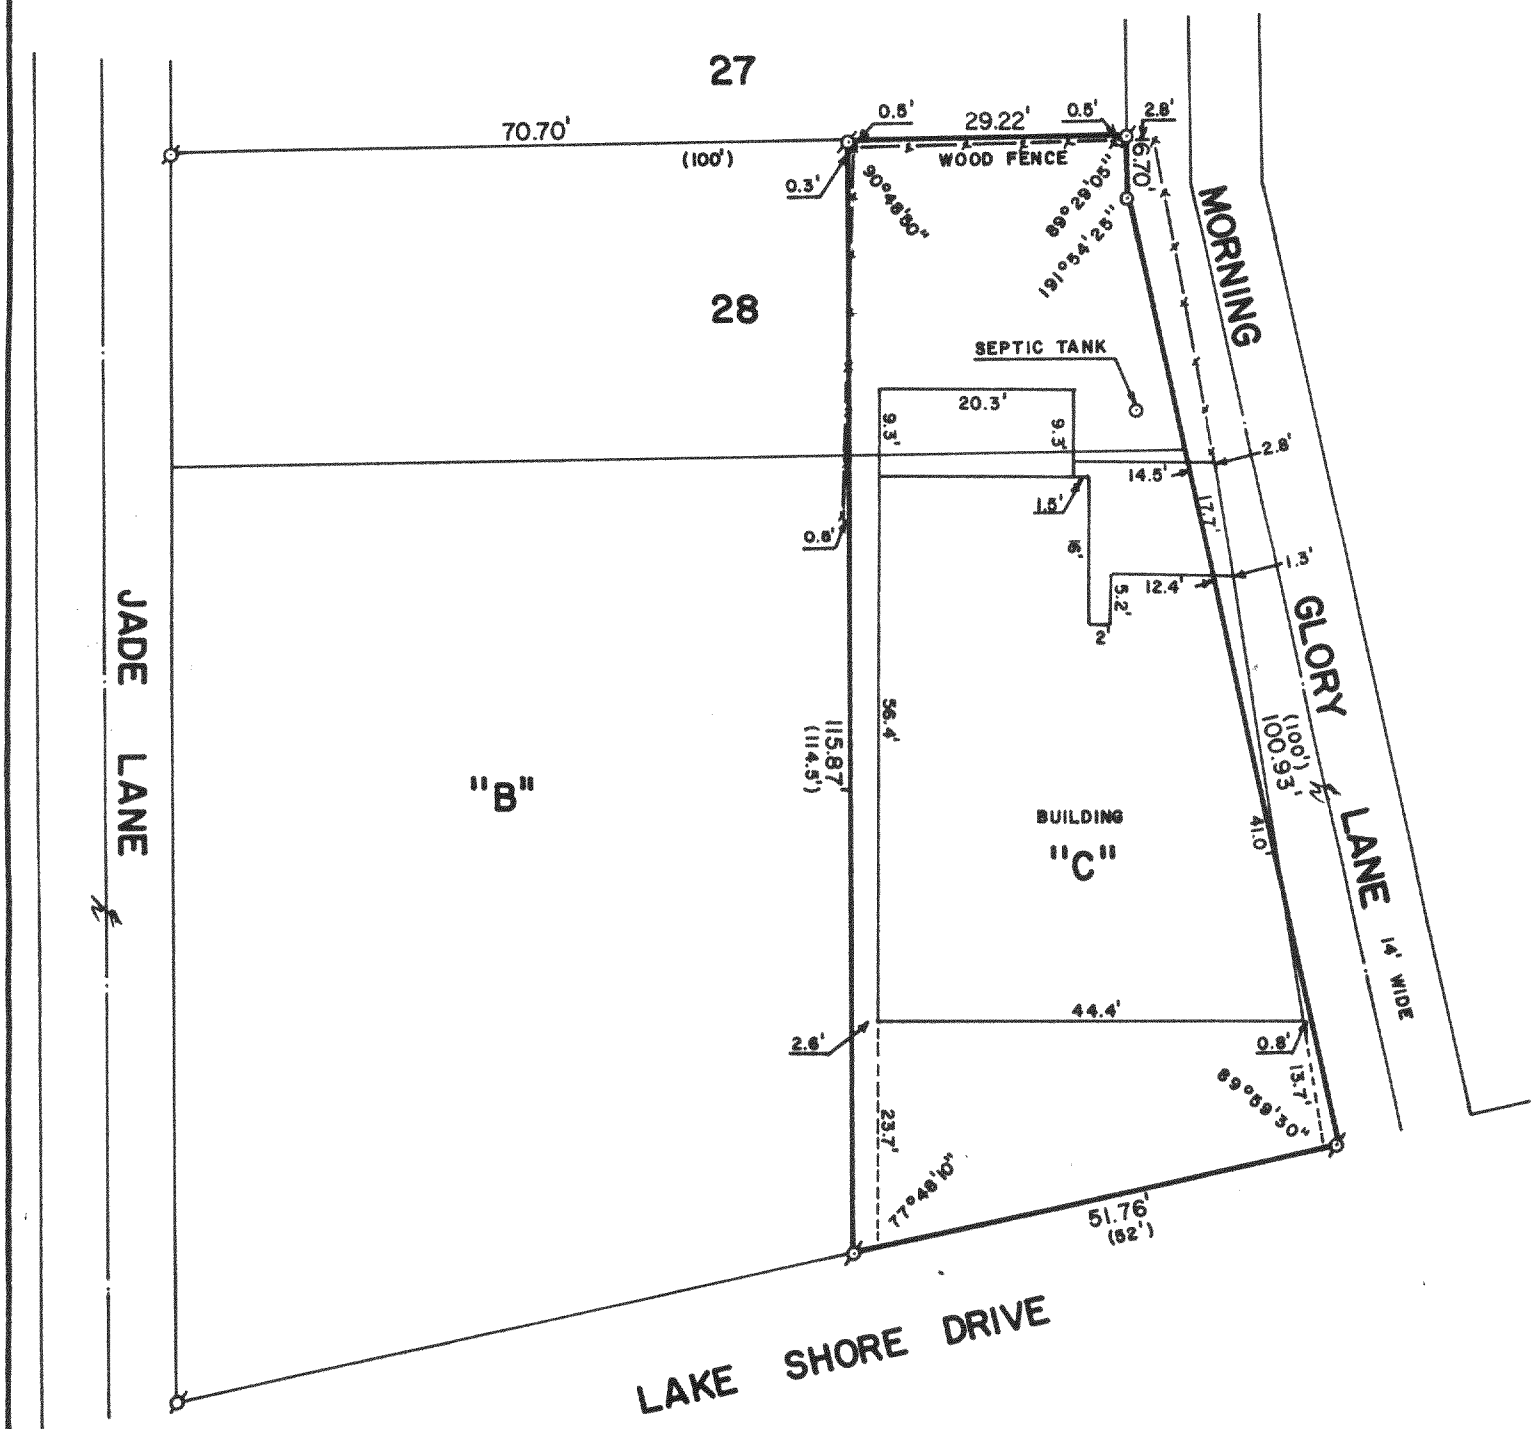

PLAT OF SURVEY OF

LOT 28 EXCEPT THE WESTERLY 70.70 FEET AND ALL OF LOT "C" OF SITTERLE'S SUBDIVISION, T 1 N, R 18 E, WALWORTH COUNTY, WISCONSIN

ORDERED BY: RICHARD BRUGGER
721 GENEVA STREET
LAKE GENEVA, WISCONSIN 53147

ROBERT M BAERENWALD
Lake Geneva, WI.
S-1508

RECEIVED
JUL 3 0 1985

I, ROBERT M. BAERENWALD, DO HEREBY CERTIFY THAT I HAVE SURVEYED THE PROPERTY HEREON DESCRIBED ACCORDING TO THE OFFICIAL RECORDS AND THAT THE PLAT HEREON IS A CORRECT REPRESENTATION OF THE PROPERTY LINES TO THE BEST OF MY KNOWLEDGE AND BELIEF.

Robert M. Baerenwald
ROBERT M. BAERENWALD
WISCONSIN REGISTERED LAND SURVEYOR, S-1508

Nov. 6, 1984
DATE JOB NO. 0142

SCALE: 1"=20'

ø -IRON PIPE FOUND
o -IRON PIPE PLACED
() -RECORDED AS

MS-12.28

118-672-B