KOLB LAND CONSULTING, INC.
LAND SURVEYING · SUBDIVIDING · LAND PLANNING
LAKE GENEVA, WISCONSIN 53147 WHITEWATER, WISCONSIN 53190

RECEIVED
SEP 30 1985

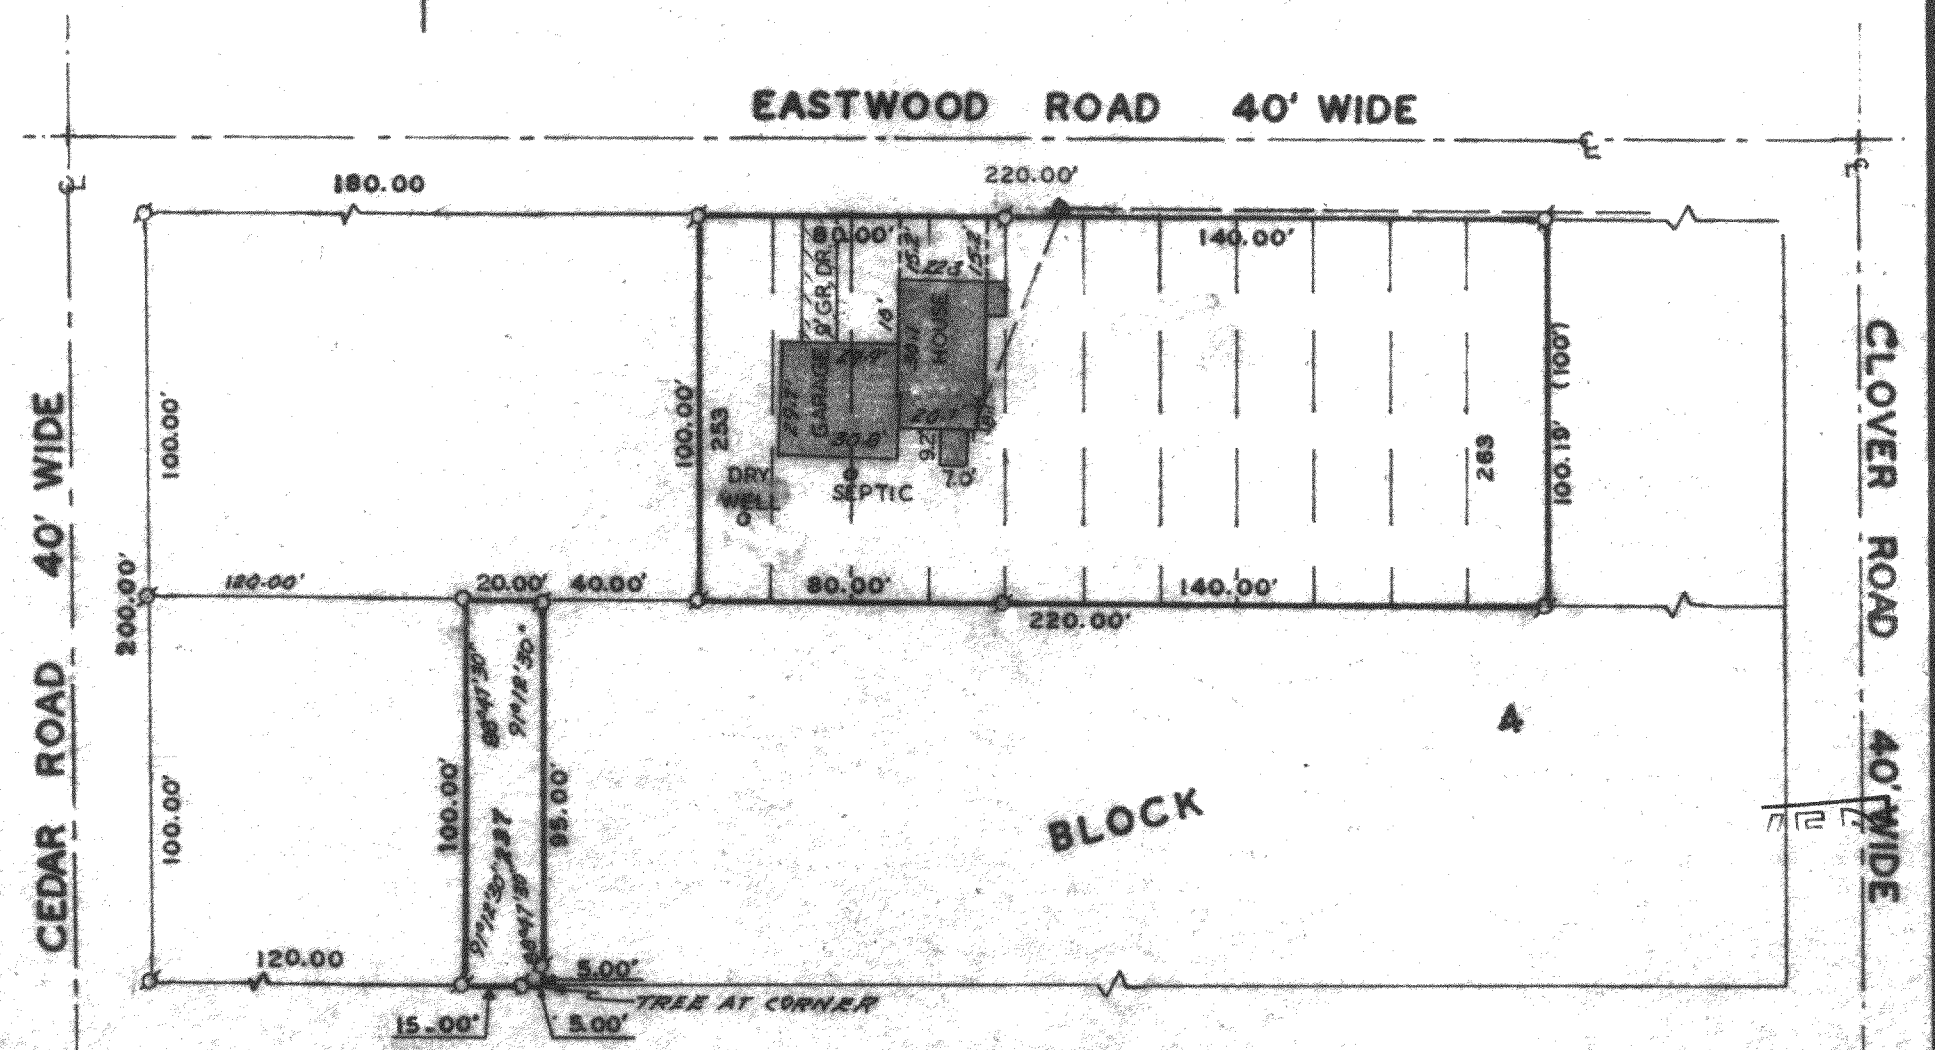

SCALE: 1" = 50'

LEGEND

- Ø - IRON PIPE FOUND
- O - 2" X 24" IRON PIPE RESET
- Δ - UTILITY POLE
- ——— OVERHEAD UTILITY LINE

ORDERED BY: TERRY GAWRYK
4964 MILWAUKEE AVE.
CHICAGO, ILL. 60630

PLAT OF SURVEY OF

LOTS 237, 253-256 AND 257-263, BLOCK 4, PELL LAKE HIGHLANDS, T1N, R18E, TOWN OF BLOOMFIELD, WALWORTH COUNTY, WISCONSIN.

WISCONSIN HAROLD H. KOLB S-187 LAKE GENEVA, WIS. LAND SURVEYOR

I HEREBY CERTIFY THAT I HAVE SURVEYED THE ABOVE DESCRIBED PROPERTY AND THAT THE ABOVE MAP IS A TRUE REPRESENTATION THEREOF AND SHOWS THE SIZE AND LOCATION OF THE PROPERTY, ITS EXTERIOR BOUNDARIES, THE LOCATION OF ALL VISIBLE STRUCTURES AND DIMENSIONS OF ALL PRINCIPAL BUILDINGS THEREON, BOUNDARY FENCES, APPARENT EASEMENTS, ROADWAYS AND VISIBLE ENCROACHMENTS, IF ANY, TO THE BEST OF MY KNOWLEDGE AND BELIEF.
THIS SURVEY IS MADE FOR THE USE OF THE PRESENT OWNERS OF THE PROPERTY, AND ALSO THOSE WHO PURCHASE, MORTGAGE, OR GUARANTEE THE TITLE THERETO WITHIN ONE (1) YEAR FROM DATE HEREOF.

Harold H. Kolb
HAROLD H. KOLB
WISCONSIN REGISTERED LAND SURVEYOR, S-187
DATE AUGUST 12, 1985

53, 55 & 56
MPLH-00052 & MPLH-00056

1-19-433 118-675-K