
WALWORTH COUNTY
SURVEYING & MAPPING
LAKE GENEVA, WISCONSIN

RECEIVED
SEP 16 1985

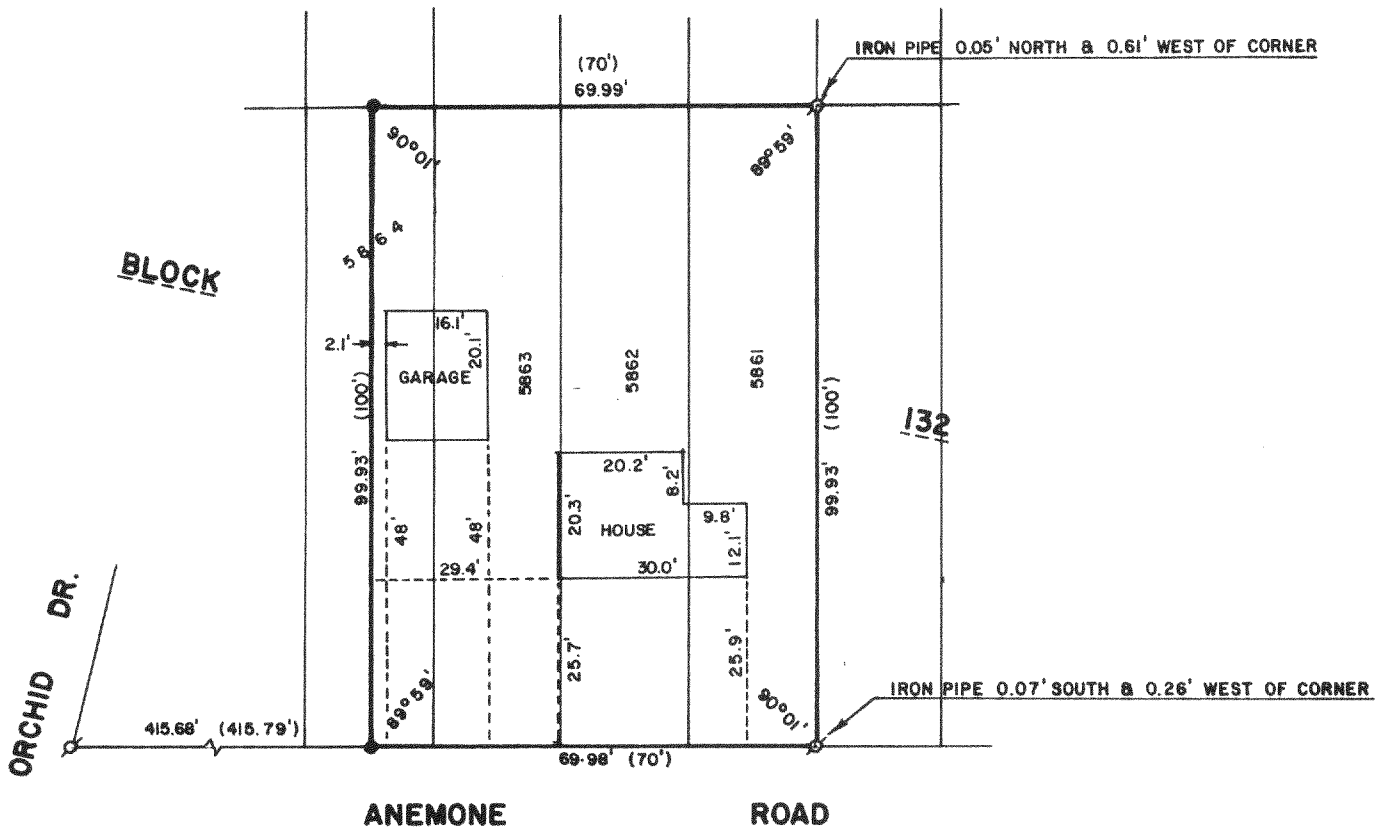

WISCONSIN
ROBERT M.
BAERENWALD
Lake Geneva, WI.
S-1508
LAND SURVEYOR

PLAT OF SURVEY OF

LOTS 5861, 5862, 5863 AND THE EAST 1/2 OF LOT 5864, BLOCK ~~143~~ BLK 132 OF SECTION 4 OF PELL LAKE SUBDIVISION, T 1 N, R 18 E, WALWORTH COUNTY, WISCONSIN.

ORDERED BY: STURG TAGGART AGENCY
736 MAIN STREET
LAKE GENEVA, WISCONSIN
53147

SCALE: 1"=30'

ø -IRON PIPE FOUND
● -IRON ROD SET
()-RECORDED AS

I, ROBERT M. BAERENWALD, DO HEREBY CERTIFY THAT I HAVE SURVEYED THE PROPERTY HEREON DESCRIBED ACCORDING TO THE OFFICIAL RECORDS AND THAT THE PLAT HEREON IS A CORRECT REPRESENTATION OF THE PROPERTY LINES TO THE BEST OF MY KNOWLEDGE AND BELIEF.

Robert M. Baerenwald
ROBERT M. BAERENWALD
WISCONSIN REGISTERED LAND SURVEYOR, S-1508

Sept. 5, 1985
DATE JOB NO. 0340

MPL-01979

115-676-B