PLAT OF SURVEY
OF

LOTS 125 THRU 131 AND LOTS 147 THRU 151 IN BLOCK 3 OF PELL LAKE ADDITION, IN THE SOUTHWEST 1/4 OF SECTION 14, T. 1 N., R. 18 E. TOWN OF BLOOMFIELD, WALWORTH COUNTY, WISCONSIN.

FOR: HOWARD SCALE 1" = 30' o =IRON PIPE STAKE FOUND.

RECEIVED
DEC 10 1985

have surveyed the above described property. The map hereon is a true representation thereof. It shows the size and location of the property, the location of buildings, the location of all visible structures thereon, fences, easements, roads and roadways and visible encroachments thereon.


This survey is prepared for the exclusive use of the present owners of the property, and also those who purchase, mortgage or guarantee the title thereto, within one year from date hereof.

Dated at Burlington, this 23RD day of SEPTEMBER, 1985

John F Degen

John F. Degen, Land Surveyor S-742

WISCONSIN
JOHN F. DEGEN
BURLINGTON, WIS.
LAND SURVEYOR

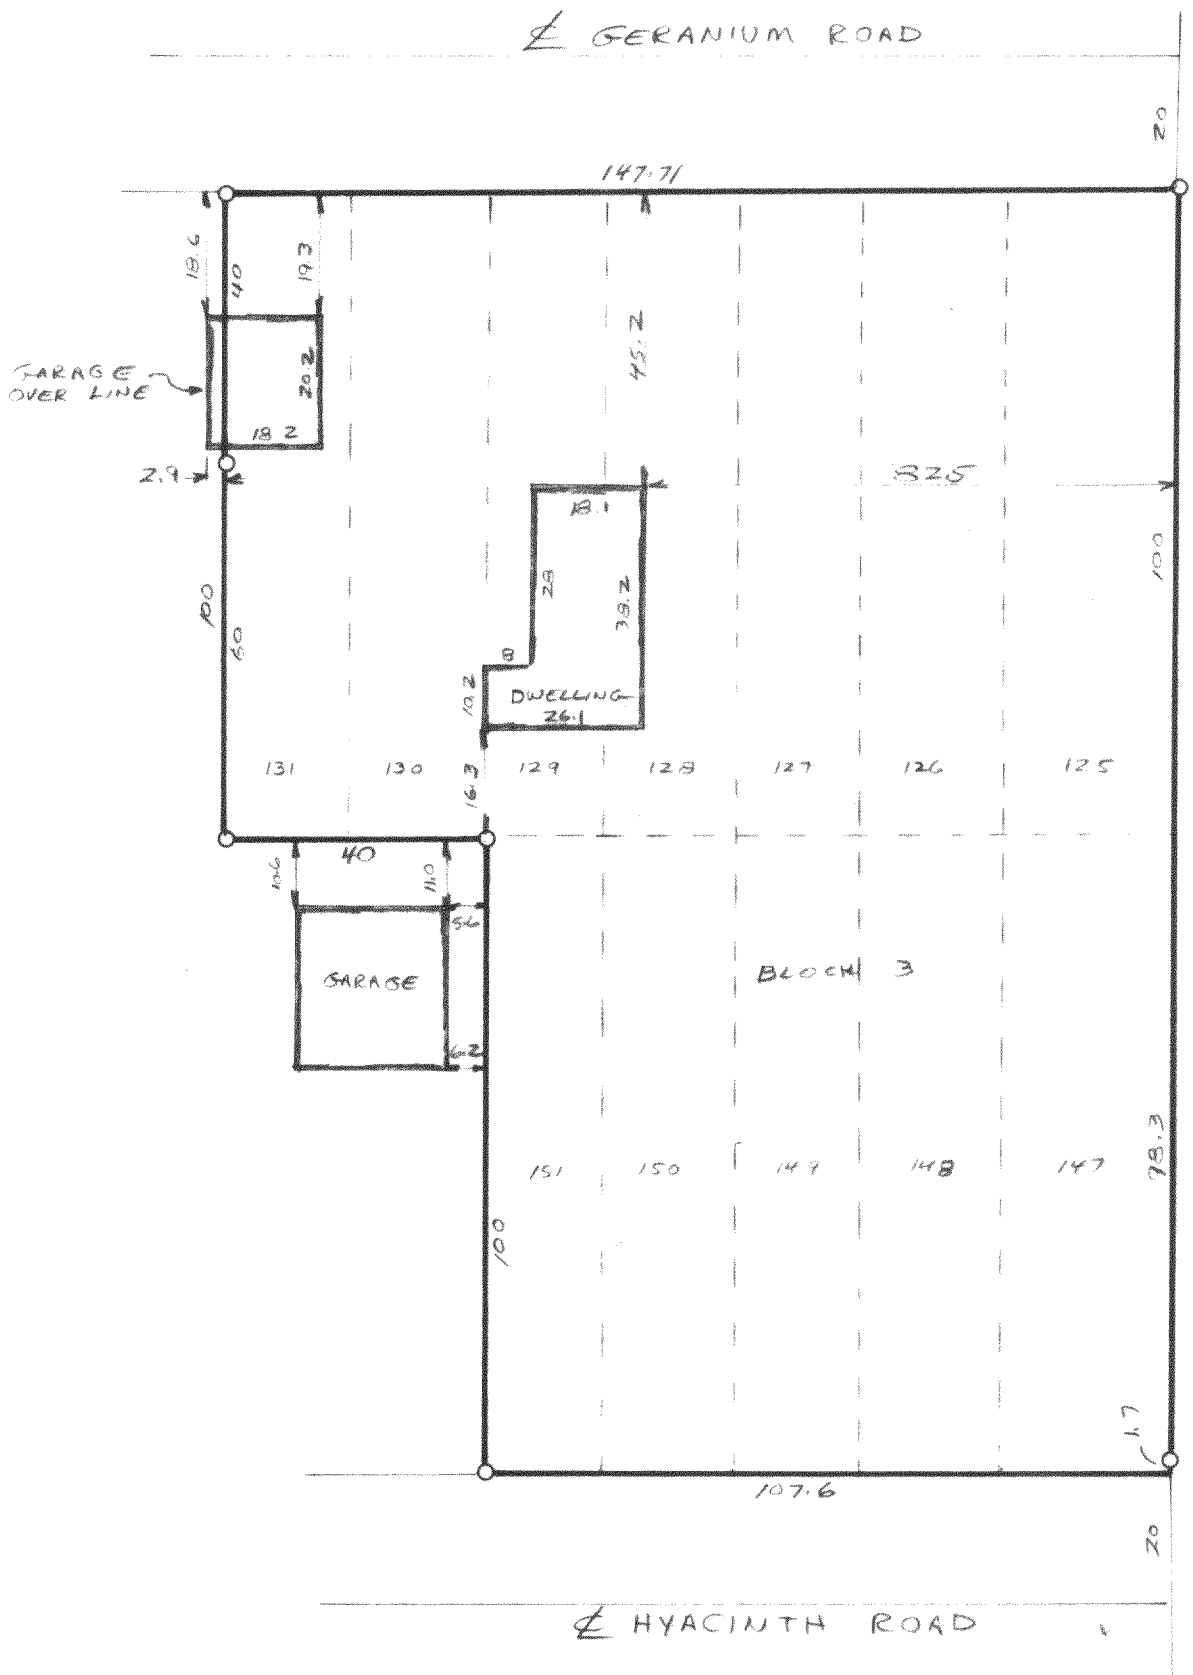

118-679D