
WALWORTH COUNTY
SURVEYING & MAPPING
LAKE GENEVA, WISCONSIN

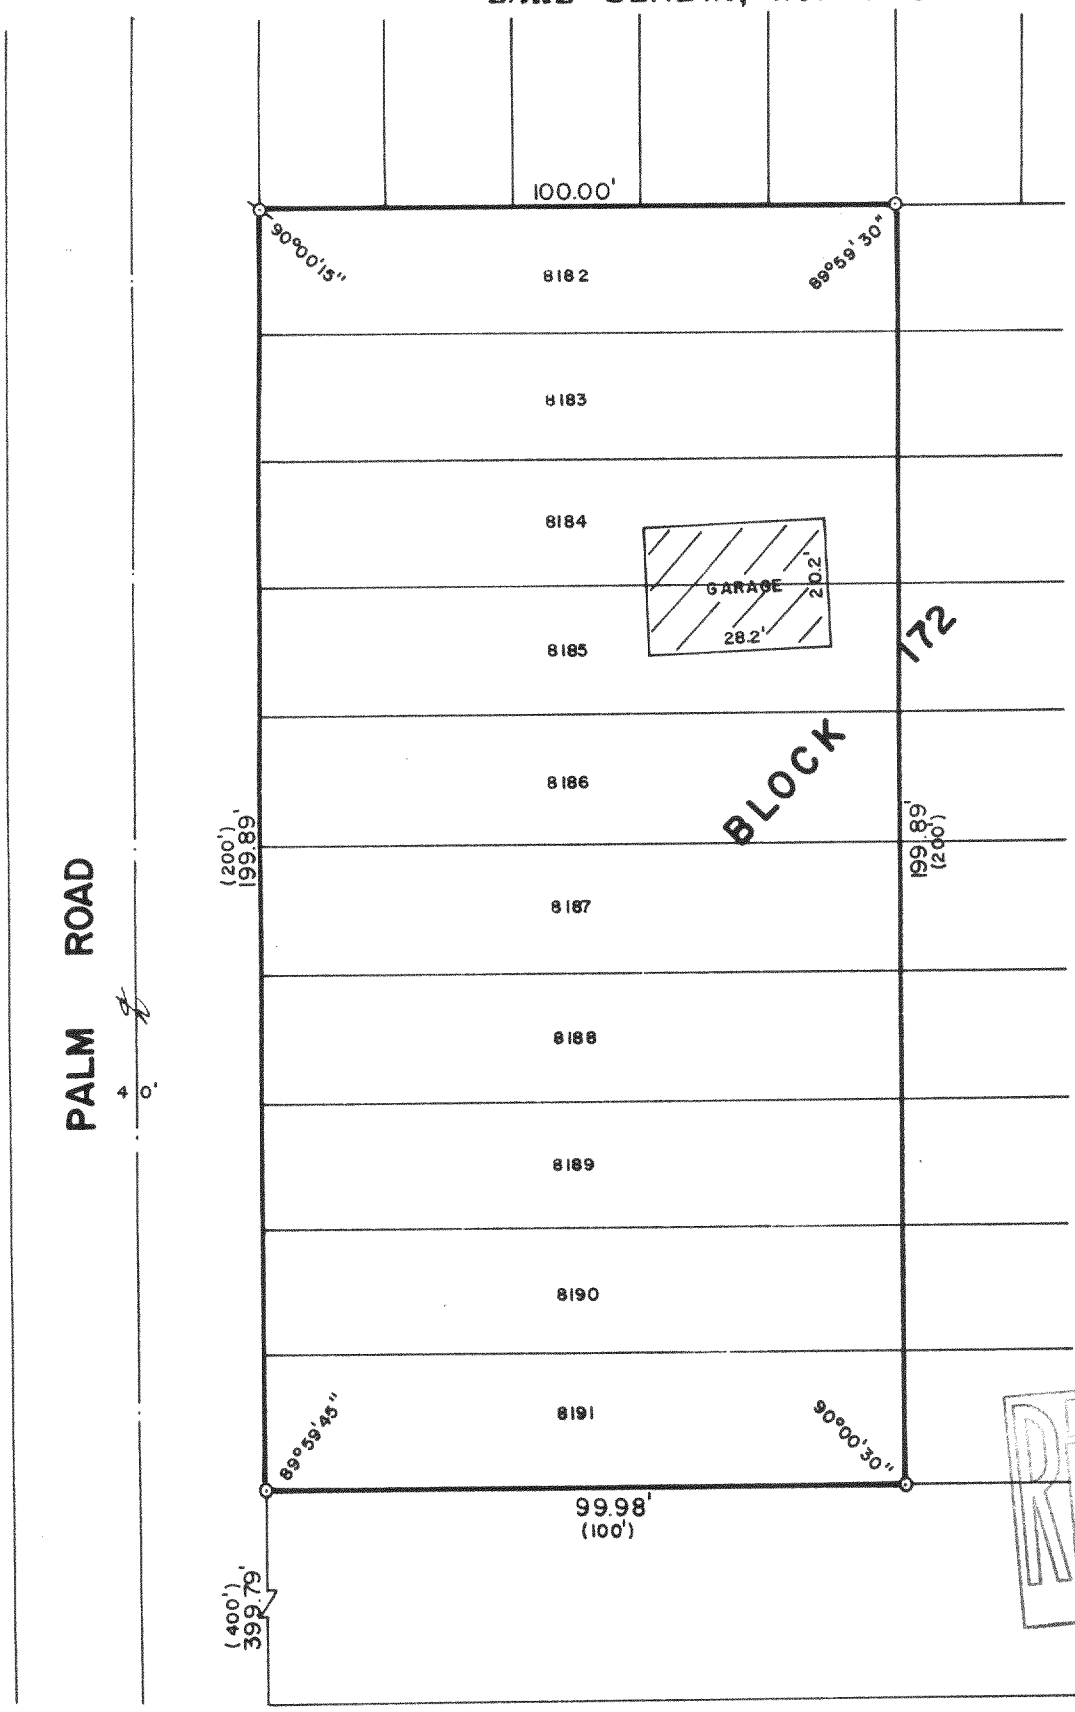

PLAT OF SURVEY OF

LOTS 8182-8191, INCLUSIVE, BLOCK 172 OF
SECTION 5 OF PELL LAKE SUBDIVISION, LOCATED
IN T 1 N, R 18 E, WALWORTH COUNTY, WISCONSIN.

ORDERED BY: ARTHUR DEILAS
RT. 1, BOX 660
GENOA CITY, WISCONSIN 53128

RECEIVED

SCALE: 1" = 30'

○ - IRON PIPE FOUND
● - IRON ROD PLACED
() - RECORDED AS

I, ROBERT M. BAERENWALD, DO HEREBY CERTIFY THAT I HAVE SURVEYED THE PROPERTY HEREON DESCRIBED ACCORDING TO THE OFFICIAL RECORDS AND THAT THE PLAT HEREON IS A CORRECT REPRESENTATION OF THE PROPERTY LINES TO THE BEST OF MY KNOWLEDGE AND BELIEF.

Robert M. Baerenwald

ROBERT M. BAERENWALD
WISCONSIN REGISTERED LAND SURVEYOR, S-1508

Oct 22, 1986

DATE JOB NO. 0776

NOTE: THIS IS NOT A CERTIFIED COPY UNLESS SEALED.

MPL-1637 .1638

118.7228