

PLAT OF SURVEY
OF
LOTS 4 & 5, BLOCK 1, NIPPER SINK PARK, LOCATED IN THE EAST HALF OF THE
NE 1/4 OF SECTION 24, T. 1 N., R. 18 E. OF THE 4TH P.M., TOWNSHIP OF
BLOOMFIELD, COUNTY OF WALWORTH, STATE OF WISCONSIN.

FOR: DAN SULTAN & MAGNUS PETERSEN AND SON.


SCALE 1" EQUALS 20'

Ø DENOTES IRON PIPE STAKE FOUND.

● DENOTES CONCRETE MONUMENT FOUND.

BEARING DATUM IS THAT OF RECORDED PLAT.

E DENOTES ELEVATION ON ASSUMED DATUM.

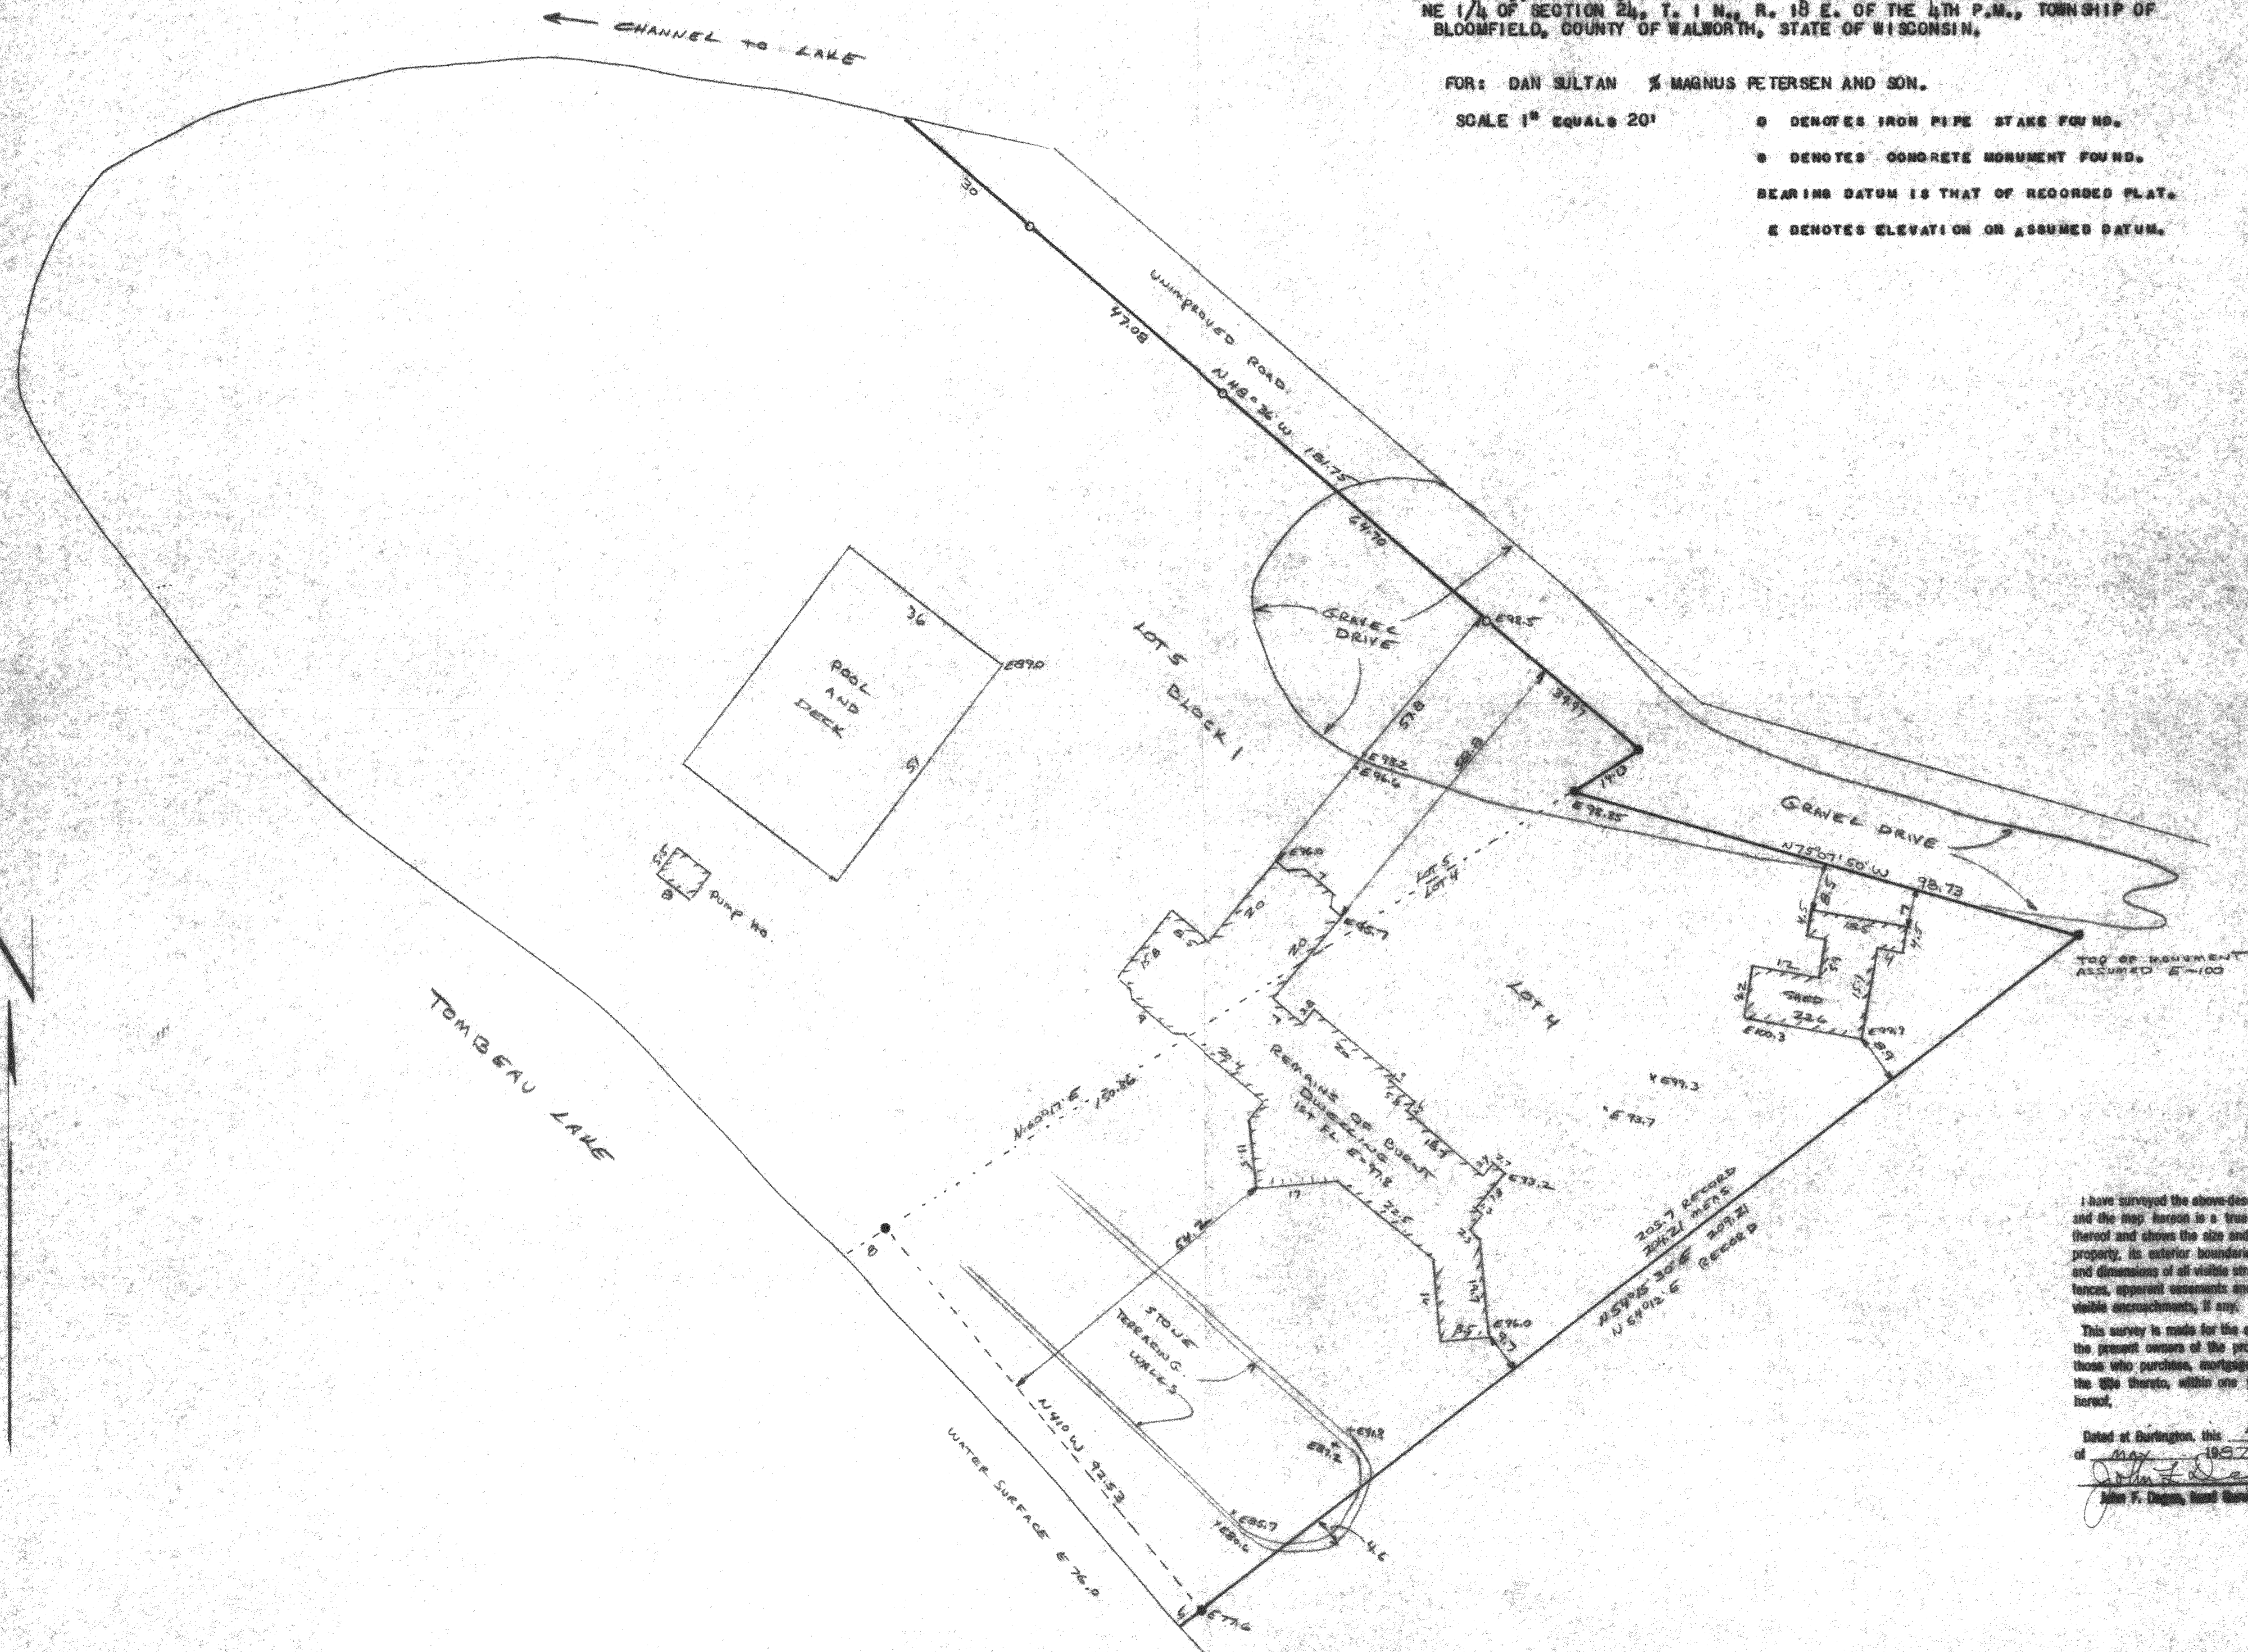

I have surveyed the above-described property, and the map hereon is a true representation thereof and shows the size and location of the property, its exterior boundaries, the location and dimensions of all visible structures thereon, fences, apparent easements and roadways and visible encroachments, if any.

This survey is made for the exclusive use of the present owners of the property, and also those who purchase, mortgage, or guarantee the title thereto, within one year from date hereof.

Dated at Burlington, this 4th day of May, 1987.
John F. Degen
John F. Degen, Land Surveyor & S.D.