PLAT OF SURVEY
OF

LOTS 4274-4276, INCLUSIVE, BLOCK 85 OF SECTION 3 OF PELL LAKE SUBDIVISION, LOCATED IN T. 1 N., R. 18 E., OF THE 4TH P. M., TOWNSHIP OF BLOOMFIELD, WALWORTH COUNTY, WISCONSIN.

FOR: ANDERSON o = IRON PIPE STAKE SET. o = SURVEY MARKER FOUND OF TYPE NOTED ON PLAT.

SCALE: 1" = 20'

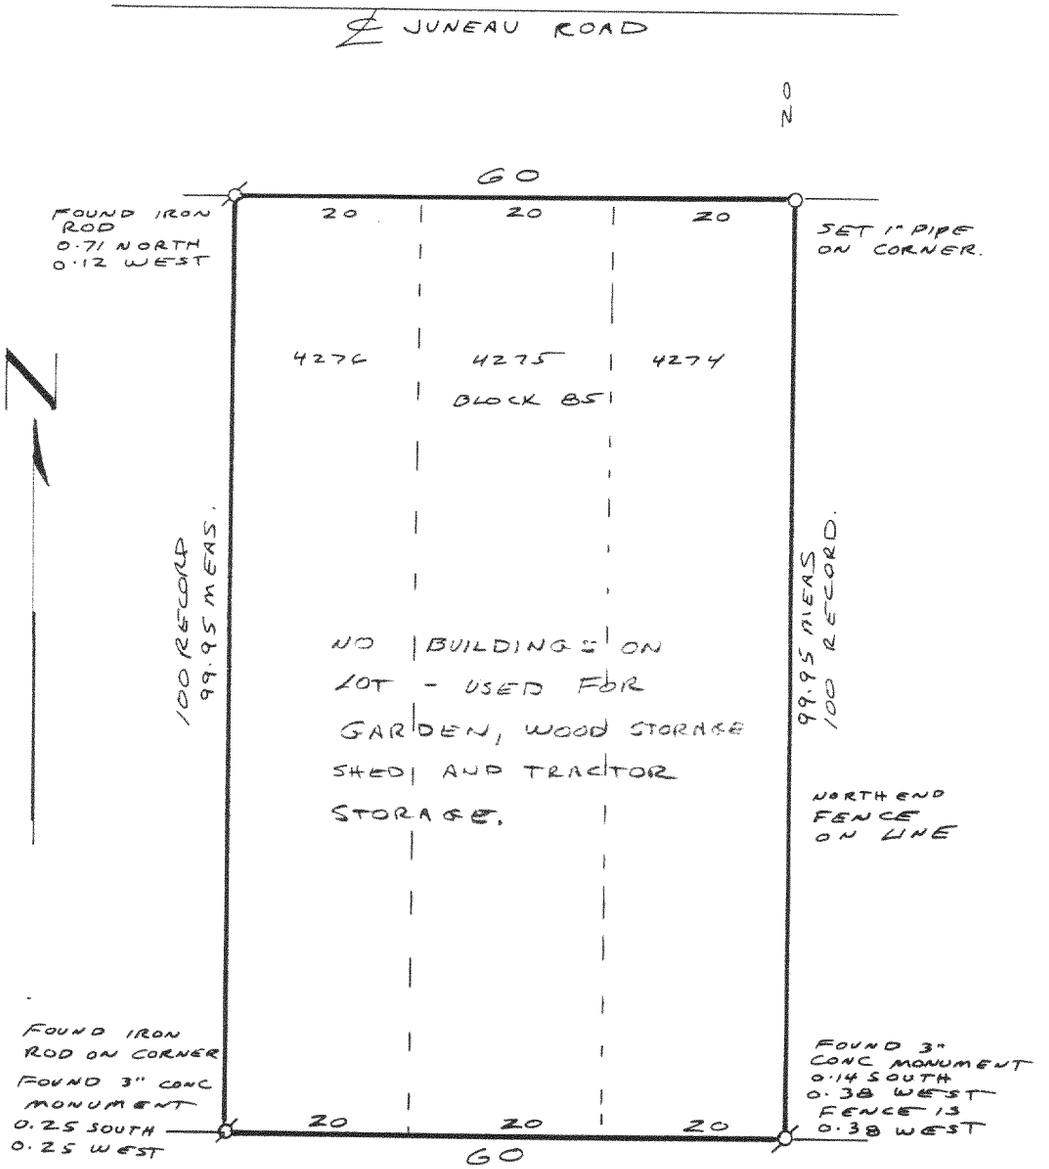

RECEIVED
NOV 15 1989

I have surveyed the above-described property, and this map hereon is a true representation thereof and shows the size and location of the property, its exterior boundaries, location and dimensions of all visible structures thereon, fences, apparent easements and roadways and visible encroachments, if any.

This survey is made for the exclusive use of the present owners of the property, and also those who purchase, mortgage, or guarantee the title thereto, within one year from date hereof.

Dated at Burlington, this 6TH. day of OCT., 1989

John F. Degen

John F. Degen, Land Surveyor S 242
589 N. Pine St. Burlington, WI 53105

MPL - 905