

WALWORTH COUNTY
SURVEYING & MAPPING
LAKE GENEVA, WISCONSIN
414-248-0505

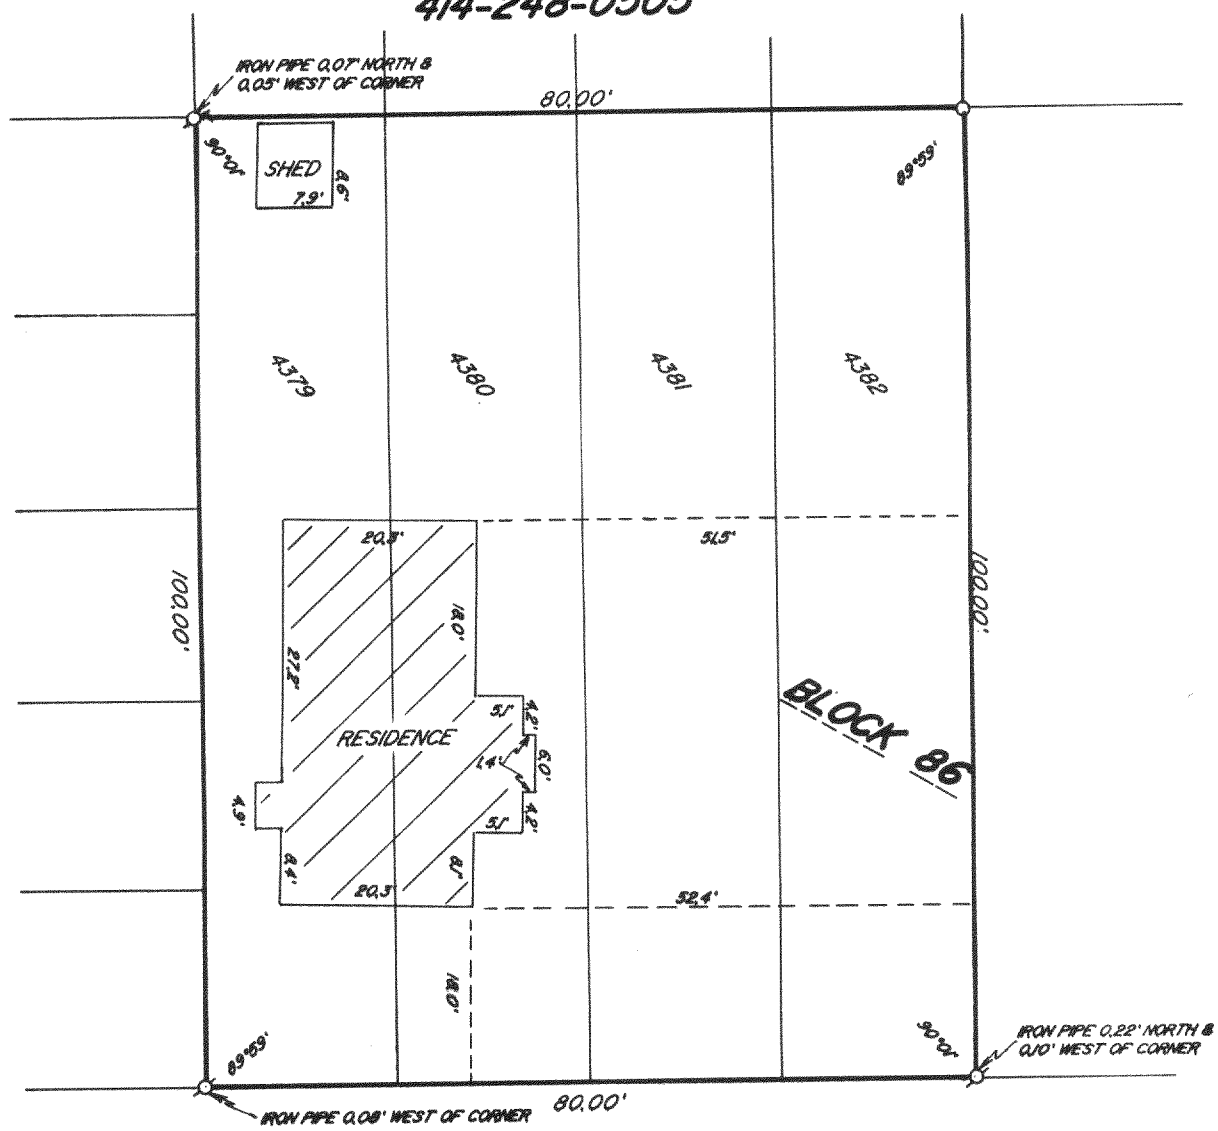

25'


FLORENCE ROAD

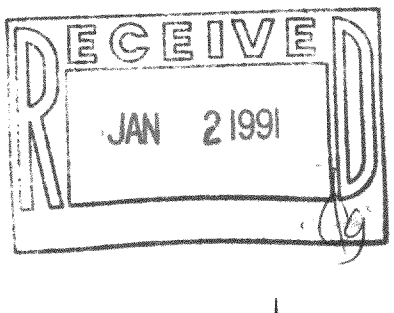

PLAT OF SURVEY OF

LOTS NUMBERED 4379, 4380, 4381 AND 4382
INCLUSIVE IN SECTION 3 OF PELL LAKE,
A SUBDIVISION OF RECORD IN T 1 N, R 18 E,
WALWORTH COUNTY, WISCONSIN.

ORDERED BY: ATTORNEY TIM SWATEK
P. O. BOX 760
LAKE GENEVA, WISCONSIN
53147

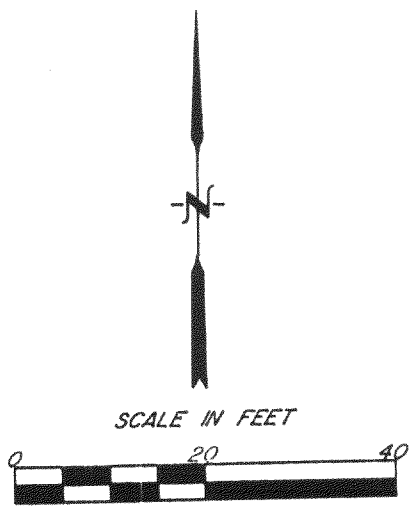

ø-IRON PIPE FOUND
()-RECORDED AS

I HEREBY CERTIFY THAT I HAVE SURVEYED THE ABOVE DESCRIBED PROPERTY AND THAT THE ABOVE MAP IS A TRUE REPRESENTATION THEREOF AND SHOWS THE SIZE AND LOCATION OF THE PROPERTY, ITS EXTERIOR BOUNDARIES, THE LOCATION OF ALL VISIBLE STRUCTURES AND DIMENSIONS OF ALL PRINCIPAL BUILDINGS THEREON, BOUNDARY FENCES, APPARENT EASEMENTS AND ROADWAYS AND VISIBLE ENCROACHMENTS, IF ANY, TO THE BEST OF MY KNOWLEDGE AND BELIEF.

THIS SURVEY IS MADE FOR THE USE OF THE PRESENT OWNERS OF THE PROPERTY AND ALSO THOSE WHO PURCHASE, MORTGAGE OR GUARANTEE THE TITLE THERETO WITHIN ONE (1) YEAR FROM DATE HEREOF.

Robert M. Baerenwald

ROBERT M. BAERENWALD
WISCONSIN REGISTERED LAND SURVEYOR, S-1508

DATE Jan. 17, 1990 JOB NO. 2334

NOTE: THIS IS NOT A CERTIFIED COPY UNLESS SEALED

Survey #118-930

TAx KEY #
MPL 00929