HAROLD H. KOLB
REGISTERED PROFESSIONAL LAND SURVEYOR
LAKE GENEVA, WISCONSIN

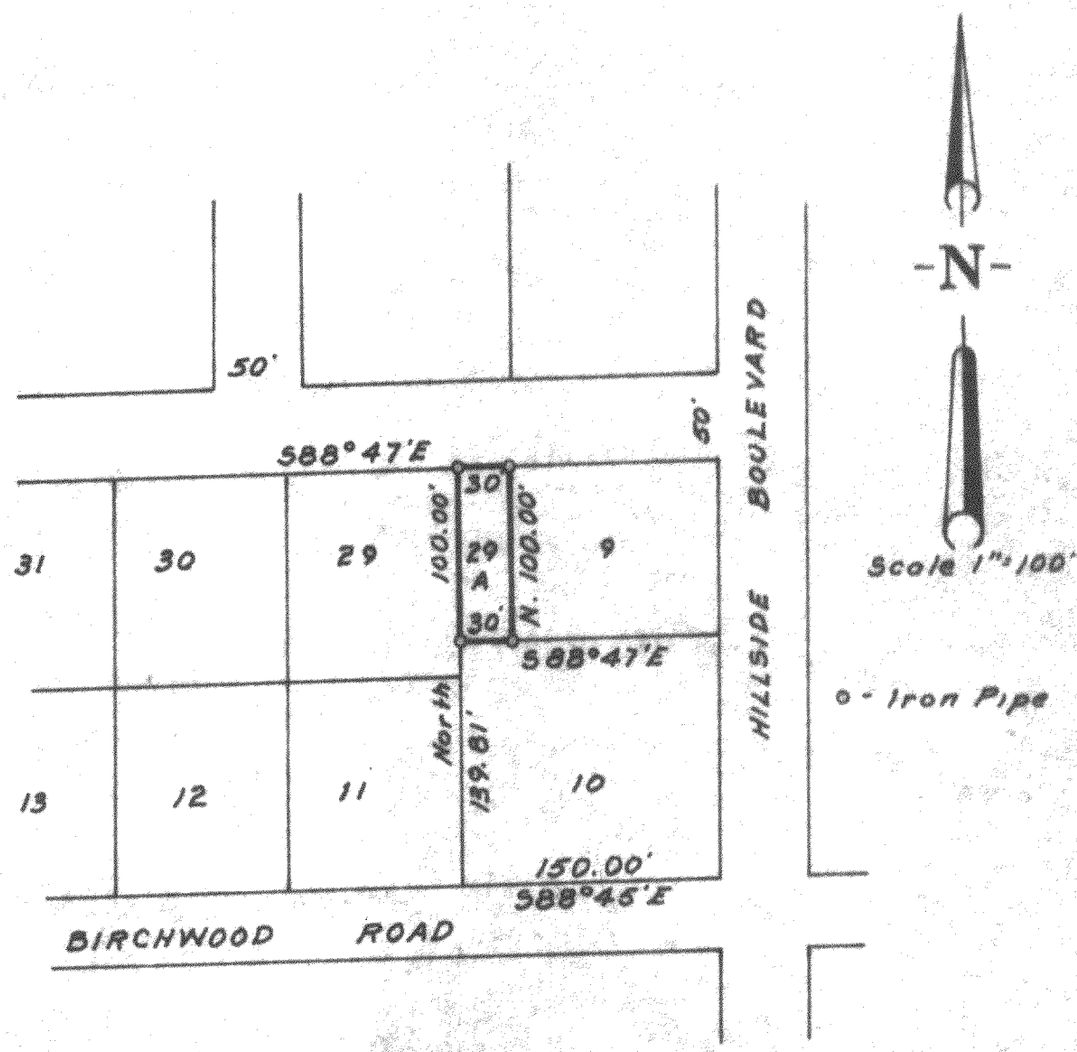

Lot 29 A

A parcel of land located in the "Golf Course" as shown on the recorded plat of Fell Lake Highlands, in the Southeast 1/4 of Section 16, T 1 N, R 18 E, Walworth County, Wisconsin and described as follows; towit: Commencing at the intersection of the North line of Birchwood Road and the West line of Hillside Boulevard; thence N 88°45' W 150.00 feet; thence North 139.81 feet to the place of beginning; thence continue North 100.00 feet; thence S 88°47' E 30.00 feet; thence South 100.00 feet; thence N 88°47' W 30.00 feet to the palce of beginning.

Harold H. Kolb

Harold H. Kolb, Wisconsin Surveyor, S-157

PLH-343 (part of)

118-96