


DUNHAM SURVEYING, S.C.
SURVEYING & SUBDIVIDING
DELAVAN, WISCONSIN 53115

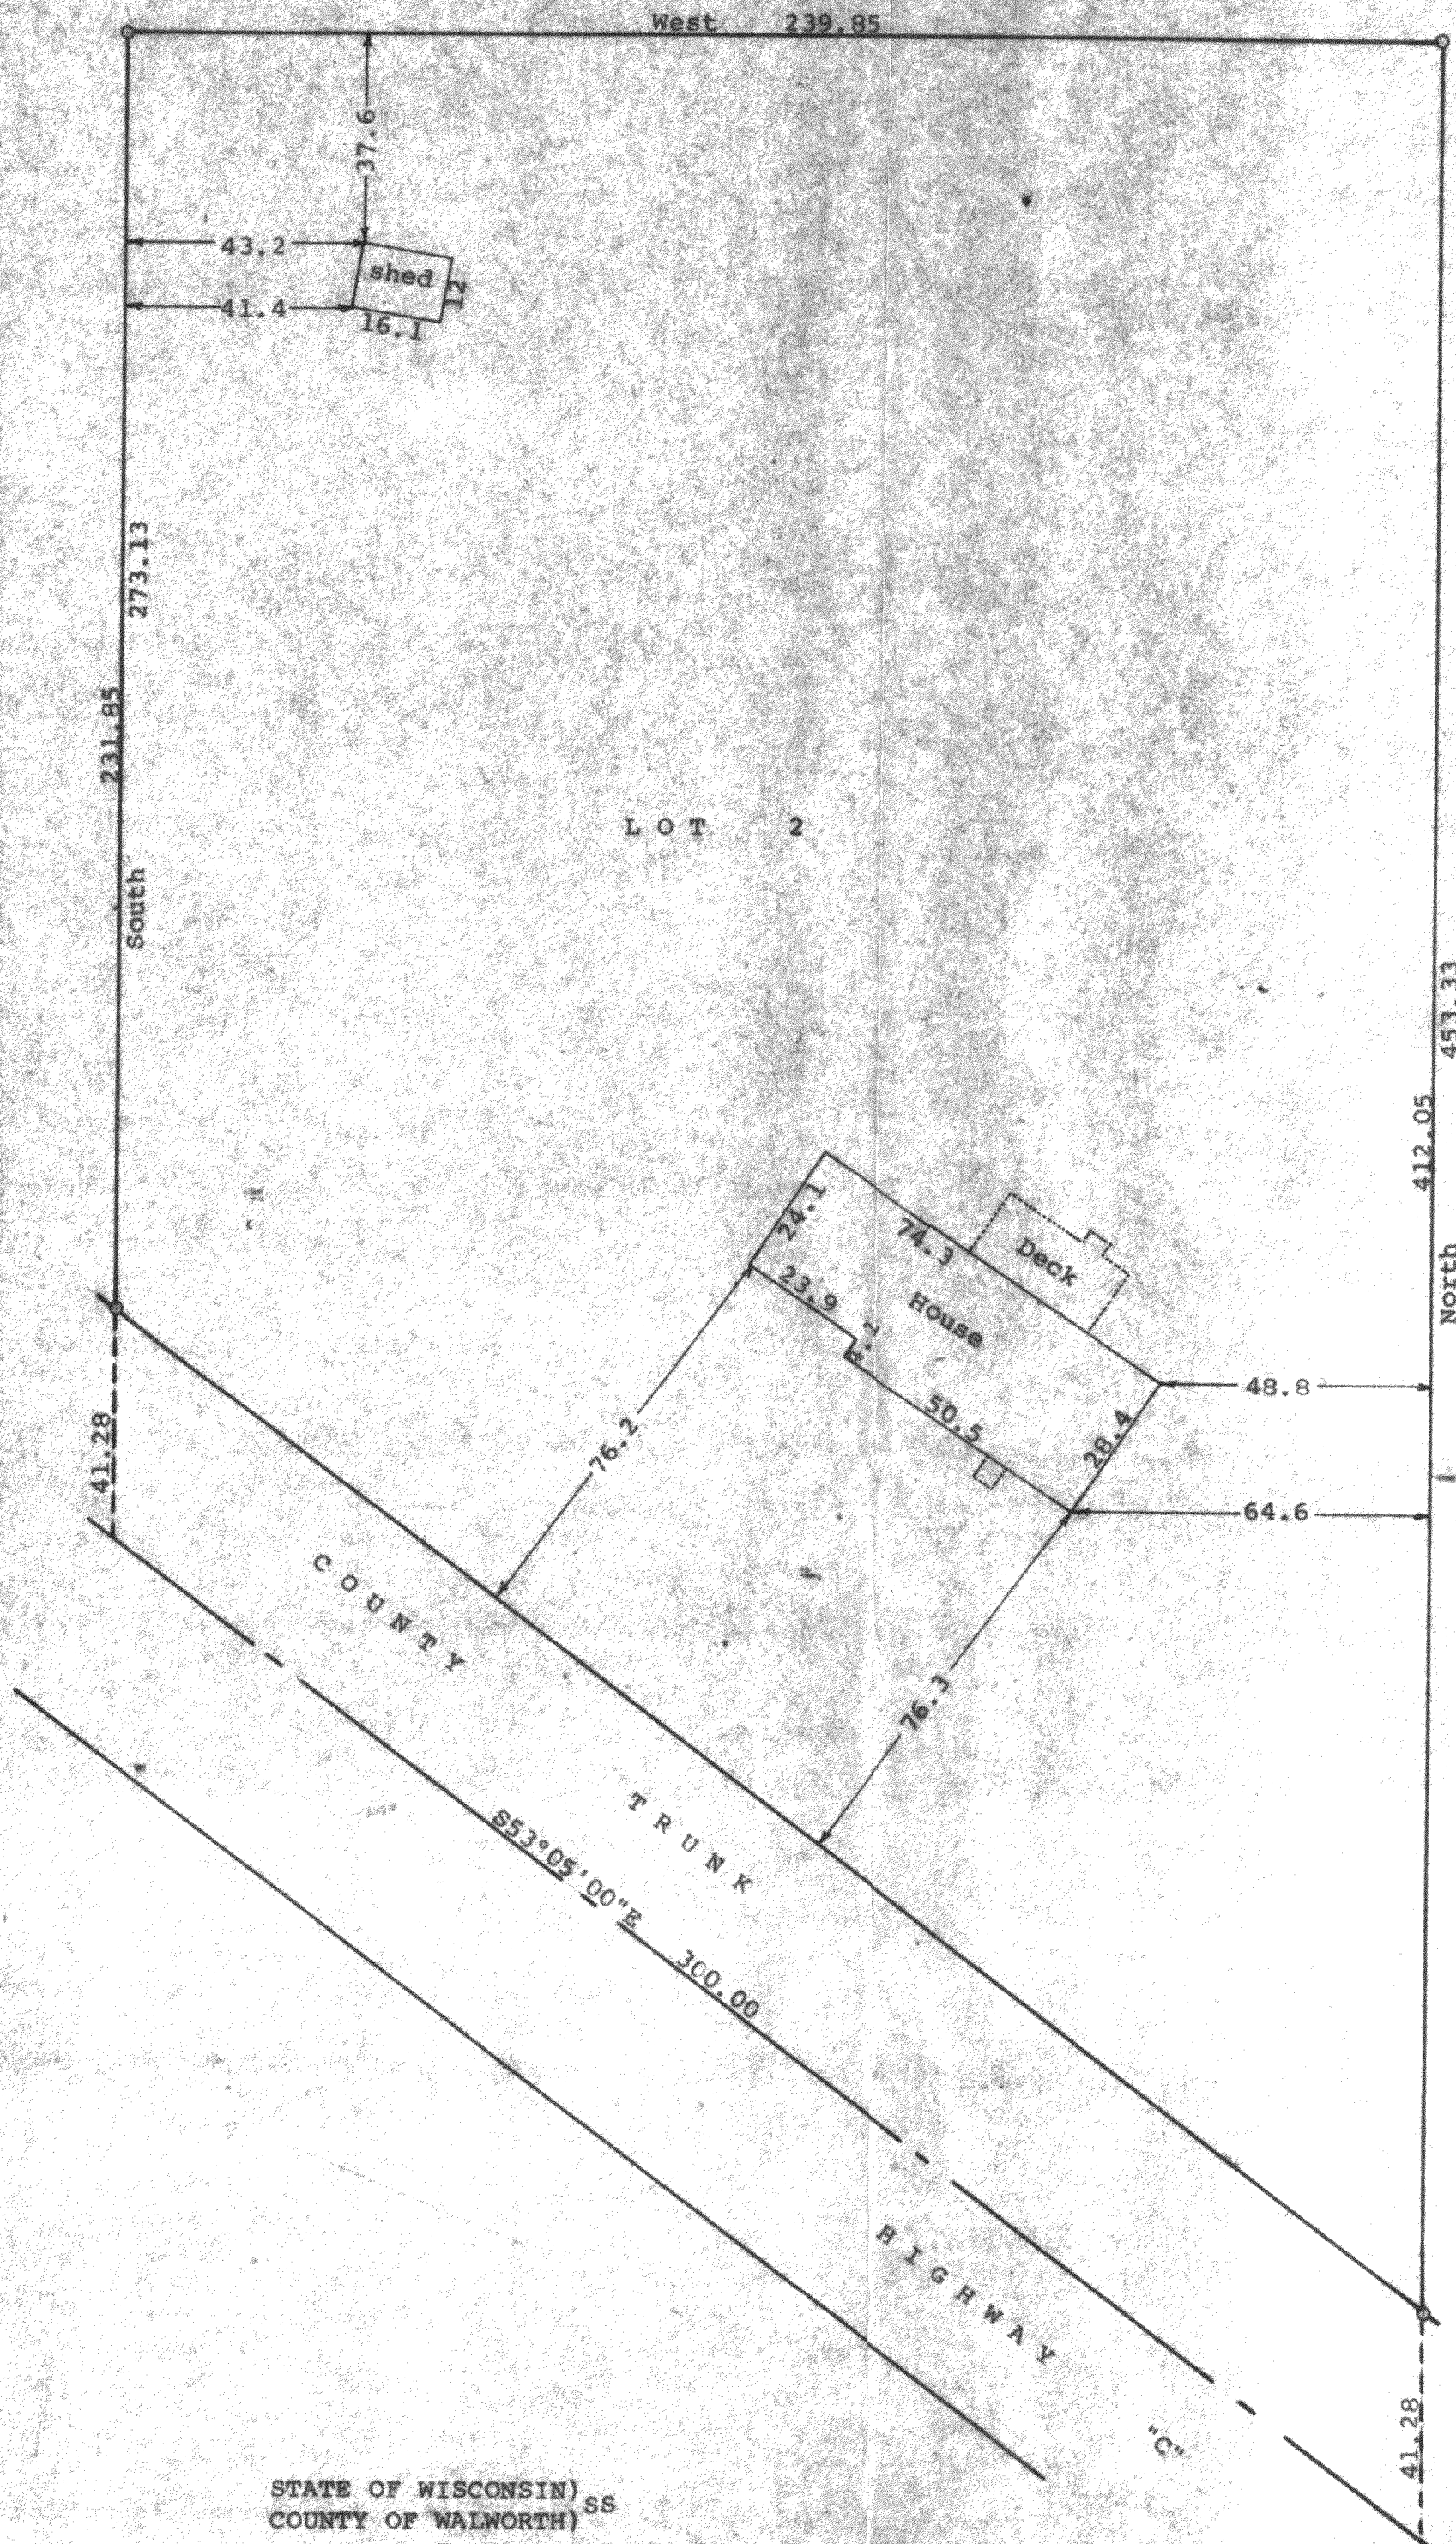



Scale - 1" = 30'
o = 1" Iron Pipe Found
Bearings are those on the recorded
plat of Certified Survey No. 2449
Survey ordered by: Allen Krause
N3744 C. T. H. "C"
Darien, WI 53114

STATE OF WISCONSIN)
COUNTY OF WALWORTH) SS

I, George T. Dunham, Surveyor, certify that I have surveyed the
property described as follows:

Lot 2 of Certified Survey No. 2449, recorded in Volume 12 of
Certified Surveys on Page 119, Document No. 285746, on May 25,
1994, in the Office of the Register of Deeds, Walworth County,
Wisconsin, being a parcel of land located in the Southwest 1/4
of Section 17, T 2 N, R 15 E, Walworth County, Wisconsin,
and that the plat shown hereon is a correct representation thereof and shows
the size and location of the property, its exterior boundaries, the location
of all visible structures and dimensions of all principal buildings thereon,
boundary fences, apparent easements, roadways and visible encroachments, if
any, and that I have surveyed the property hereon described, according to the
official records, to the best of my knowledge and belief
October 13, 1994

George T. Dunham
George T. Dunham, Surveyor

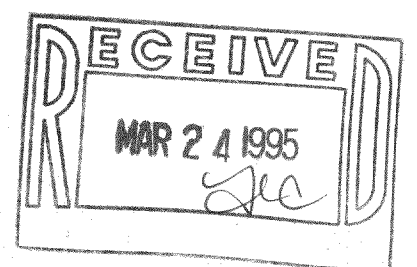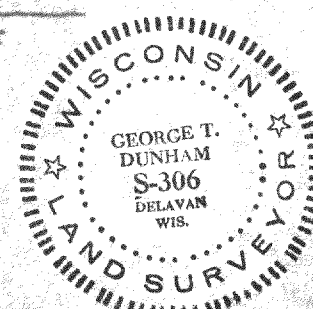

BA-2449-2

215-374