Plat of Survey

of

Lot 2 of Certified Survey Map No. 3726,

recorded in Vol. 22 of Certified Survey Maps of Walworth County on Page 191 located in the Southwest 1/4 and the Northwest 1/4 of Section 33, Town 2 North, Range 15 East, Town of Darien, Walworth County, Wisconsin.

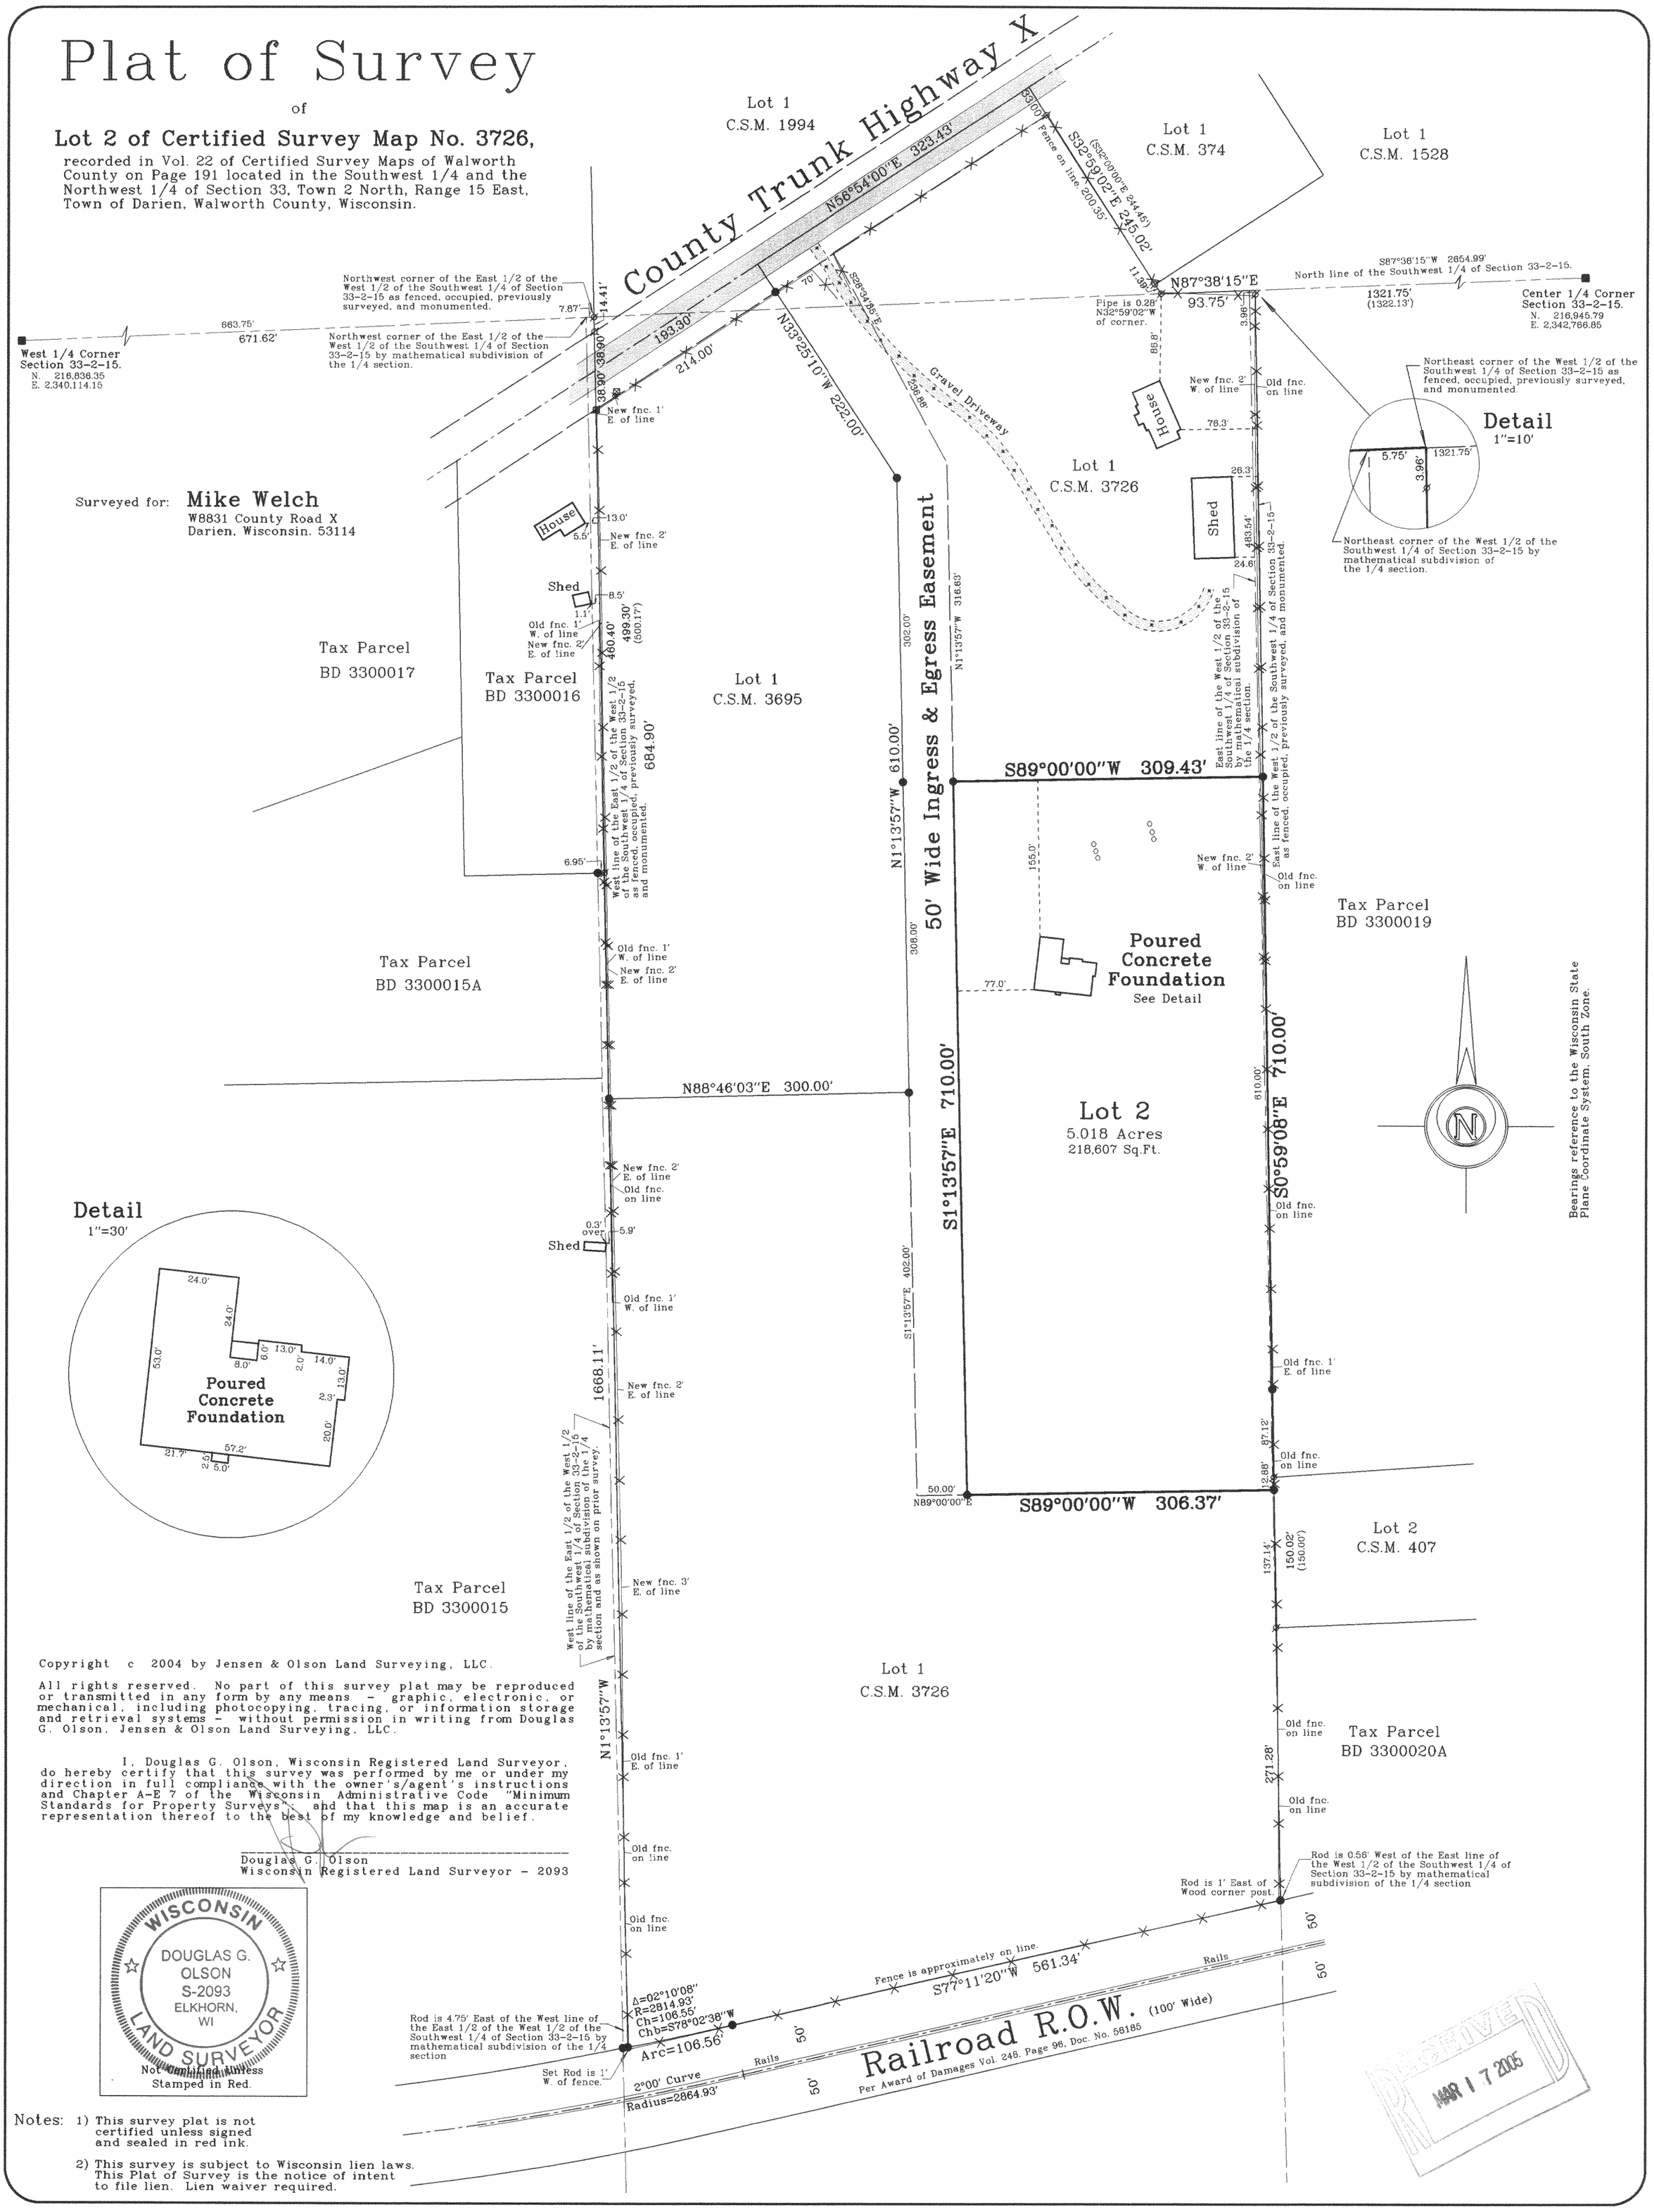

Copyright c 2004 by Jensen & Olson Land Surveying, LLC.

All rights reserved. No part of this survey plat may be reproduced or transmitted in any form by any means - graphic, electronic, or mechanical, including photocopying, tracing, or information storage and retrieval systems - without permission in writing from Douglas G. Olson, Jensen & Olson Land Surveying, LLC.

I, Douglas G. Olson, Wisconsin Registered Land Surveyor, do hereby certify that this survey was performed by me or under my direction in full compliance with the owner's/agent's instructions and Chapter A-E 7 of the Wisconsin Administrative Code "Minimum Standards for Property Surveys", and that this map is an accurate representation thereof to the best of my knowledge and belief.

Douglas G. Olson
Wisconsin Registered Land Surveyor - 2093

Notes: 1) This survey plat is not certified unless signed and sealed in red ink.

2) This survey is subject to Wisconsin lien laws. This Plat of Survey is the notice of intent to file lien. Lien waiver required.

2005.001

Sheet 1 of 1 Sheets

Job Reference Number
2005.001

Legend
- ■ Found County Section Corner
- ⌀ Found Iron Pipe ☆ Soil Boring
- ● Found Iron Rod ◇ Septic Vent
- ○ Set Iron Rod, 3/4" dia.
- ( ) Recorded Information
- Utility Pole Utility Pedestal
- Asphalt Surface Gravel

Jensen & Olson Land Surveying, LLC
45 South Wisconsin Street P.O. Box 322
Elkhorn, Wisconsin. 53121
Telephone (262) 723-3434
Facsimile (262) 723-8044

Scale in Feet
1" = 100'
0' 50' 100' 200'

Survey Date: January 7, 2005.
Revisions:

BA37660802

215-590