

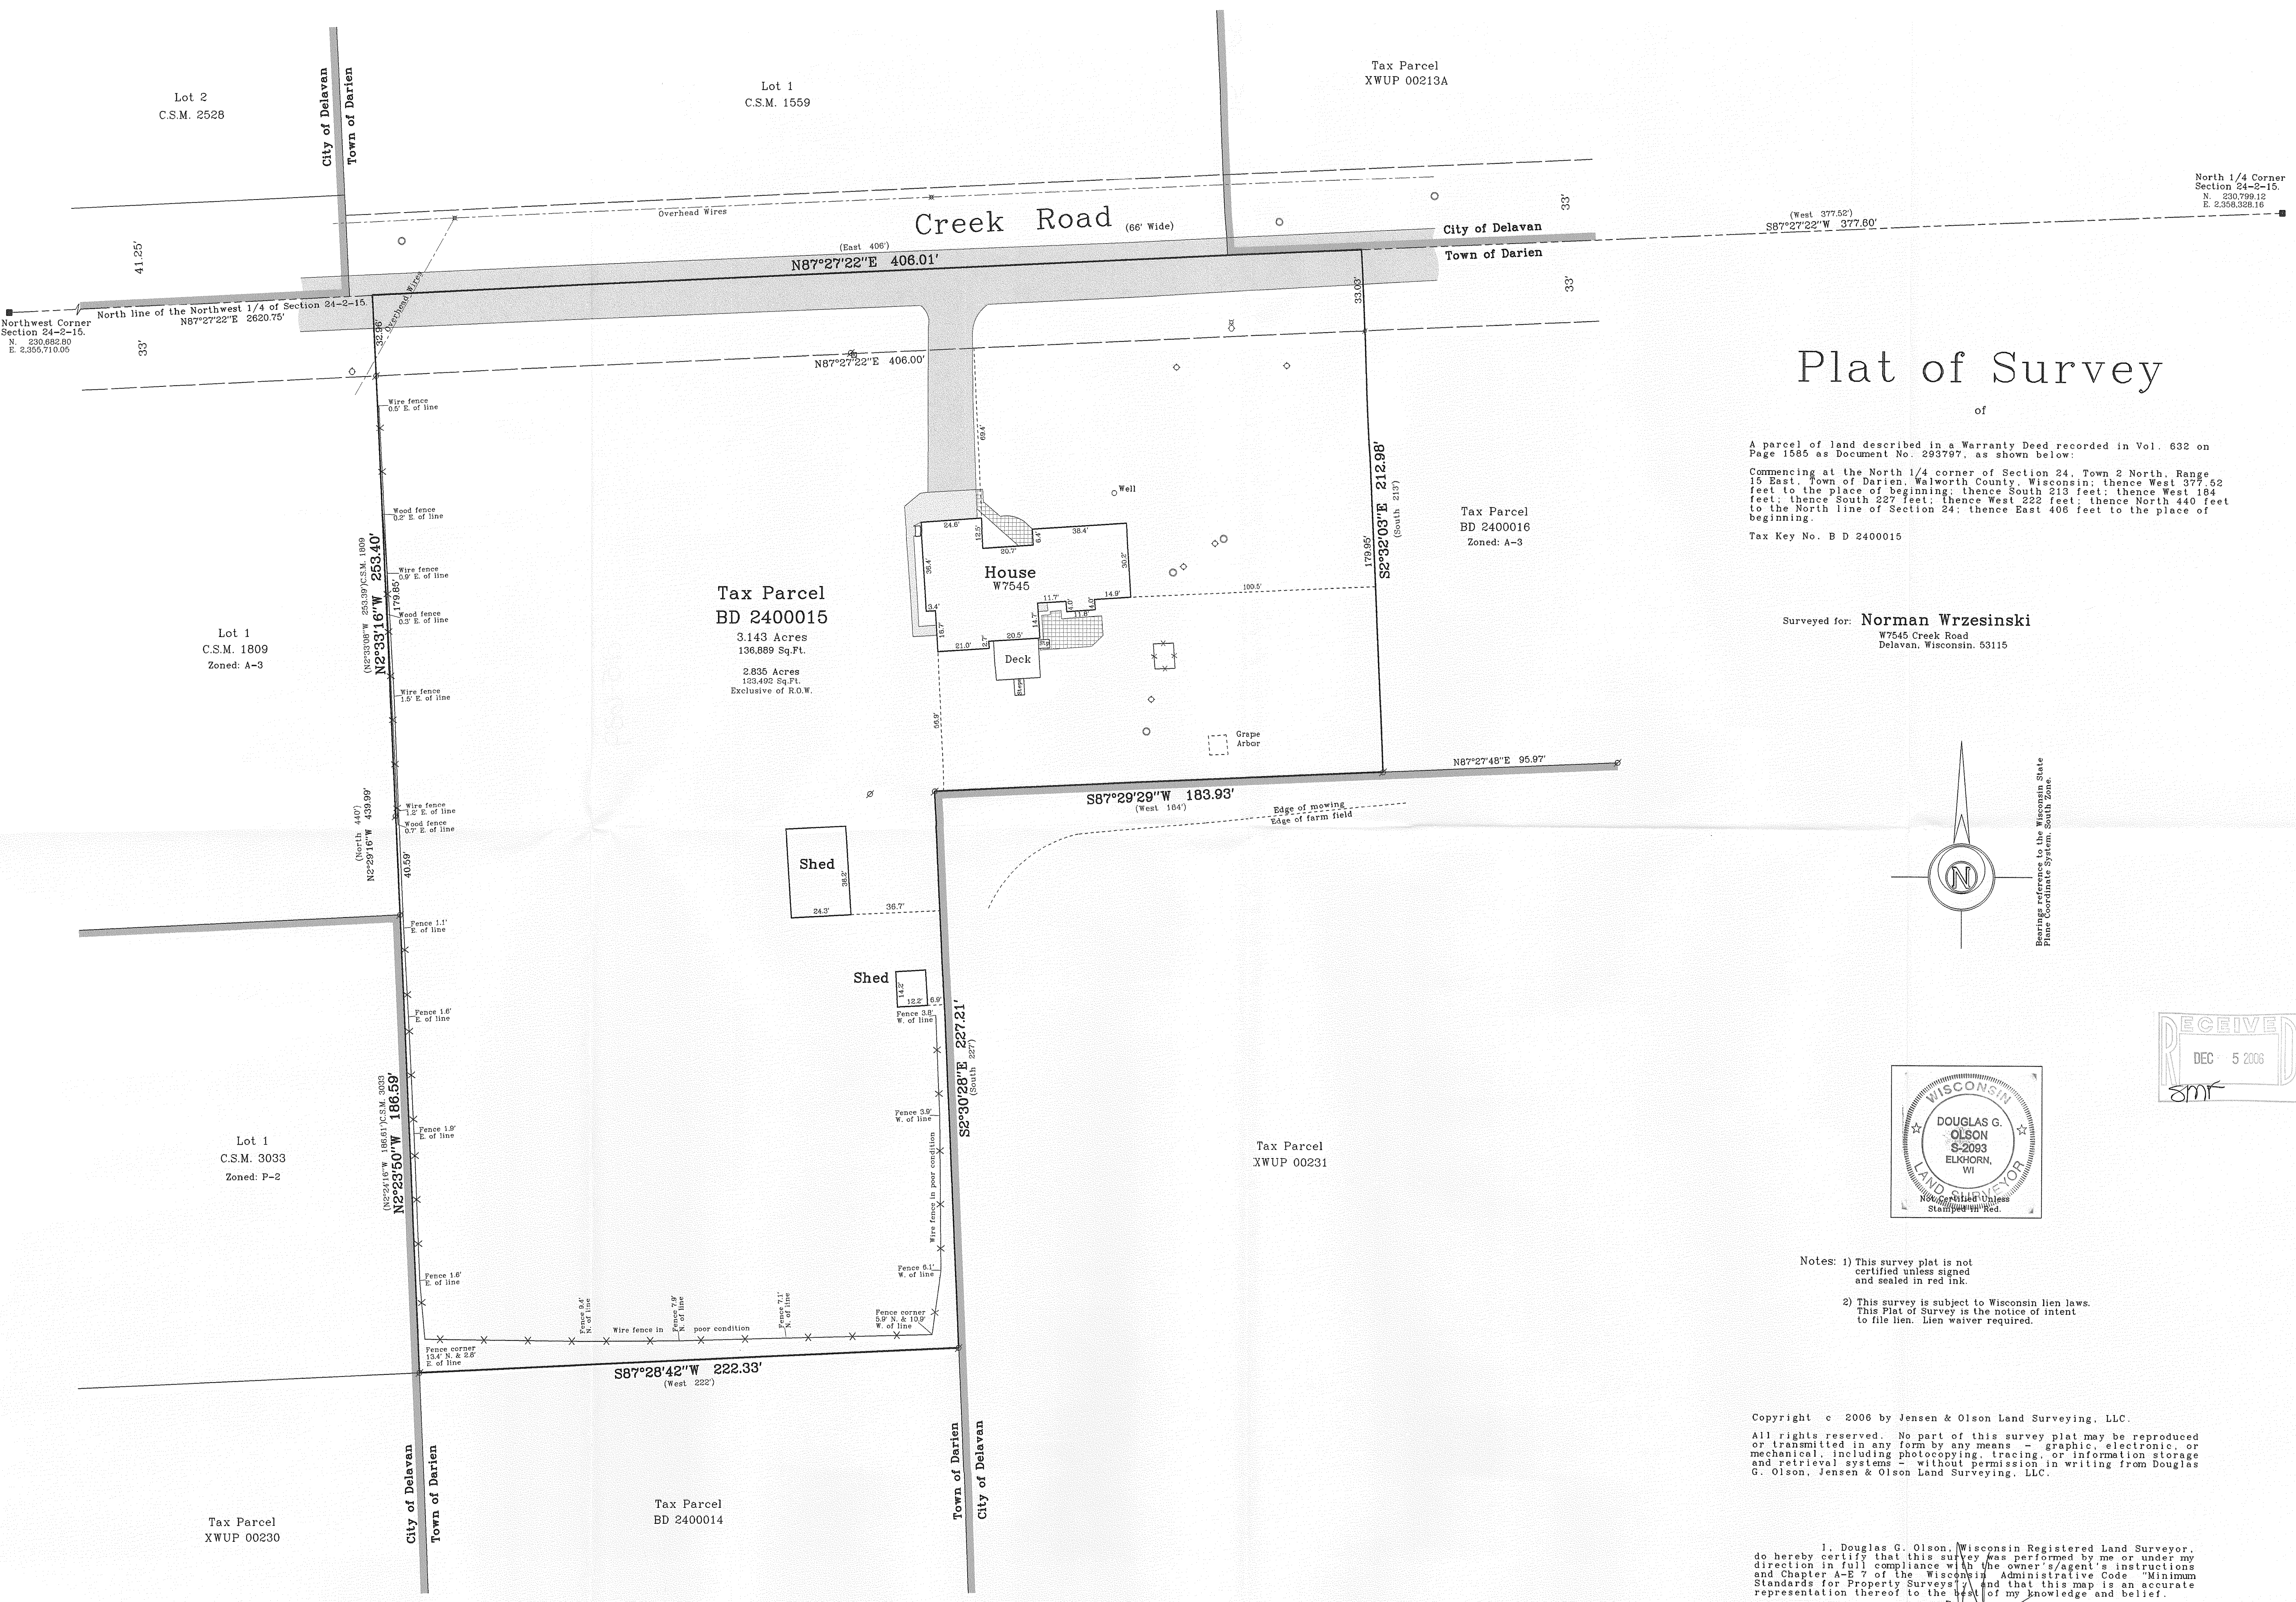


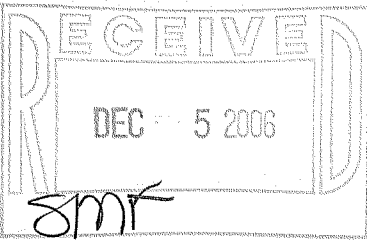

Plat of Survey

A parcel of land described in a Warranty Deed recorded in Vol. 632 on Page 1585 as Document No. 293797, as shown below:
Commencing at the North 1/4 corner of Section 24, Town 2 North, Range 15 East, Town of Darien, Walworth County, Wisconsin; thence West 377.52 feet to the place of beginning; thence South 213 feet; thence West 184 feet; thence South 227 feet; thence West 222 feet; thence North 440 feet to the North line of Section 24; thence East 406 feet to the place of beginning.
Tax Key No. B D 2400015

Surveyed for: Norman Wrzesinski
W7545 Creek Road
Delavan, Wisconsin. 53115

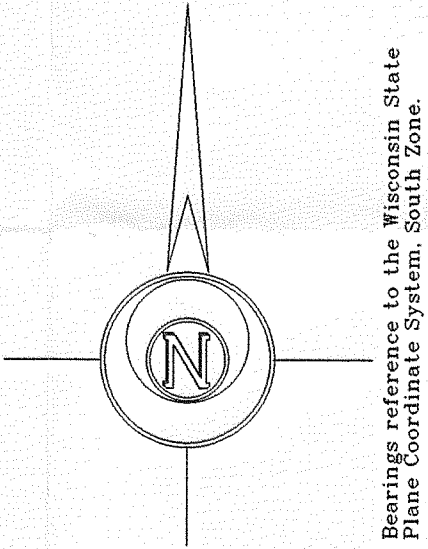


Notes: 1) This survey plat is not certified unless signed and sealed in red ink.
2) This survey is subject to Wisconsin lien laws. This Plat of Survey is the notice of intent to file lien. Lien waiver required.

Copyright © 2006 by Jensen & Olson Land Surveying, LLC.
All rights reserved. No part of this survey plat may be reproduced or transmitted in any form by any means - graphic, electronic, or mechanical, including photocopying, tracing, or information storage and retrieval systems - without permission in writing from Douglas G. Olson, Jensen & Olson Land Surveying, LLC.

I, Douglas G. Olson, Wisconsin Registered Land Surveyor, do hereby certify that this survey was performed by me or under my direction in full compliance with the owner's/agent's instructions and Chapter A-B 7 of the Wisconsin Administrative Code "Minimum Standards for Property Surveys" and that this map is an accurate representation thereof to the best of my knowledge and belief.

Douglas G. Olson
Wisconsin Registered Land Surveyor - 2093

Survey date: August 16, 2006.
Revisions:

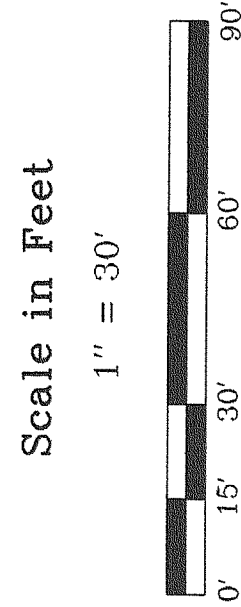

Jensen & Olson Land Surveying, LLC
45 South Wisconsin Street P.O. Box 322
Elkhorn, Wisconsin. 53121
Telephone: (262) 723-3434
Facsimile: (262) 723-8044

- Legend
- Found County Section Corner
 - Found Iron Pipe
 - Recorded Information
 - Utility Pedestal
 - Fire Hydrant
 - Water Valve
 - Septic Vent
 - Concrete Cover
 - Asphalt Surface
 - Concrete Surface
 - Brick Surface

Sheet 1 of 1 Sheets.
Job Reference Number
2006.089

2006.089