Copyright 2012 by Jensen & Olson Land Surveying, LLC.

All rights reserved. No part of this survey plat may be reproduced or transmitted in any form by any means - graphic, electronic, or mechanical, including photocopying, tracing, or information storage and retrieval systems - without permission in writing from Douglas G. Olson, Jensen & Olson Land Surveying, LLC.

I hereby certify that I have surveyed the above described property and the map hereon is correct to the best of my professional knowledge and belief and shows the size and location of the property, its exterior boundaries, the location and dimensions of all visible structures thereon, boundary fences, apparent easements and roadways and visible encroachments, if any.

This survey is made for the exclusive use of the present owners of the property, and also those who purchase, mortgage or guarantee title thereto, within one year from the date hereof.

Douglas G. Olson
Wisconsin Registered Land Surveyor - 2093

Plat of Survey

of

Tax Parcels BD 1700007A, BD 2000002A & BA394200002,

located in the Southwest 1/4 of Section 17 and the Northwest 1/4 and the Northeast 1/4 of Section 20, Town 2 North, Range 15 East, Town of Darien, Walworth County, Wisconsin.

Parcels of land described as PARCELS 2, 3 and 4 in a Warranty Deed recorded May 24, 2012 as Document No. 838793 as shown below:

PARCEL 2:

All that part of the Southeast Quarter of the Southwest Quarter of Section 17, T 2 N of R 15 E, Town of Darien, Walworth County, Wisconsin that lies South of the center of the road leading from Darien to Rock Prairie.

PARCEL 3:

Lot 2 of Certified Survey Map No. 3942, recorded May 31, 2006 in Volume 24 of Certified Surveys on pages 130-133 as Document No. 677965 and being a replatting of Lot 1 of Certified Survey Map No. 3657, recorded in Volume 21 of Certified Survey Maps of Walworth County on Page 342 and lands located in the Northwest 1/4 and the Southwest 1/4 of the Northeast 1/4 and the Southeast 1/4 and the Southwest 1/4 of the Northwest 1/4 of Section 20, Town 2 North, Range 15 East, Town of Darien, Walworth County, Wisconsin.

PARCEL 4:

All that part of the Northeast Quarter of the Northwest Quarter of Section 20, T 2 N of R 15 E, Town of Darien, Walworth County, Wisconsin that lies South of the road leading from Darien to Rock Prairie.

Also a parcel of land located Northwest 1/4 of the Northeast 1/4 of Section 20, T 2 N, R 15 E, Town of Darien, Walworth County, Wisconsin described as follows, to-wit: Beginning at the Southwest corner of said Northwest 1/4 of the Northeast 1/4; thence North along the west line of said Northwest 1/4 of the Northeast 1/4, 854.5 feet to the centerline of the public road; thence Southeasterly along the center line of said public road 593.9 feet to a point; thence Southwesterly along the line of a fence 695.5 feet to the place of beginning.

Surveyed for: **Dean Kincaid, Inc.**
N2028 Highway 106
Palmyra, Wisconsin. 53156

RECEIVED OCT - 1 2012 By SMK

WISCONSIN DOUGLAS OLSON S-2093 ELKHORN, WI LAND SURVEYOR
Not Certified Unless Stamped in Red.

Notes:

1) This survey plat is not certified unless signed and sealed in red ink.
2) This survey is subject to Wisconsin lien laws. This Plat of Survey is the notice of intent to file lien. Lien waiver required.

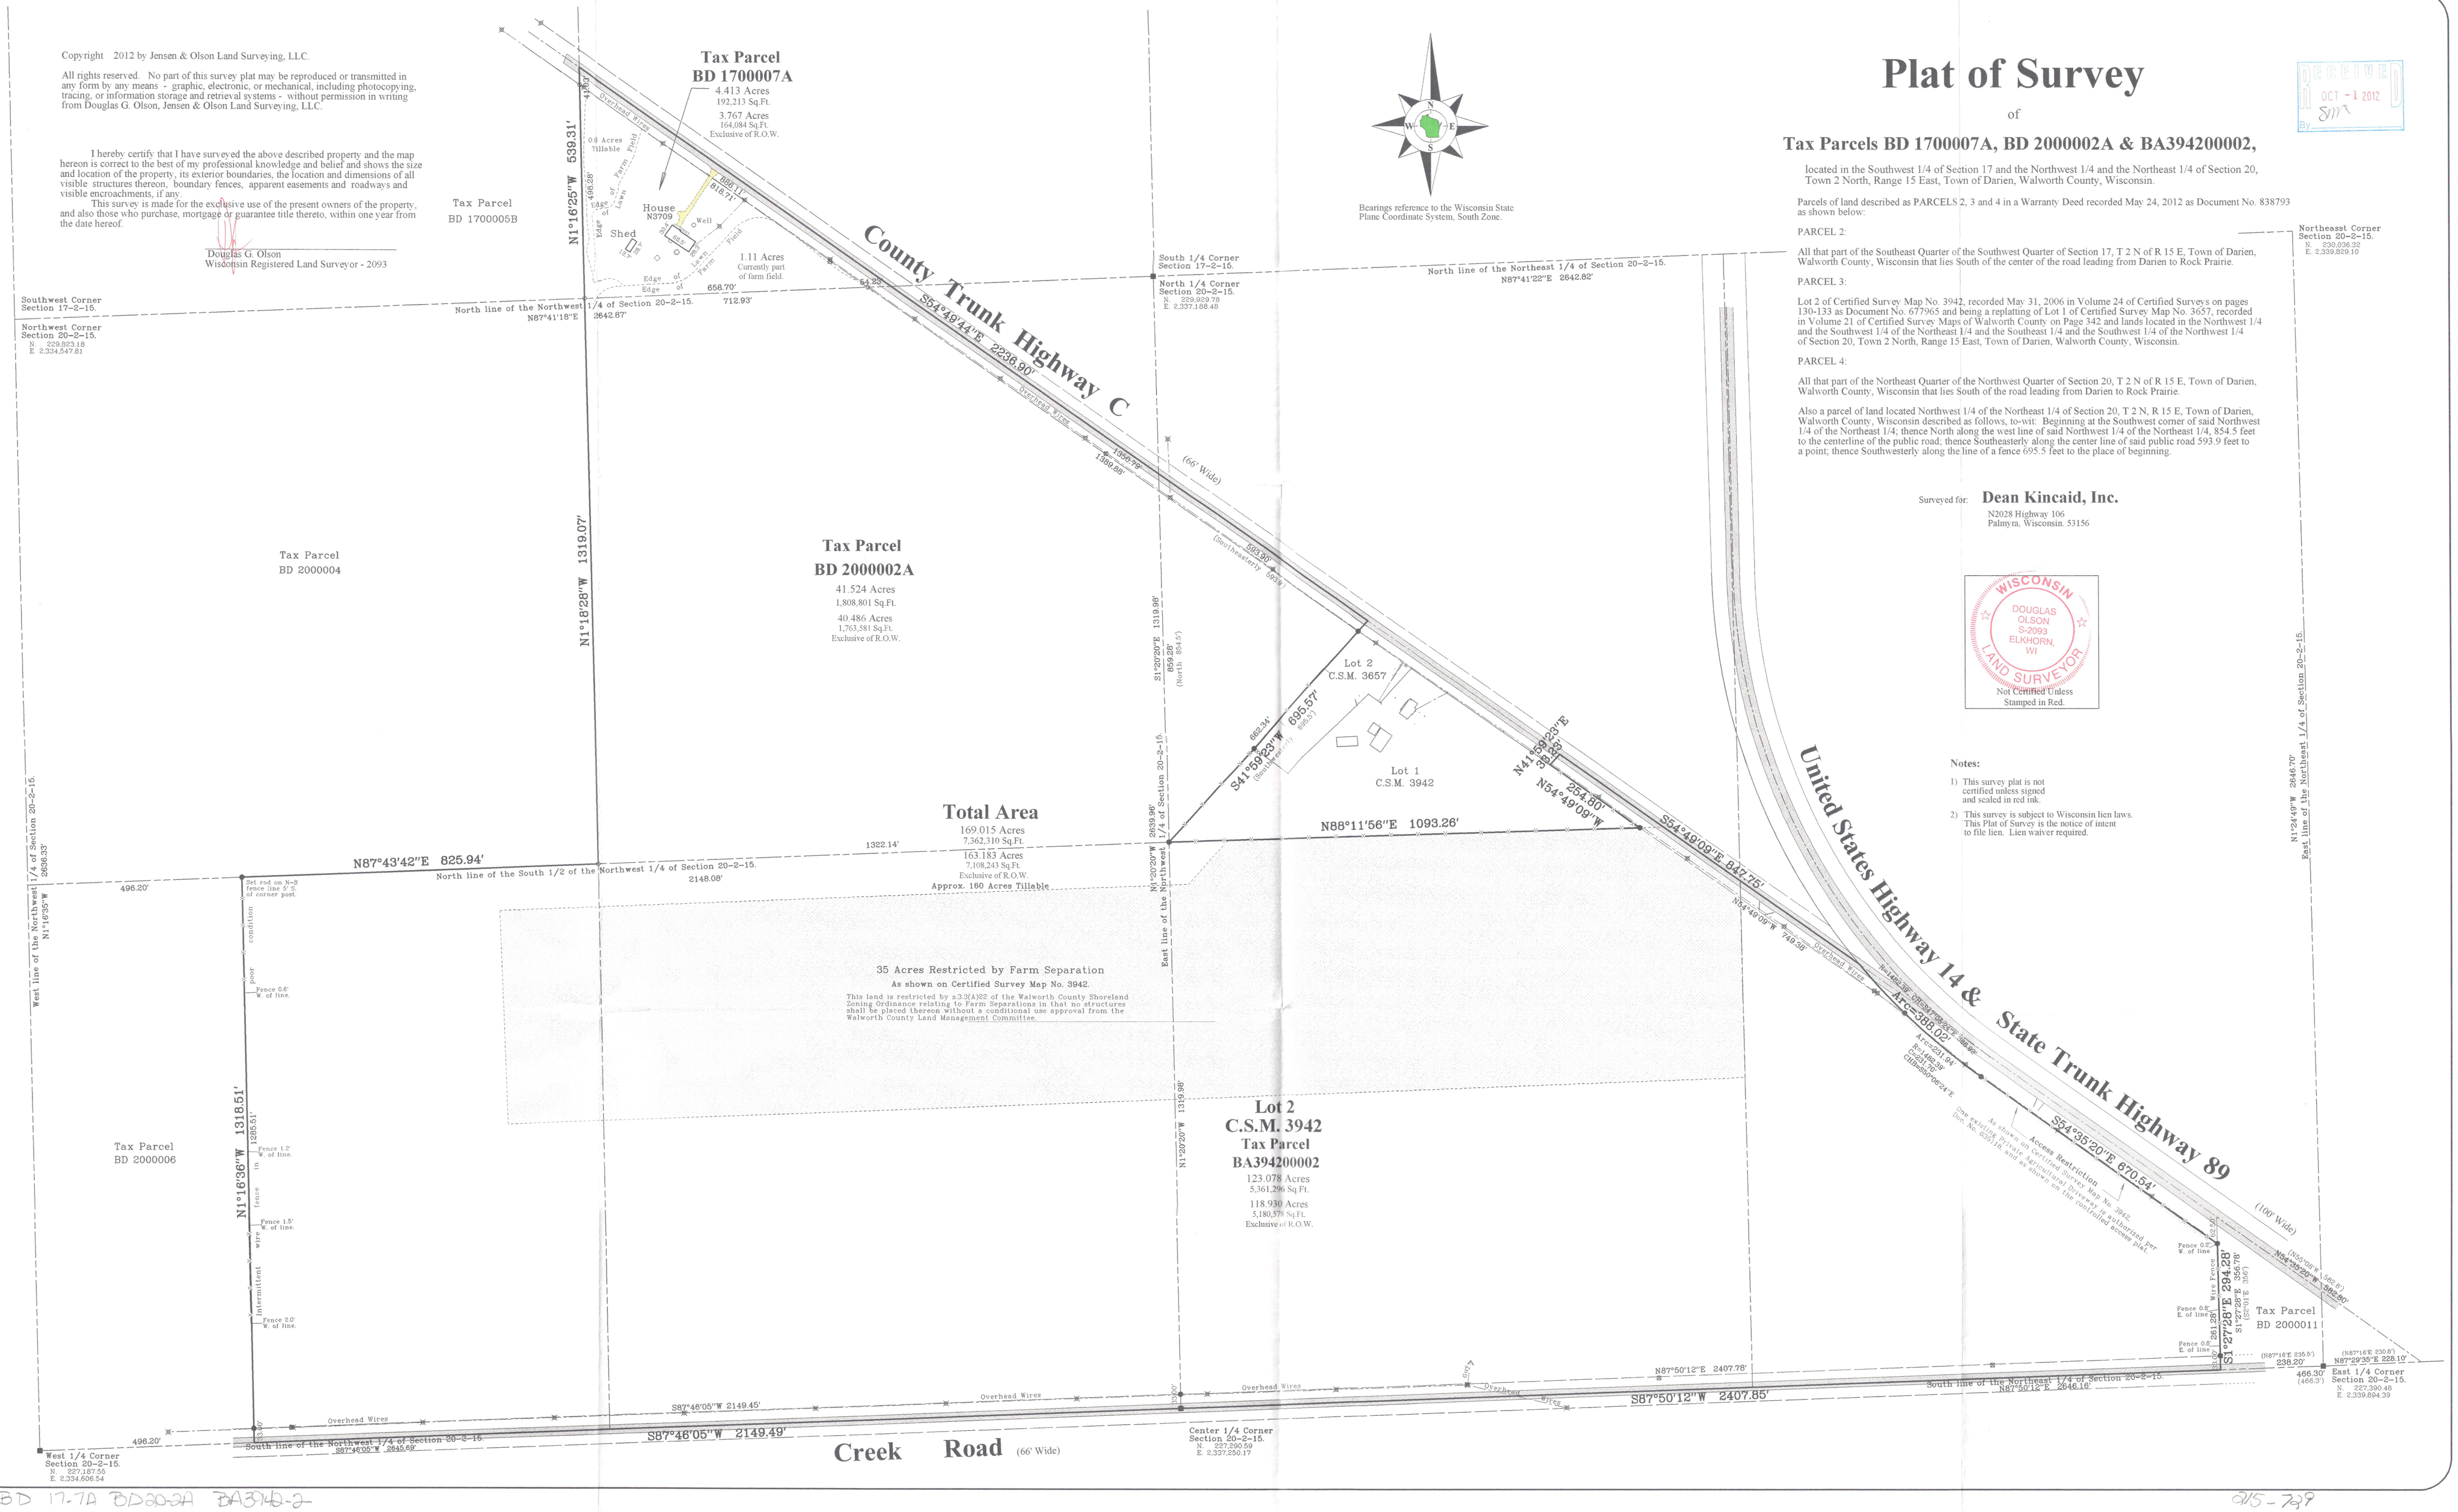

Survey date: August 16, 2012.
Revisions:

Scale in Feet
1" = 150'
0' 75' 150' 300' 450'

Jensen & Olson Land Surveying, LLC
45 South Wisconsin Street * P.O. Box 322 * Elkhorn, Wisconsin. 53121
Telephone: (262) 723-3434 * Facsimile: (262) 723-8044
Email: jensen.olson@elknet.net

Legend
- Found County Section Corner
- Found Iron Pipe, 1" dia.
- Set Iron Pipe, 1" dia.
- Utility Pole
- Utility Pedestal
- Concrete Cover
- Asphalt Surface
- Concrete Surface
- Gravel Surface

Sheet 1 of 1 Sheets

Drawing Name: (Zn15c-2012090-2012090Plat.sv)

Job Reference Number
2012.090

2012.090

BD 17-7A BD2002A BA394200-2

015-798