# Plat of Survey


of

## A Portion of Lot 3 of Westwood,


a subdivision located in the Southeast 1/4 of Section 11 and the Northeast 1/4 of Section 14, Town 2 North, Range 15 East, Town of Darien, Walworth County, Wisconsin.

Surveyed for: **Phil Lindloff**
N4092 Westwood Drive
Delavan, Wisconsin. 53115

Tax Parcel

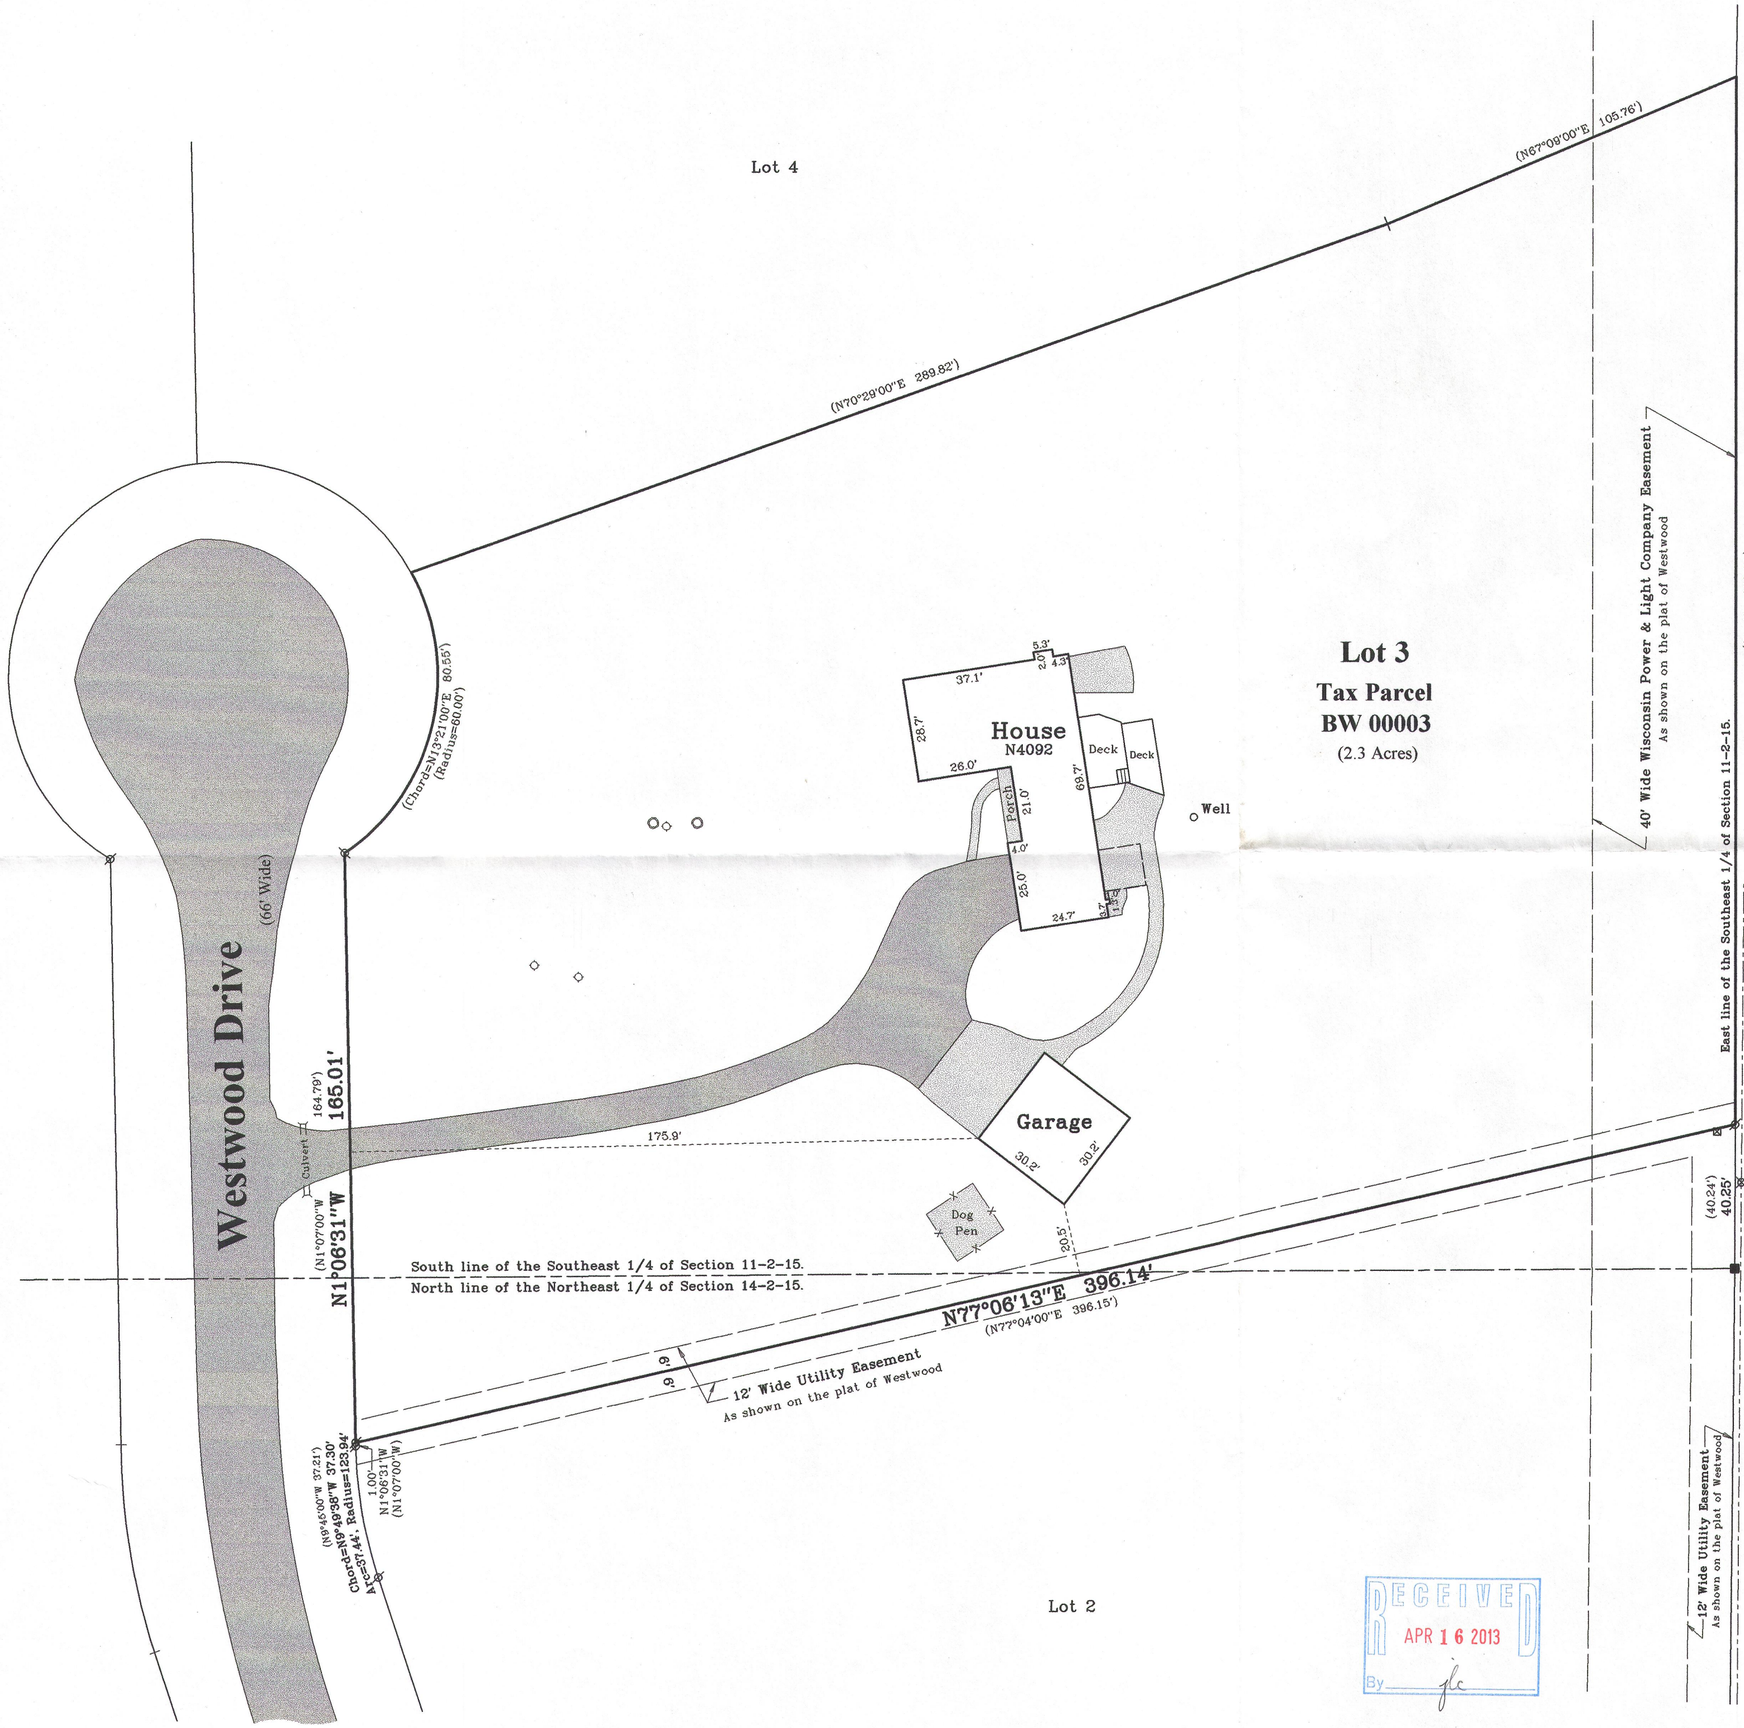


RECEIVED
APR 16 2013
By

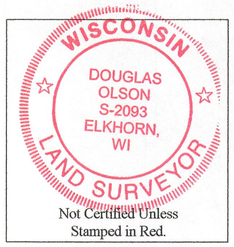


Not Certified Unless Stamped in Red.

**Notes:**

1) This survey plat is not certified unless signed and sealed in red ink.
2) This survey is subject to Wisconsin lien laws. This Plat of Survey is the notice of intent to file lien. Lien waiver required.

Copyright 2012 by Jensen & Olson Land Surveying, LLC.

All rights reserved. No part of this survey plat may be reproduced or transmitted in any form by any means - graphic, electronic, or mechanical, including photocopying, tracing, or information storage and retrieval systems - without permission in writing from Douglas G. Olson, Jensen & Olson Land Surveying, LLC.

I, Douglas G. Olson, Wisconsin Registered Land Surveyor, do hereby certify that this survey was performed by me, or under my direction in full compliance with the owner's/agent's instructions and Chapter A-E 7 of the Wisconsin Administrative Code "Minimum Standards for Property Surveys"; and that this map is an accurate representation thereof to the best of my knowledge and belief.

Douglas G. Olson
Wisconsin Registered Land Surveyor - 2093

**Survey Date:** December 14, 2012.
Revisions:

**Scale in Feet**
**1" = 30'**
0' 15' 30' 60'

**Jensen & Olson Land Surveying, LLC**
45 South Wisconsin Street * P.O. Box 322 * Elkhorn, Wisconsin. 53121
Telephone: (262) 723-3434 * Facsimile: (262) 723-8044
Email: jensen.olson@elknet.net

**Legend**
- Found County Section Corner
- Found Iron Pipe
- Recorded Information
- Utility Pole
- Utility Pedestal
- Concrete Cover
- Soil/Earth
- Asphalt Surface
- Concrete

Sheet 1 of 1 Sheets
Drawing Name: I:\2arl15e-2012\31-2012\31Plat.dgn
Job Reference Number
2012.131

2012.131

BW 00003 215-738