

LAND-MARK SURVEYING

Mark L. Miritz


Wisconsin Professional Land Surveyor S-2582

N9330 Knuteson Drive  
Whitewater, WI 53190  
Phone: (262) 495-3284  
MARKMIRITZ@  
LAND-MARKSURVEYING.COM

PLAT OF SURVEY

LOT 2 OF SUNSET HILLS ESTATES SUBDIVISION, LOCATED IN THE NORTHEAST 1/4  
OF THE NORTHEAST 1/4 OF SECTION 22, TOWN 2 NORTH, RANGE 15 EAST, DARIEN  
TOWNSHIP, WALWORTH COUNTY, WISCONSIN.

OWNERS: JAMES R. HERTEL  
KERRY L. HERTEL  
N3659 OAK HILL ST.  
DELAVAN, WI 53115

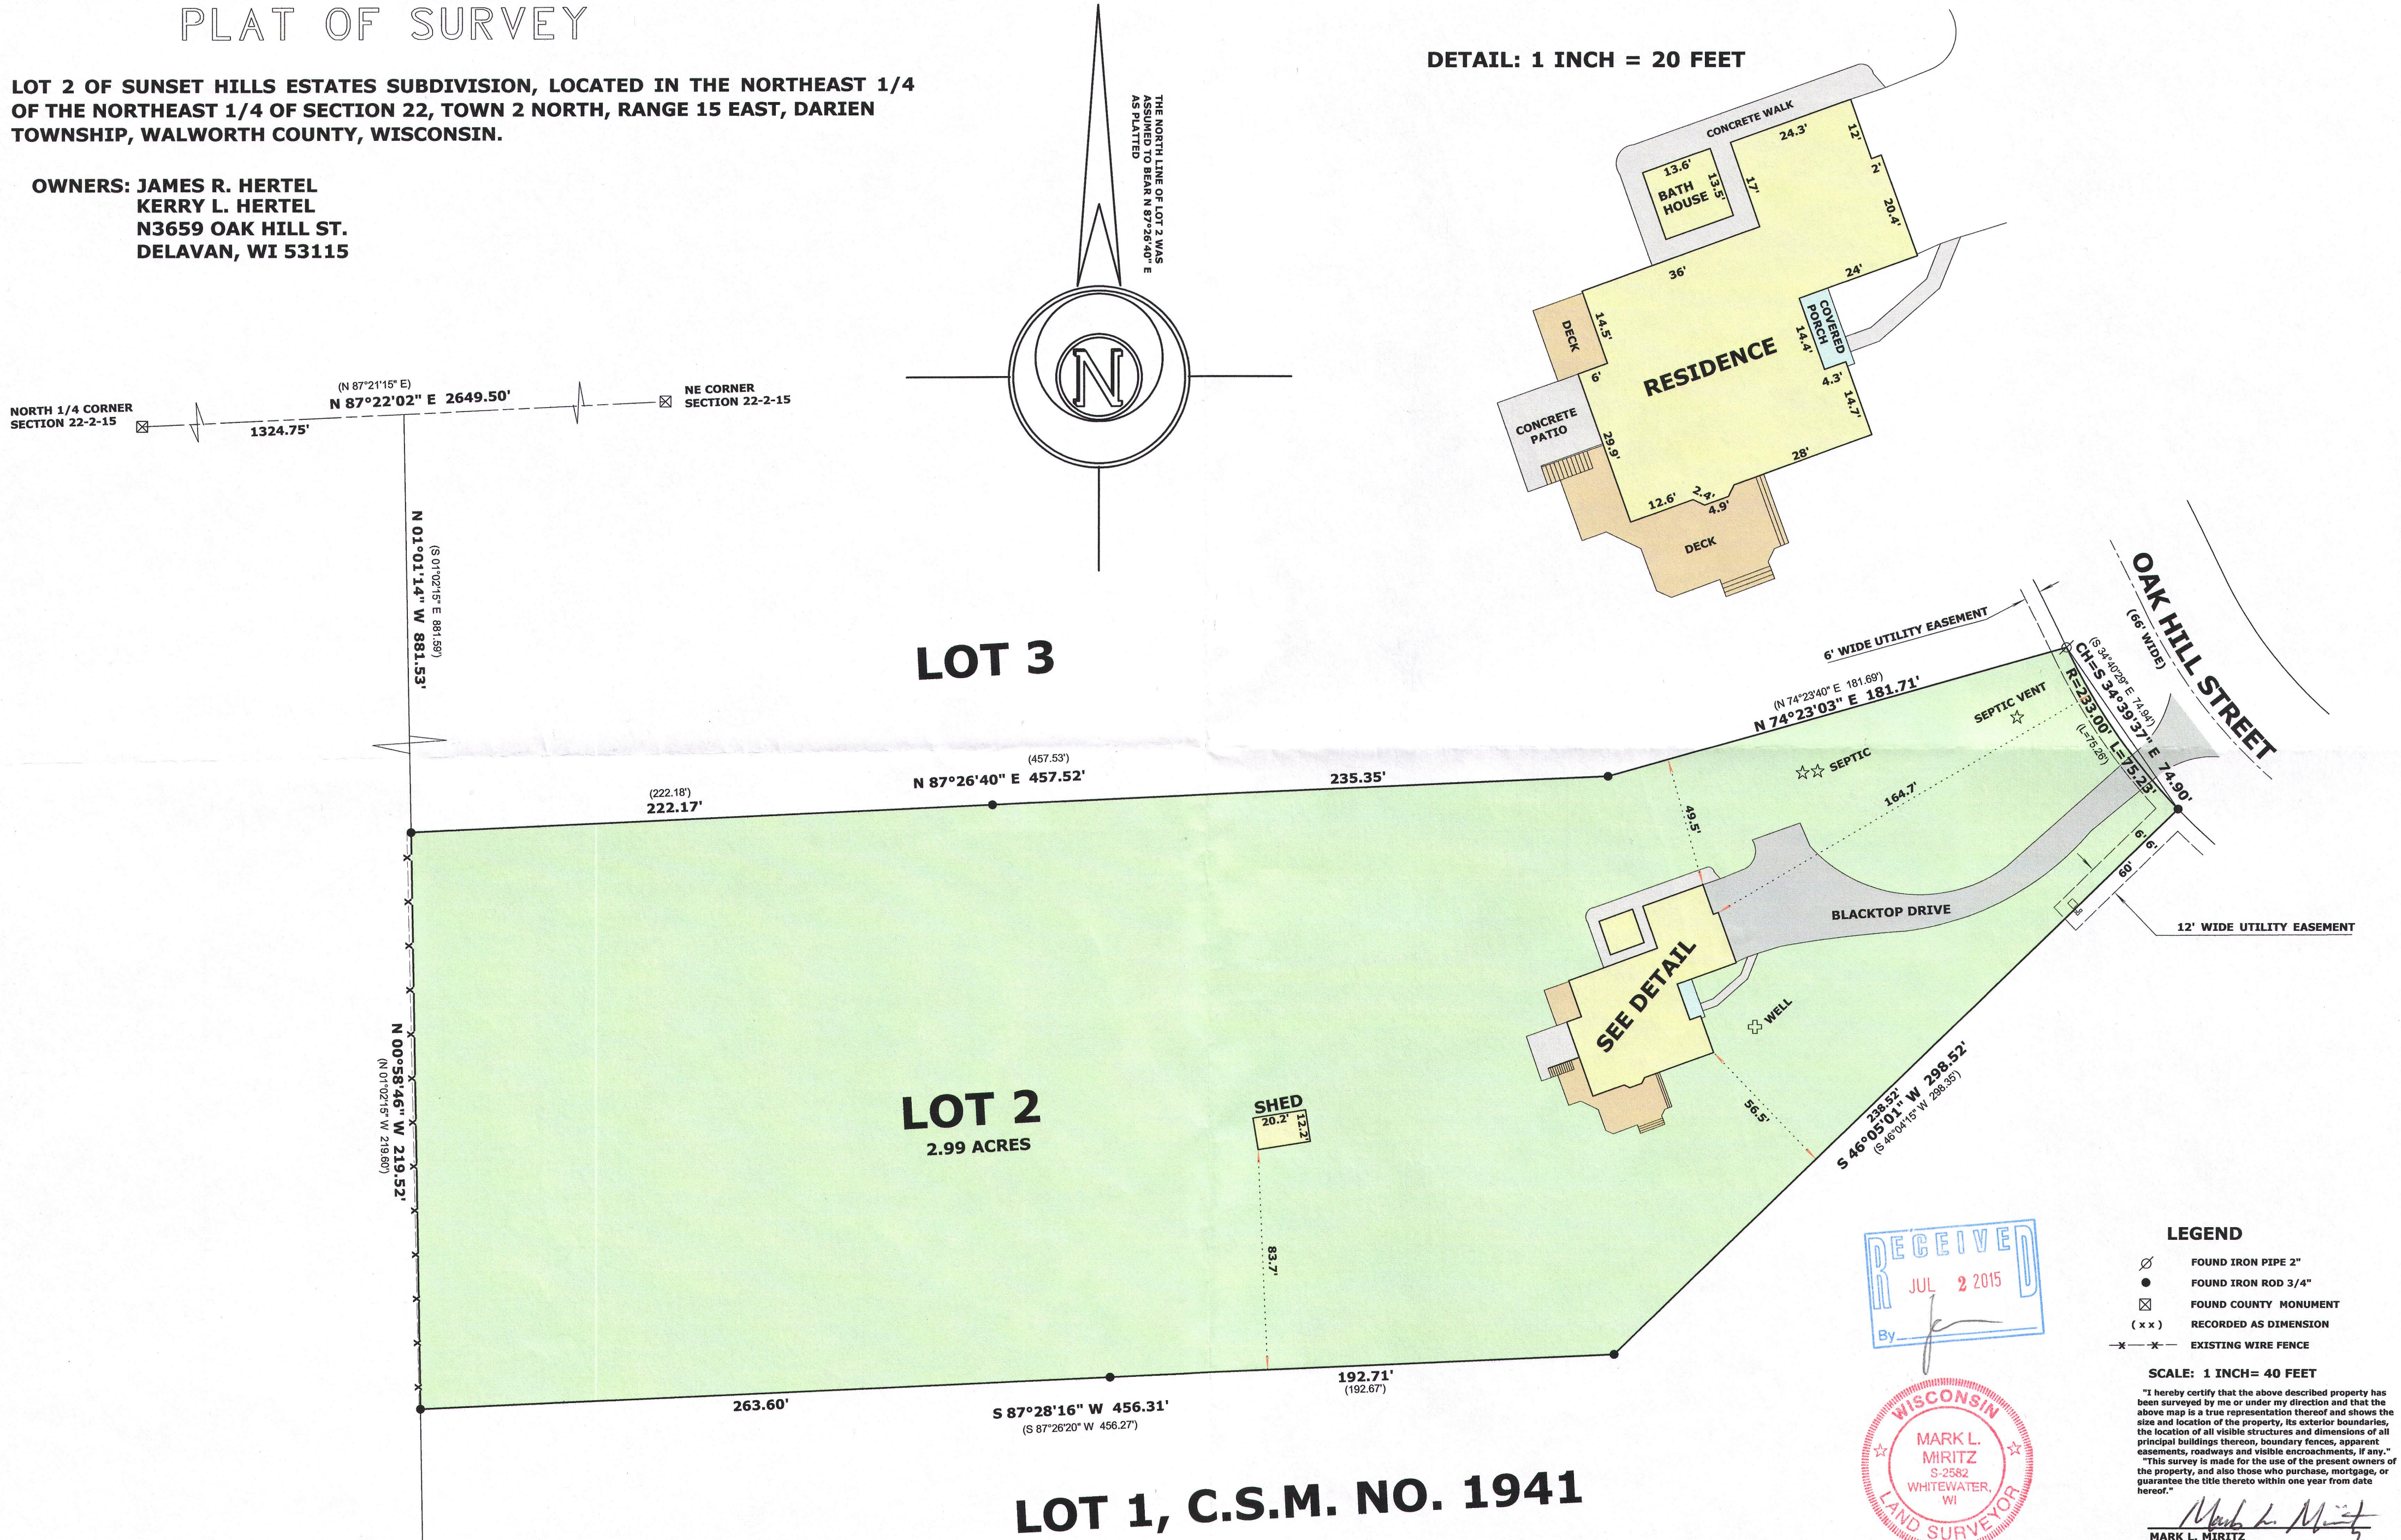

**LEGEND**

- FOUND IRON PIPE 2"
- FOUND IRON ROD 3/4"
- FOUND COUNTY MONUMENT
- RECORDED AS DIMENSION
- EXISTING WIRE FENCE

**SCALE: 1 INCH= 40 FEET**

"I hereby certify that the above described property has been surveyed by me or under my direction and that the above map is a true representation thereof and shows the size and location of the property, its exterior boundaries, the location of all visible structures and dimensions of all principal buildings thereon, boundary fences, apparent easements, roadways and visible encroachments, if any."

"This survey is made for the use of the present owners of the property, and also those who purchase, mortgage, or guarantee the title thereto within one year from date hereof."

*Mark L. Miritz*  
MARK L. MIRITZ  
WISCONSIN PROFESSIONAL  
LAND SURVEYOR S-2582

DATE: MAY 25, 2015      JOB NO. 15.507

B&L-2 215-762