


PLAT OF SURVEY

LOT 1 OF KENNEY WOOD SUBDIVISION

LOCATED IN PART OF THE NE 1/4, SW 1/4, & SE 1/4 OF THE SE 1/4 OF SECTION 9,
AND PART OF THE NW 1/4 & SW 1/4 OF THE SW 1/4 OF SECTION 10, ALL IN
TOWN 2 NORTH, RANGE 15 EAST, WALWORTH COUNTY, WISCONSIN

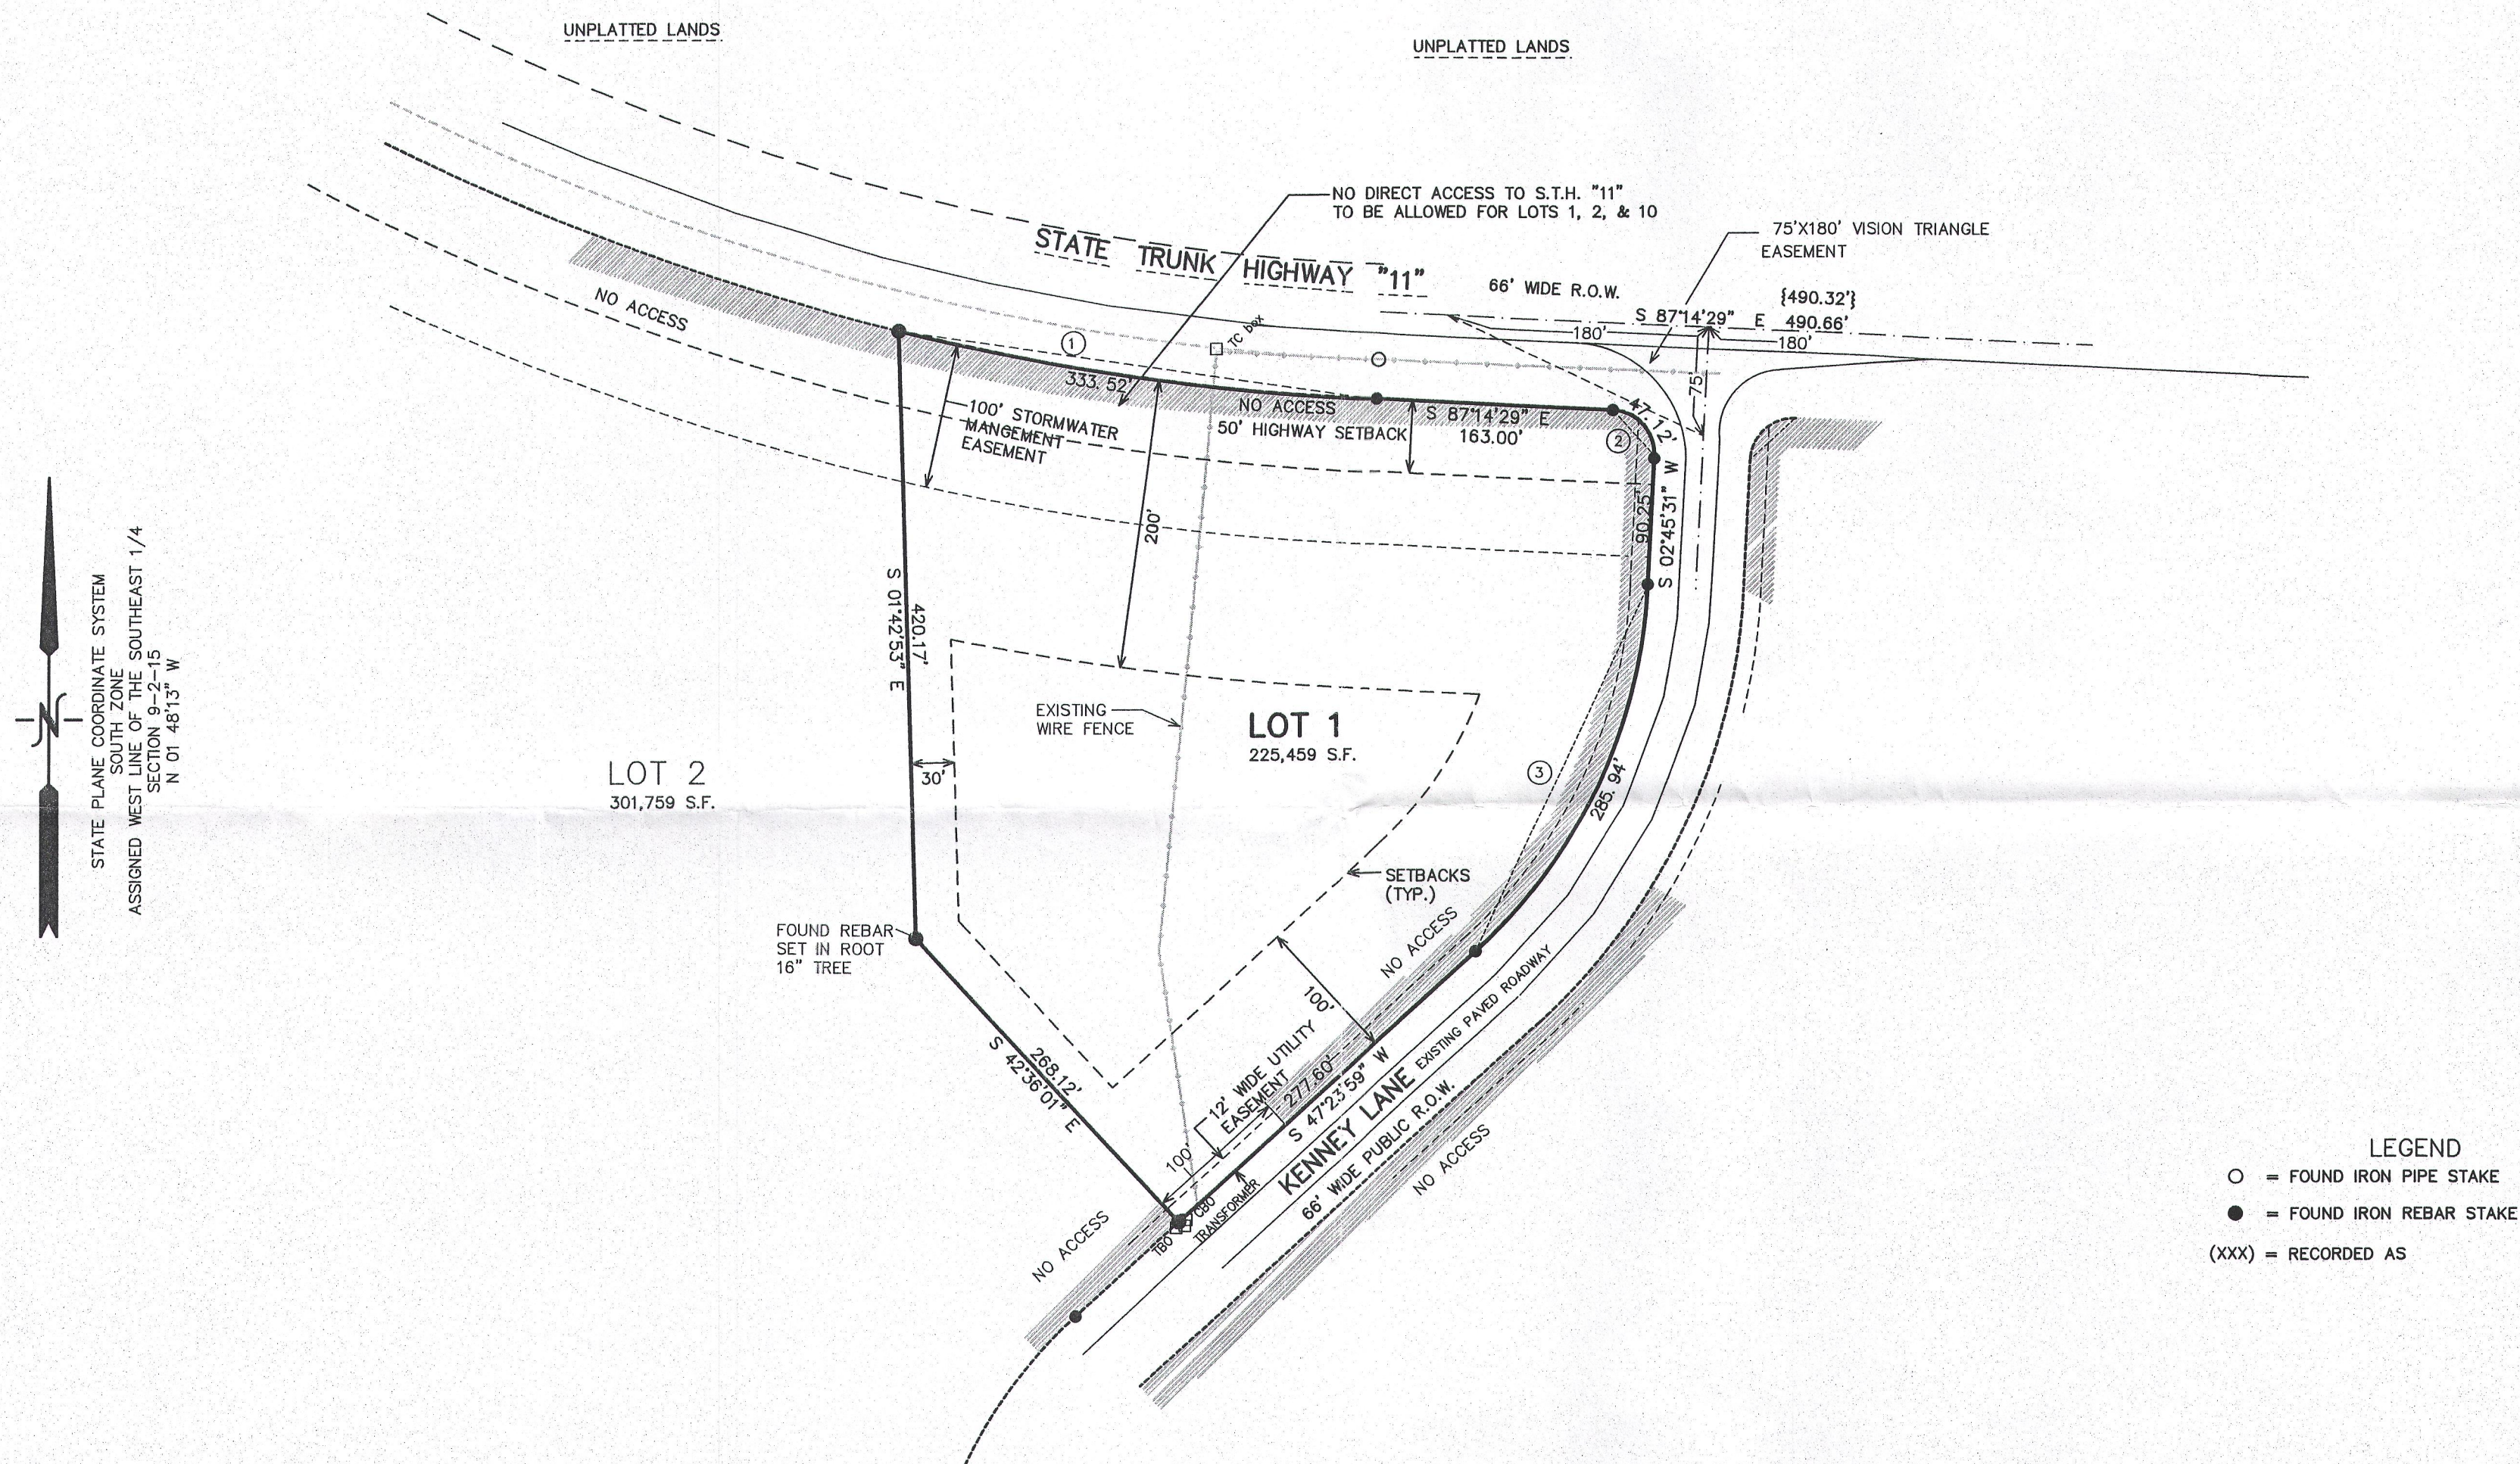


STATE PLANE COORDINATE SYSTEM
SOUTH ZONE
ASSIGNED WEST LINE OF THE SOUTHEAST 1/4
SECTION 9-2-15
N 01° 46'13" W

LEGEND
○ = FOUND IRON PIPE STAKE
● = FOUND IRON REBAR STAKE
(XXX) = RECORDED AS

CURVE DATA TABLE

CURVE #	RADIUS	CENT. ANG.	CHORD BRG	CHORD DIST	ARC
C-1	1697.00	11-15-38.0	S 81-47-21.0 E	332.98	333.52
C-2	30.00	90-00-00.0	S 42-14-29.0 E	42.43	47.12
C-3	367.00	44-38-28.0	S 25-04-45.0 W	278.76	285.94


100 50 0 100 200 300 400
MAP SCALE IN FEET ORIGINAL 1"= 100'

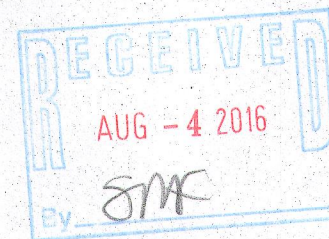


NOTE: COPIES OF THIS MAP TO WHICH THE FOLLOWING CERTIFICATE
WILL APPLY SHOW THE SURVEYOR'S ORIGINAL SEAL AND SIGNATURE
IN RED INK. COPIES BY ANY OTHER MEANS MAY HAVE ALTERATIONS
WHICH DO NOT REPRESENT THE SURVEYOR'S WORK PRODUCT.

I HEREBY CERTIFY THAT THE ABOVE DESCRIBED PROPERTY HAS BEEN
SURVEYED UNDER MY DIRECTION AND THAT THE ABOVE MAP IS A TRUE
REPRESENTATION THEREOF AND SHOWS THE SIZE AND LOCATION OF
THE PROPERTY AND ITS EXTERIOR BOUNDARIES. THIS SURVEY IS
MADE FOR THE USE OF THE PRESENT OWNERS OF THE PROPERTY, AND
ALSO THOSE WHO PURCHASE, MORTGAGE, OR GUARANTEE THE TITLE
THERETO WITHIN ONE YEAR FROM THE DATE HEREOF.

DATED: MAY 6, 2016

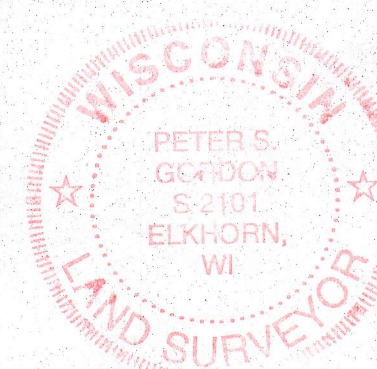

PETER S. GORDON R.L.S. 2101

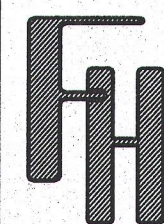

WORK ORDERED BY -
DAN OLESTON
751 GENEVA PARKWAY NORTH
LAKE GENEVA, WI. 53147

FARRIS, HANSEN & ASSOCIATES, INC.
ENGINEERING - ARCHITECTURE - SURVEYING
7 RIDGWAY COURT P.O. BOX 437
ELKHORN, WISCONSIN 53121
OFFICE: (262) 723-2098 FAX: (262) 723-5886

REVISIONS

PROJECT NO.
6453.01

DATE:
05-06-2016

SHEET NO.
1 OF 1

DKEN-1

015-781