



PLAT OF SURVEY

PARCEL 1
Outlot 1 of Certified Survey Map No. 3660 as recorded in Volume 22 of
Certified Surveys on page 1 as Document No. 593454, Town of Darien,
Walworth County Wisconsin.

PARCEL 2
That portion of the North Half of the Northeast Quarter of Section 24,
Town 2 North, Range 14 East, Town of Bradford, Rock County,
Wisconsin, described as follows: Beginning at the Northeast corner of
Section 24 aforesaid; running thence South 2 degrees East, along the
East line of said Section, 1278.8 feet to a point 42.0 feet North of the
Southeast Quarter of the Northeast Quarter of said Section 24; thence
North 89 degrees 35 minutes West, 1337.3 feet to a fence line running
North, said fence corner being 18.0 feet West and 49.0 feet North of
the Southwest corner of the Northeast Quarter of the Northeast Quarter
of said Section 24; thence North 1 degrees 38 minutes West, along the
fence line running North 1269.8 feet to the North line of said Section
24, at a point 11.0 feet West of the Northwest corner of the Northeast
Quarter of the Northeast Quarter of said Section 24; thence East along
the North line of said Section 1328.7 feet to the Place of Beginning.

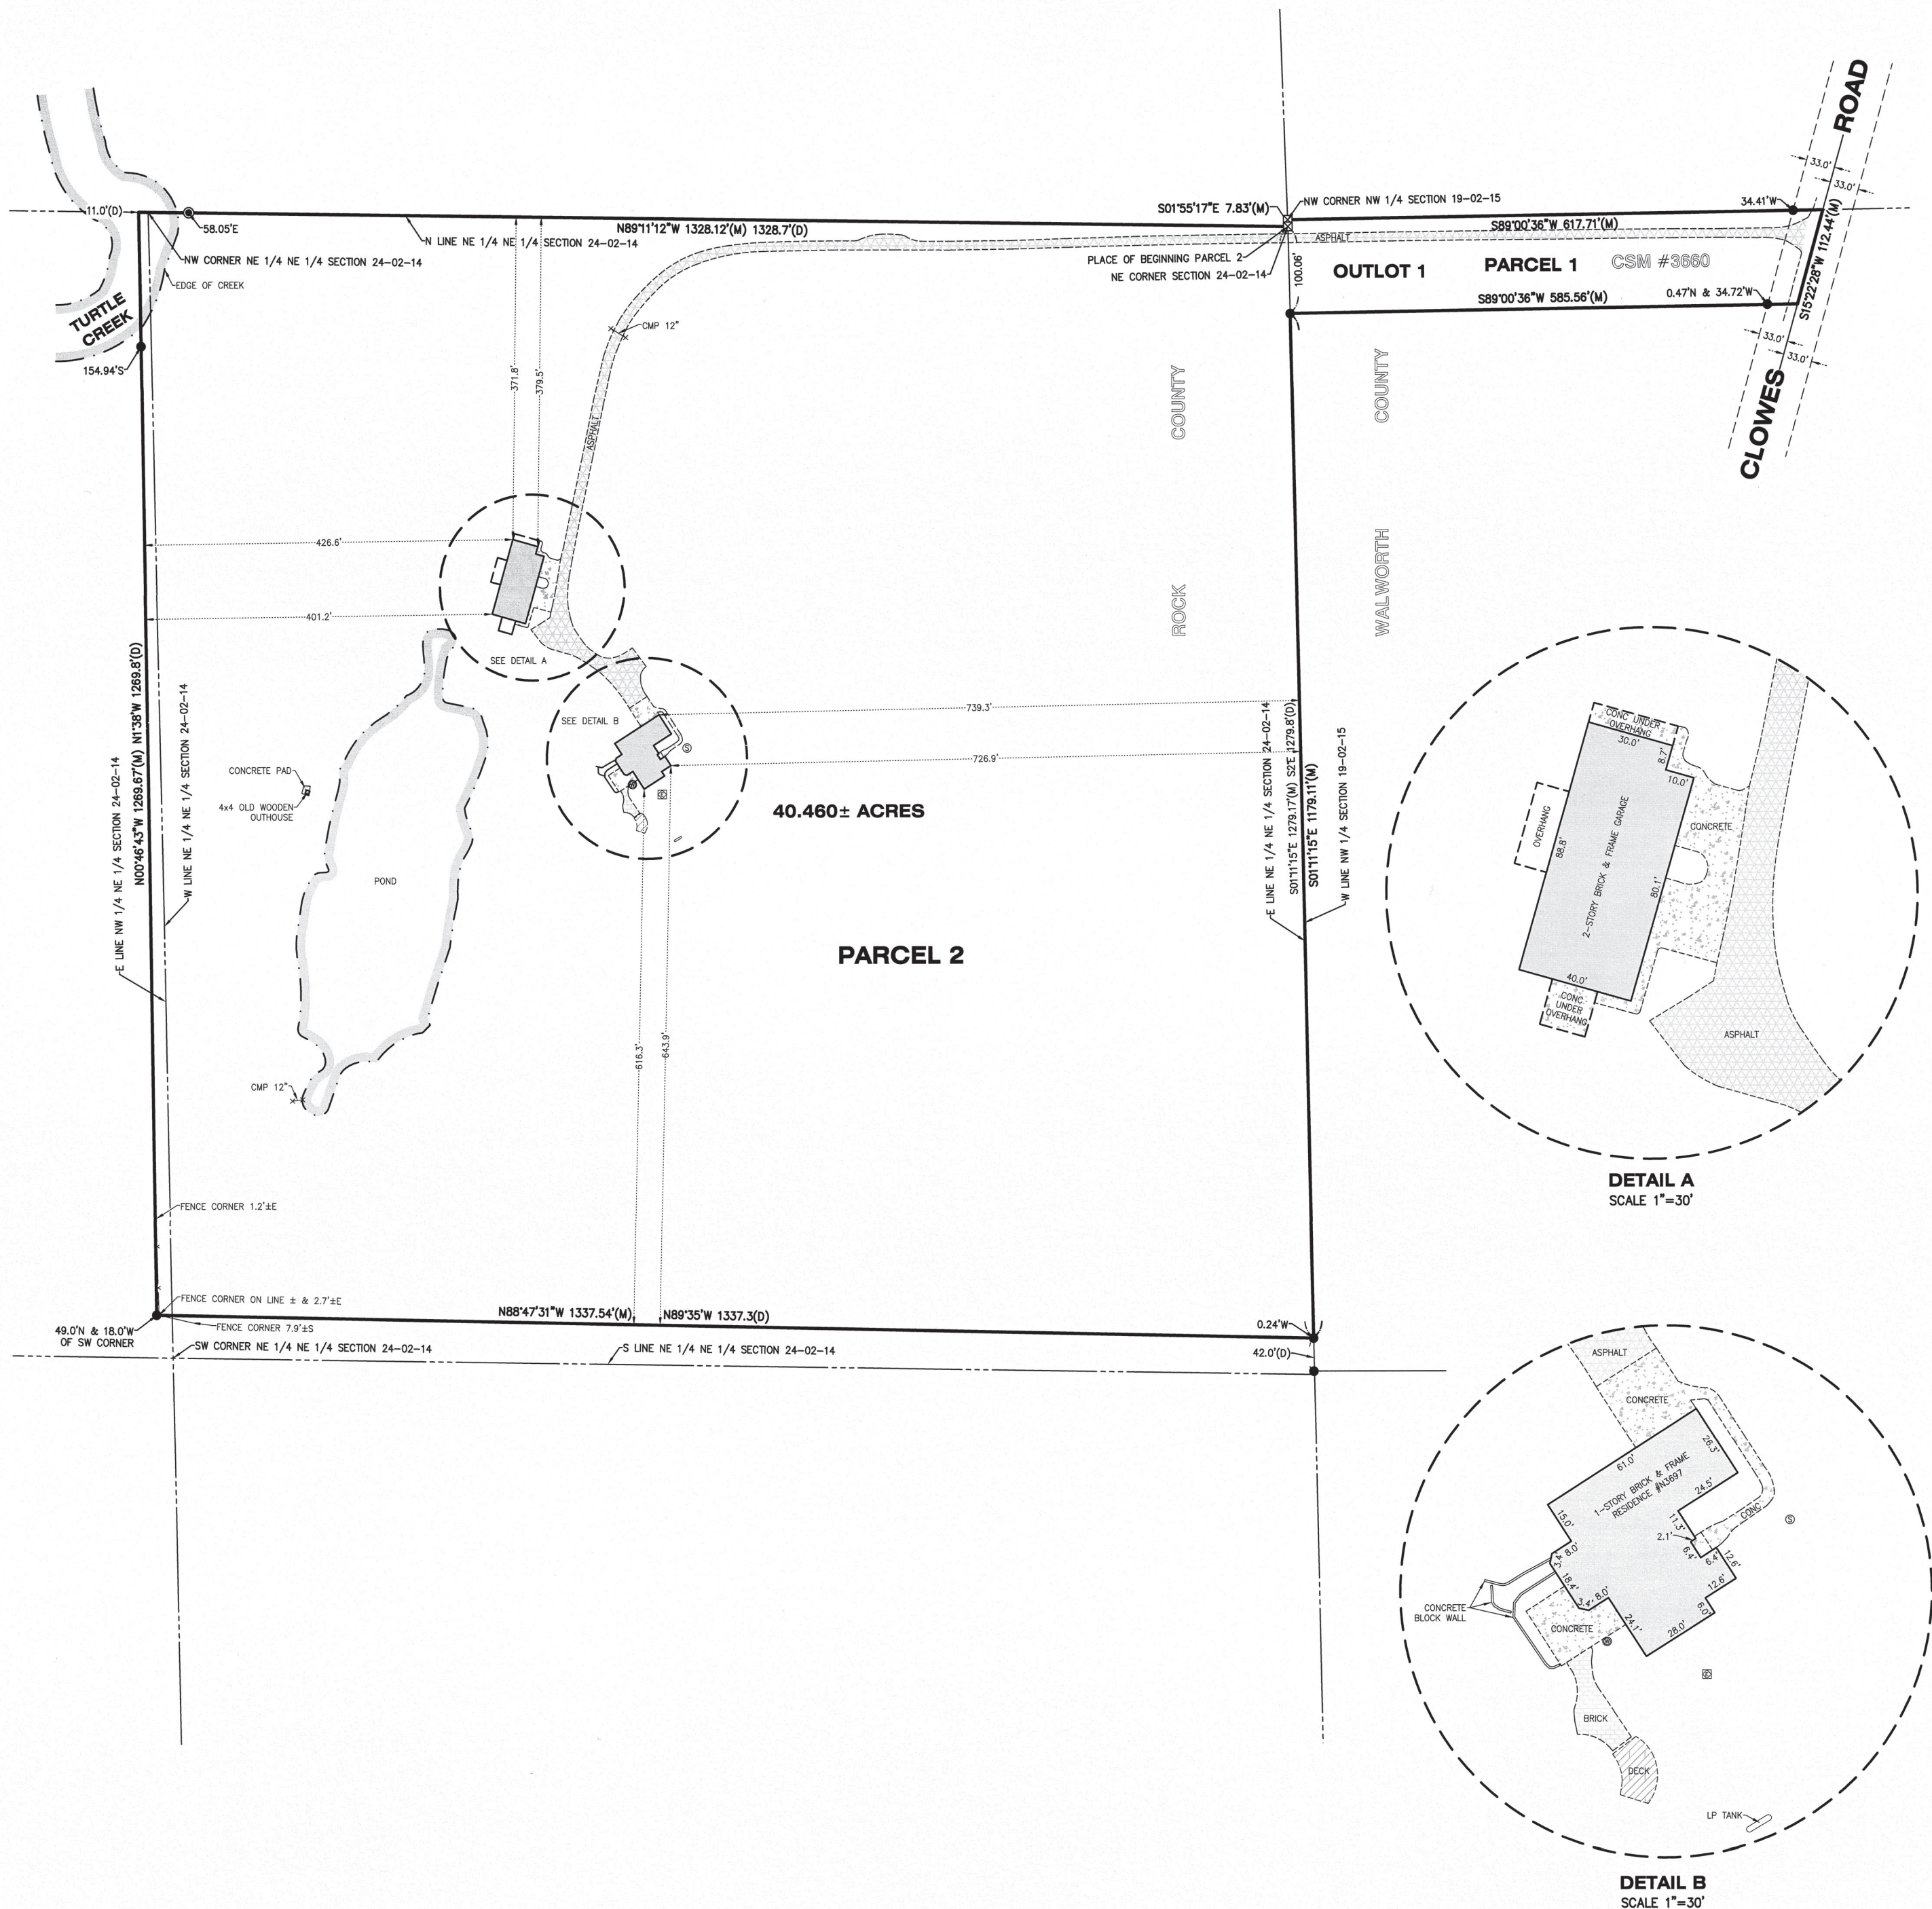

LEGEND	
●	FOUND IRON BAR
○	FOUND IRON PIPE
⊠	FOUND MONUMENT
⊙	SEPTIC LID
⊗	SET IRON BAR
⊞	TRANSFORMER
⊕	WELL
(M)	MEASURED
(D)	DEED

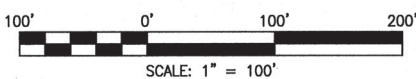

SURVEY COMPLETED WITH OVER 6" OF SNOW COVER. SOME GROUND
IMPROVEMENTS MAY NOT HAVE BEEN VISIBLE & SURVEYED AT THIS TIME.

NOTE: Only those Building Line Restrictions or Easements shown on a Recorded Subdivision Plat are shown hereon unless the
description ordered to be surveyed contains a proper description of the required building lines or easements.
* No distance should be assumed by scaling.
* No underground improvements have been located unless shown and noted.
* No representation as to ownership, use, or possession should be hereon implied.
* This Survey and Plat of Survey are void without original embossed or colored seal and signature affixed.

Compare your description and site markings with this plat and AT ONCE report any discrepancies which you may find.

STATE OF ILLINOIS)
COUNTY OF McHENRY) S.S.

In my professional opinion, and based on my observations, I hereby certify
that the above described property has been surveyed under my direction
and that the above map is a true representation thereof and shows the
size and location of all visible structures, and dimensions of all principle
buildings thereon, boundary fences, apparent easements, roadways, and
visible encroachments, if any. This survey is made for the use of the
present owners of the property, and also those who purchase, mortgage, or
guarantee the title thereto within one year from the date hereof.

Dated at Woodstock, McHenry County, Illinois 01/19 A.D., 20 21.

Vanderstappen Land Surveying, Inc.
Design Firm No. 184-002792

Wisconsin Registered Land Surveyor No. S1777

CLIENT: KEEFE REAL ESTATE
DRAWN BY: CKV CHECKED BY: WJV
SCALE: 1"=100' SEC. 19/24 T. 02 R. 5/ME.
BASIS OF BEARING: ASSUMED
P.I.N.: BA366000001; 006001168
JOB NO.: 210018 I.D. MBS
FIELDWORK COMP.: 01/15/21 BK. PG.
ALL DISTANCES SHOWN IN FEET AND DECIMAL REF.
PARTS THEREOF CORRECTED TO 60° F.