
# Plat of Survey

of

## Lot 7 of Westwood,

a subdivision located in the Southeast 1/4 of the Southeast 1/4 of Section 11 and the Northeast 1/4 of the Northeast 1/4 of Section 14, all in Town 2 North, Range 15 East, Town of Darien, Walworth County, Wisconsin.

Surveyed for: **Dan Hartogh**
N4081 Westwood Drive
Delavan, Wisconsin. 53115

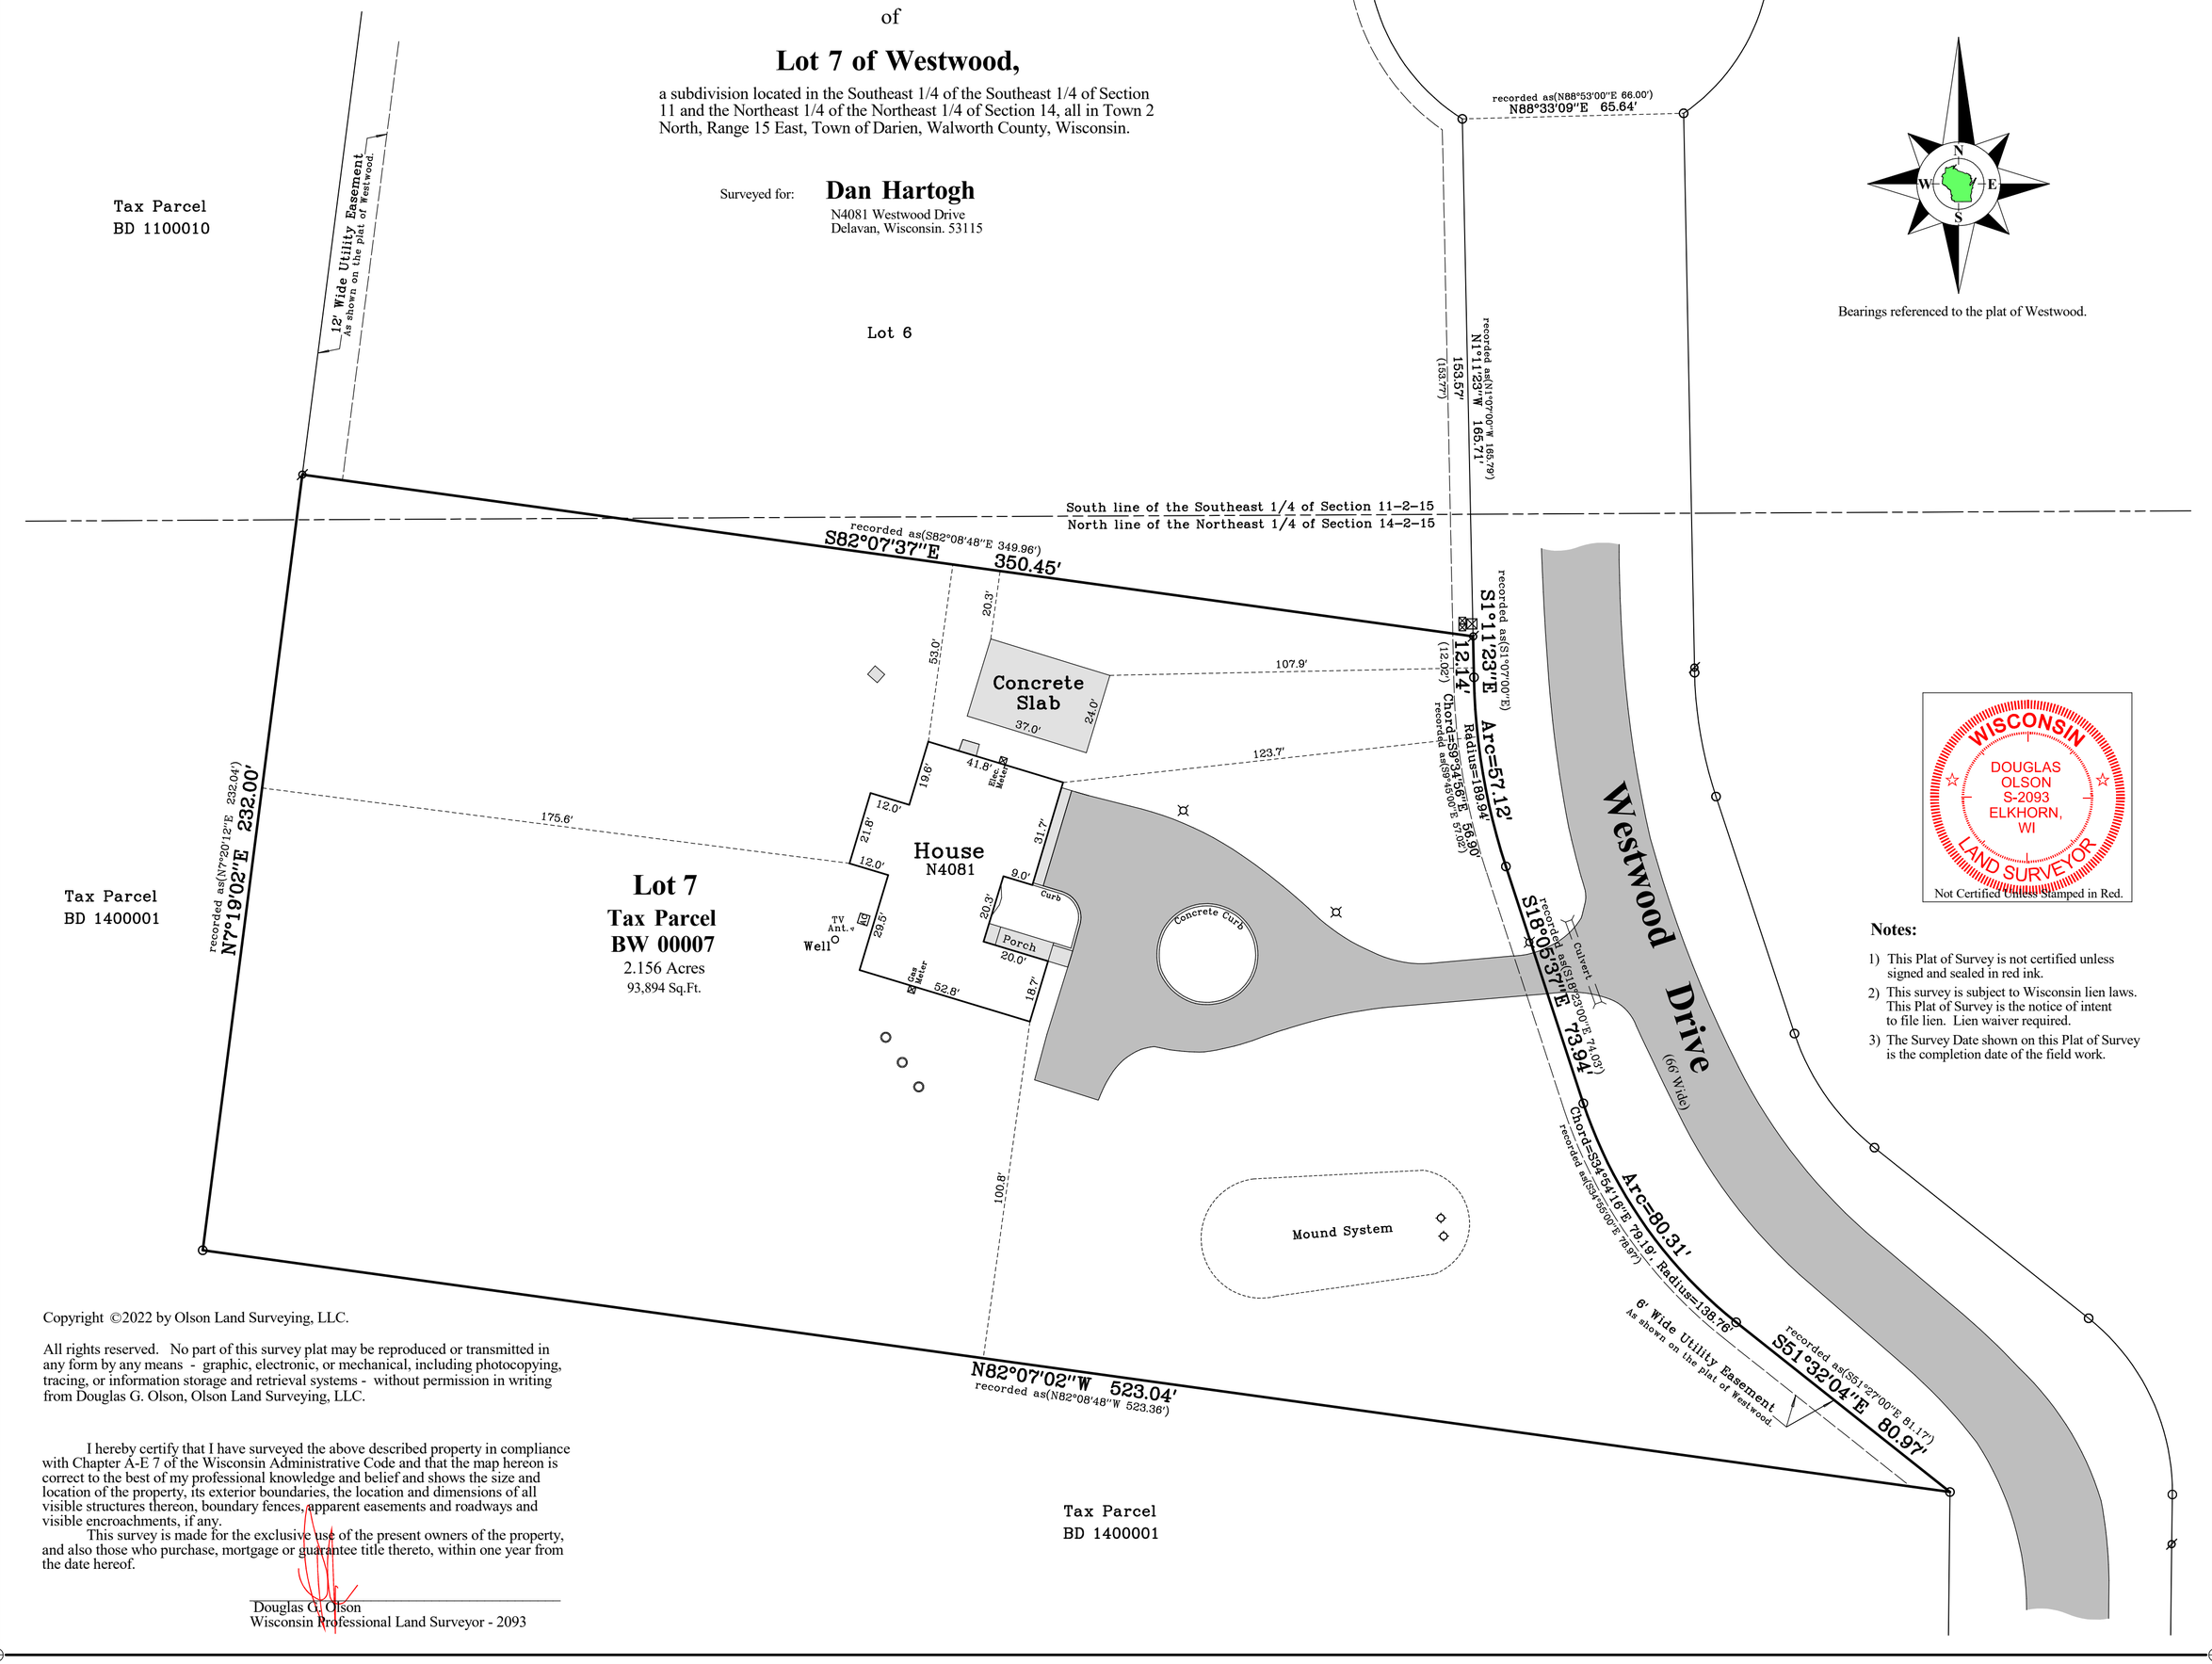


Bearings referenced to the plat of Westwood.

DOUGLAS OLSON S-2093 ELKHORN, WI — WISCONSIN LAND SURVEYOR

Not Certified Unless Stamped in Red.

**Notes:**

1) This Plat of Survey is not certified unless signed and sealed in red ink.
2) This survey is subject to Wisconsin lien laws. This Plat of Survey is the notice of intent to file lien. Lien waiver required.
3) The Survey Date shown on this Plat of Survey is the completion date of the field work.

Copyright ©2022 by Olson Land Surveying, LLC.

All rights reserved. No part of this survey plat may be reproduced or transmitted in any form by any means - graphic, electronic, or mechanical, including photocopying, tracing, or information storage and retrieval systems - without permission in writing from Douglas G. Olson, Olson Land Surveying, LLC.

I hereby certify that I have surveyed the above described property in compliance with Chapter A-E 7 of the Wisconsin Administrative Code and that the map hereon is correct to the best of my professional knowledge and belief and shows the size and location of the property, its exterior boundaries, the location and dimensions of all visible structures thereon, boundary fences, apparent easements and roadways and visible encroachments, if any.

This survey is made for the exclusive use of the present owners of the property, and also those who purchase, mortgage or guarantee title thereto, within one year from the date hereof.

Douglas G. Olson
Wisconsin Professional Land Surveyor - 2093

**Survey Date:** June 13, 2022.

Revisions: No. 1 – Proposed Building
No. 2 – Modified Proposed Building
No. 3 – Building Staked with offsets 7-28-22
No. 4 – Concrete Slab

**Scale in Feet**
**1" = 30'**

0' 15' 30' 60' 90'

45 South Wisconsin Street | P.O. Box 322
Elkhorn, Wisconsin. 53121
Telephone: (262) 723-3434
Facsimile: (262) 723-8044
Email: doug@olsonsurveying.com
Website: www.olsonsurveying.com

OLSON LAND SURVEYING, LLC
Rural | Residential | Commercial

**Legend** of Symbols & Abbreviations

Found County Section Corner
Found Iron Pipe, 2" dia.
Found Iron Pipe, 1" dia.
Recorded Information
Utility Box or Pedestal
Concrete Cover
Control Point
Asphalt Surface
Concrete Surface
Set Wood Stake
Set Cut Cross
07-28-2022
Lamp

N North
S South
E East
W West
In Bearings
° Degrees
' Minutes
" Seconds
In Distances
Feet
" Inches

**Sheet 1 of 1 Sheets**

Drawing Name:

**Job Reference Number**
**2022.070**

**2022.070**