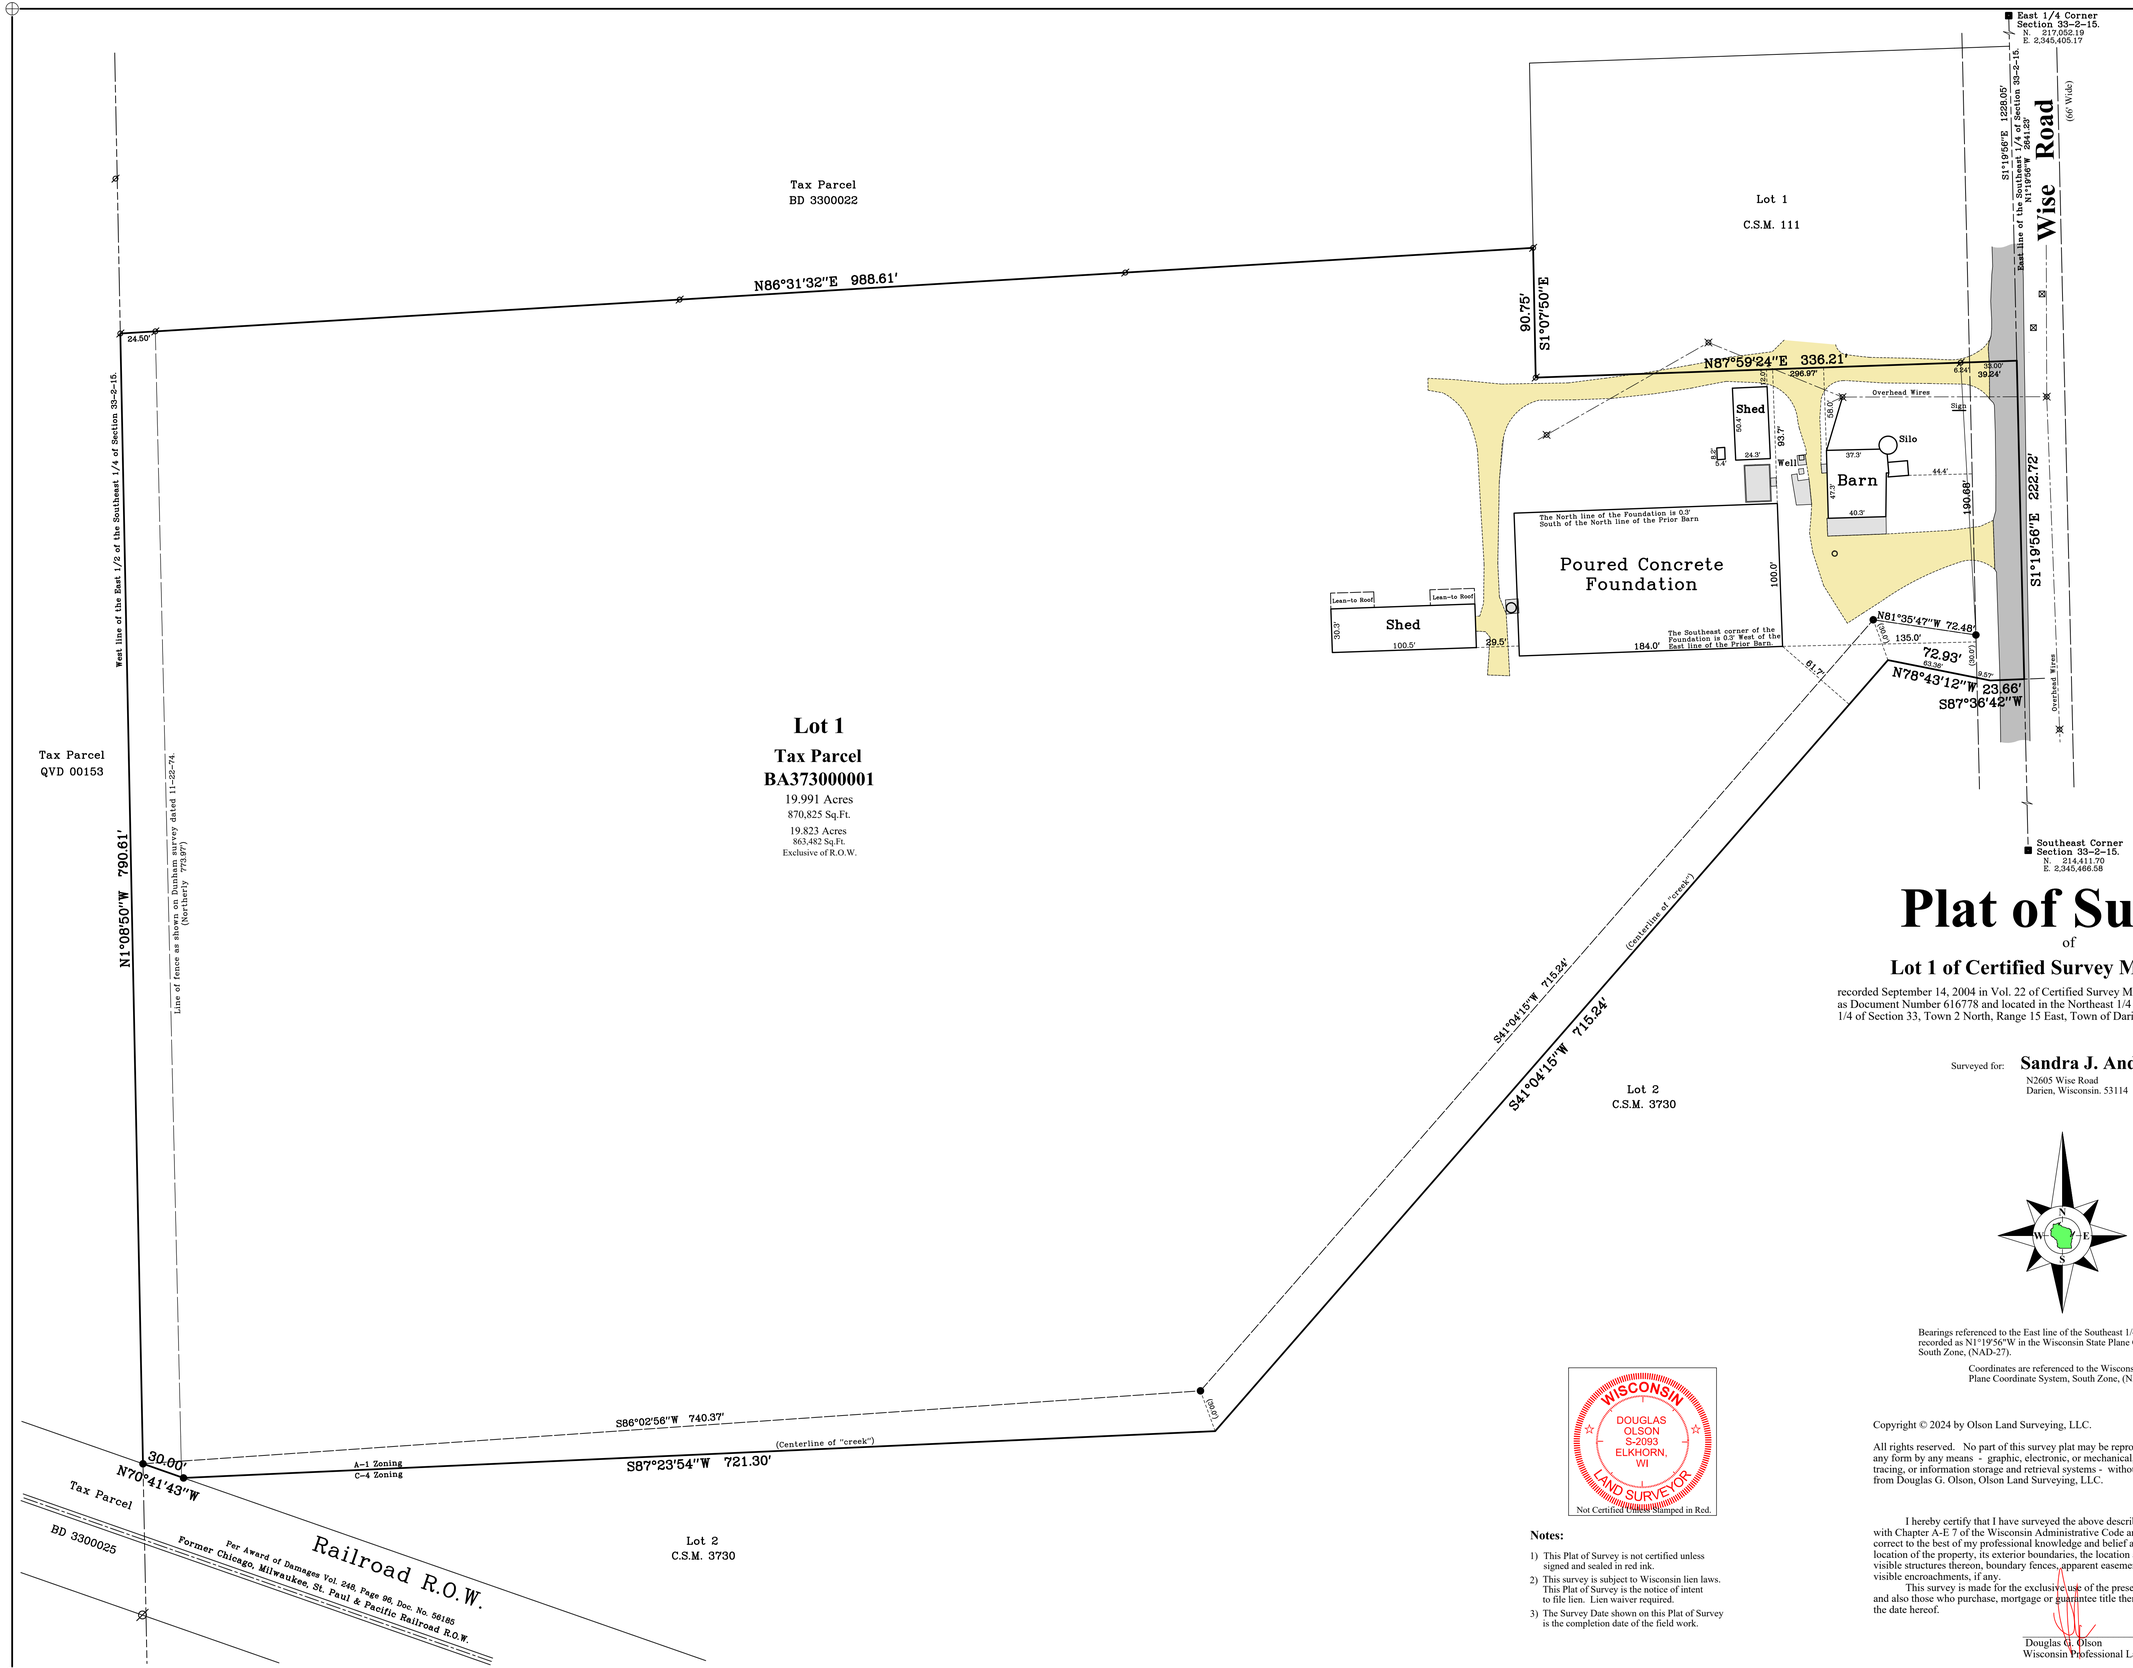

Plat of Survey

of

Lot 1 of Certified Survey Map No. 3730,

recorded September 14, 2004 in Vol. 22 of Certified Survey Maps of Walworth County on Page 203 as Document Number 616778 and located in the Northeast 1/4 and the Southeast 1/4 of the Southeast 1/4 of Section 33, Town 2 North, Range 15 East, Town of Darien, Walworth County, Wisconsin.

Surveyed for: **Sandra J. Anderson**
N2605 Wise Road
Darien, Wisconsin. 53114

Bearings referenced to the East line of the Southeast 1/4 of Section 33-2-15, recorded as N1°19'56"W in the Wisconsin State Plane Coordinate System, South Zone, (NAD-27).

Coordinates are referenced to the Wisconsin State Plane Coordinate System, South Zone, (NAD-27).

WISCONSIN
DOUGLAS OLSON
S-2093
ELKHORN, WI
LAND SURVEYOR
Not Certified Unless Stamped in Red.

Notes:

1) This Plat of Survey is not certified unless signed and sealed in red ink.
2) This survey is subject to Wisconsin lien laws. This Plat of Survey is the notice of intent to file lien. Lien waiver required.
3) The Survey Date shown on this Plat of Survey is the completion date of the field work.

Copyright © 2024 by Olson Land Surveying, LLC.

All rights reserved. No part of this survey plat may be reproduced or transmitted in any form by any means - graphic, electronic, or mechanical, including photocopying, tracing, or information storage and retrieval systems - without permission in writing from Douglas G. Olson, Olson Land Surveying, LLC.

I hereby certify that I have surveyed the above described property in compliance with Chapter A-E 7 of the Wisconsin Administrative Code and that the map hereon is correct to the best of my professional knowledge and belief and shows the size and location of the property, its exterior boundaries, the location and dimensions of all visible structures thereon, boundary fences, apparent easements and roadways and visible encroachments, if any.

This survey is made for the exclusive use of the present owners of the property, and also those who purchase, mortgage or guarantee title thereto, within one year from the date hereof.

Douglas G. Olson
Wisconsin Professional Land Surveyor - 2093

Survey date: August 6, 2024.
Revisions: No. 1 – Building As Staked 09-20-2024
No. 2 – Foundation As-Built

Scale in Feet
1" = 50'
0' 25' 50' 100' 150'

45 South Wisconsin Street | P.O. Box 322
Elkhorn, Wisconsin. 53121
Telephone: (262) 723-3434
Facsimile: (262) 723-8044
Email: doug@olsonsurveying.com
Website: www.olsonsurveying.com

OLSON
LAND SURVEYING, LLC
Rural | Residential | Commercial

Legend of Symbols & Abbreviations

- Found County Section Corner
- Found Iron Pipe
- Found Iron Rod
- Set Iron Pipe, 1" dia.
- Recorded Information
- Utility Pole
- Utility Pedestal
- Utility Cover
- Septic Vent
- Asphalt Surface
- Concrete Surface
- Gravel Surface
- Brick Pavers
- Set Reg. Stake with Nail Hole on Top

N North
S South
E East
W West
Ft. Feet
Dia. Diameter
Sq. Square
Ac. Acres
In. Inches
Yd. Yard
NW Northwest
NE Northeast
Dia. Diameter

Sheet 1 of 1 Sheets

Drawing Name:

Job Reference Number
2024.072

2024.072