ABERNATHY and ASSOCIATES
Kenneth B. Abernathy Jr.
Wisconsin Registered Land Surveyor S-1594

W4056 Bray Road
Elkhorn, Wisconsin 53121
Phone: (414) 723-4260 (office)
(414) 723-7209 (fax)

PLAT OF SURVEY

LOT 5 AND THE NORTHEASTERLY 44 FEET OF LOT 6 OF COLLIE'S GROVE SUBDIVISION LOCATED IN THE NORTHWEST 1/4 OF SECTION 33, TOWN 2 NORTH, RANGE 16 EAST, TOWN OF DELAVAN, WALWORTH COUNTY, WISCONSIN.

OWNED BY: JOHN & GLORIA DWINNELL
3409 S. SHORE DRIVE
DELAVAN, WIS. 53115

ORDERED BY: KIM DEVINCENTIS
RE/MAX LAKES AREA REALTORS
1815 NORTH SHORE DRIVE
DELAVAN, WI. 53115

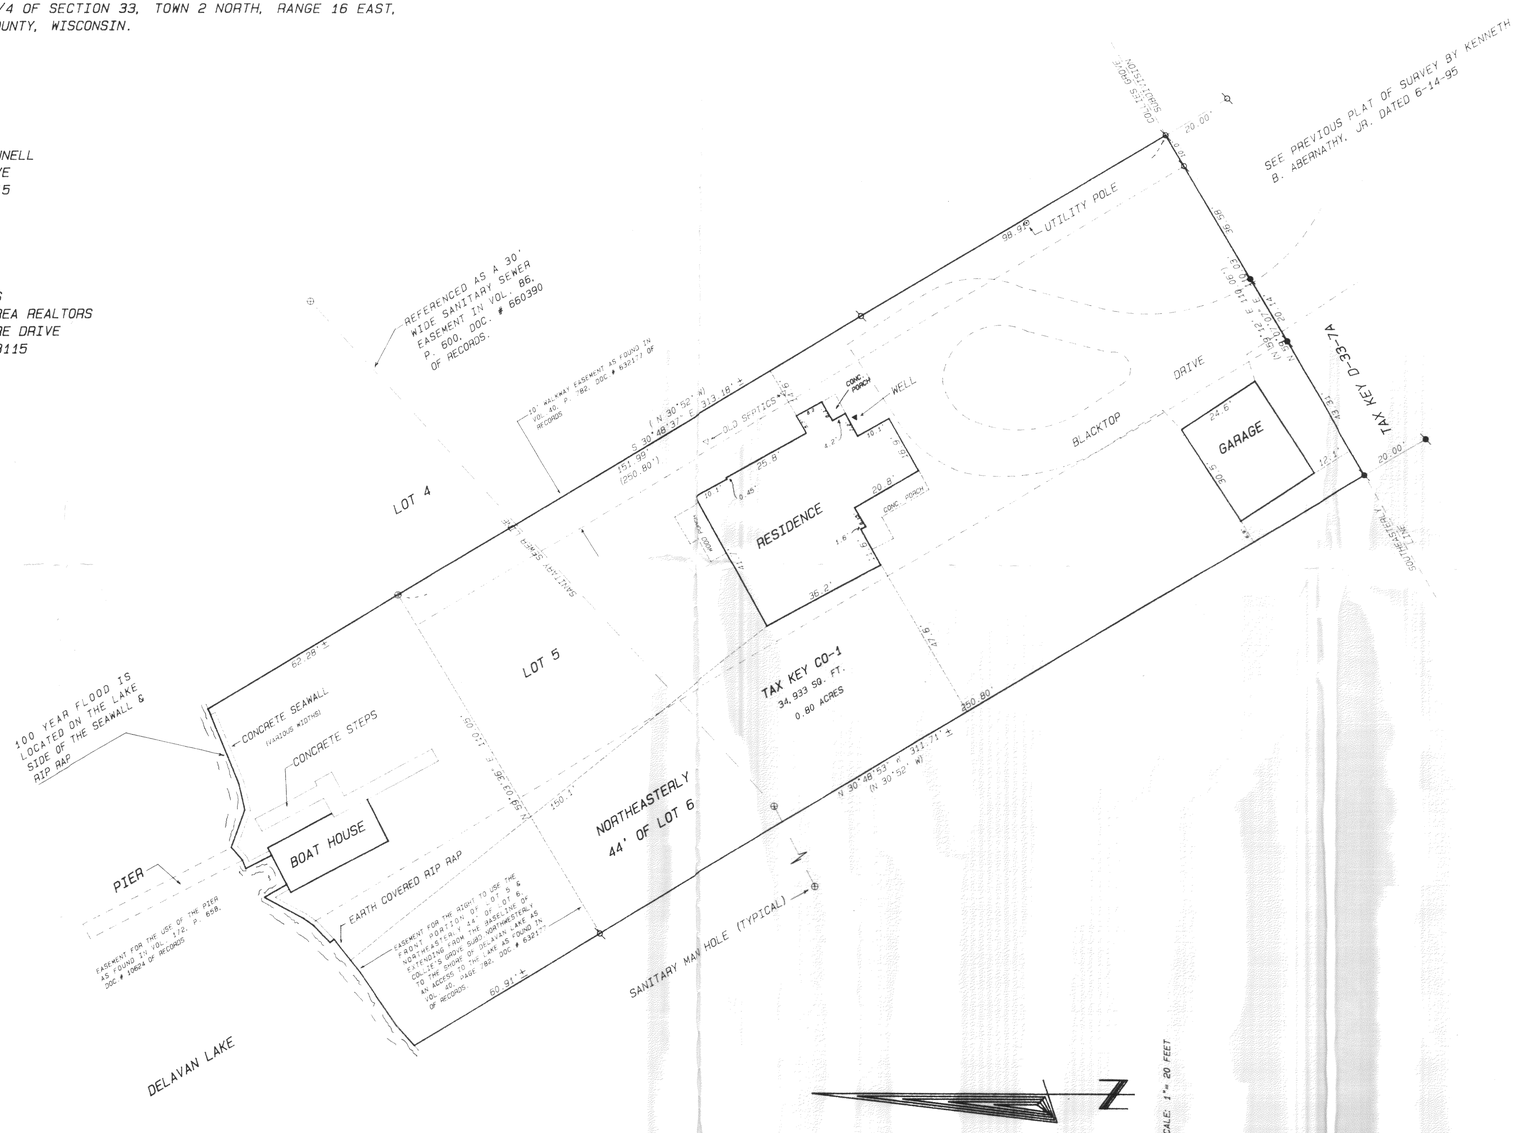

Legend

- FOUND IRON PIPE
- FOUND IRON ROD
- FOUND BRASS CAPPED MONUMENT
- FOUND CONCRETE MONUMENT
- CHISEL CUT IN CONCRETE
- SET IRON ROD 24" LONG, WEIGHING 1.5 LBS. LINEAL FT. 1" ø DIA
- SET IRON ROD 30" LONG, WEIGHING 4.5 LBS. LINEAL FT. 1 1/4" ø DIA
- (XX) RECORDED AS DIMENSION
- EXISTING FENCE

RECEIVED
OCT 22 1997

SCALE: 1" = 20 FEET

I hereby certify that the above described property has been surveyed by me or under my direction and that the above map is a true representation thereof and shows the size and location of the property, its exterior boundaries, the location of all visible structures and dimensions of all principal buildings thereon, boundary fences, apparent easements, roadways and visible encroachments, if any.
(This survey is made for the use of the present owners of the property and also those who purchase, mortgage or guarantee the title thereto within one year from date hereof.)

WISCONSIN
KENNETH B. ABERNATHY, JR.
S-1594
ELKHORN, WI
LAND SURVEYOR

KENNETH B. ABERNATHY, JR.
WISCONSIN REGISTERED LAND SURVEYOR, S-1594

Date: 10-20-97 Job No. 97-3015

216-2515
FCo-1

DESIGN PRODUCTS