
ABELL
SURVEYING & MAPPING
DELAVAN, WISCONSIN 53115
414-728-6737

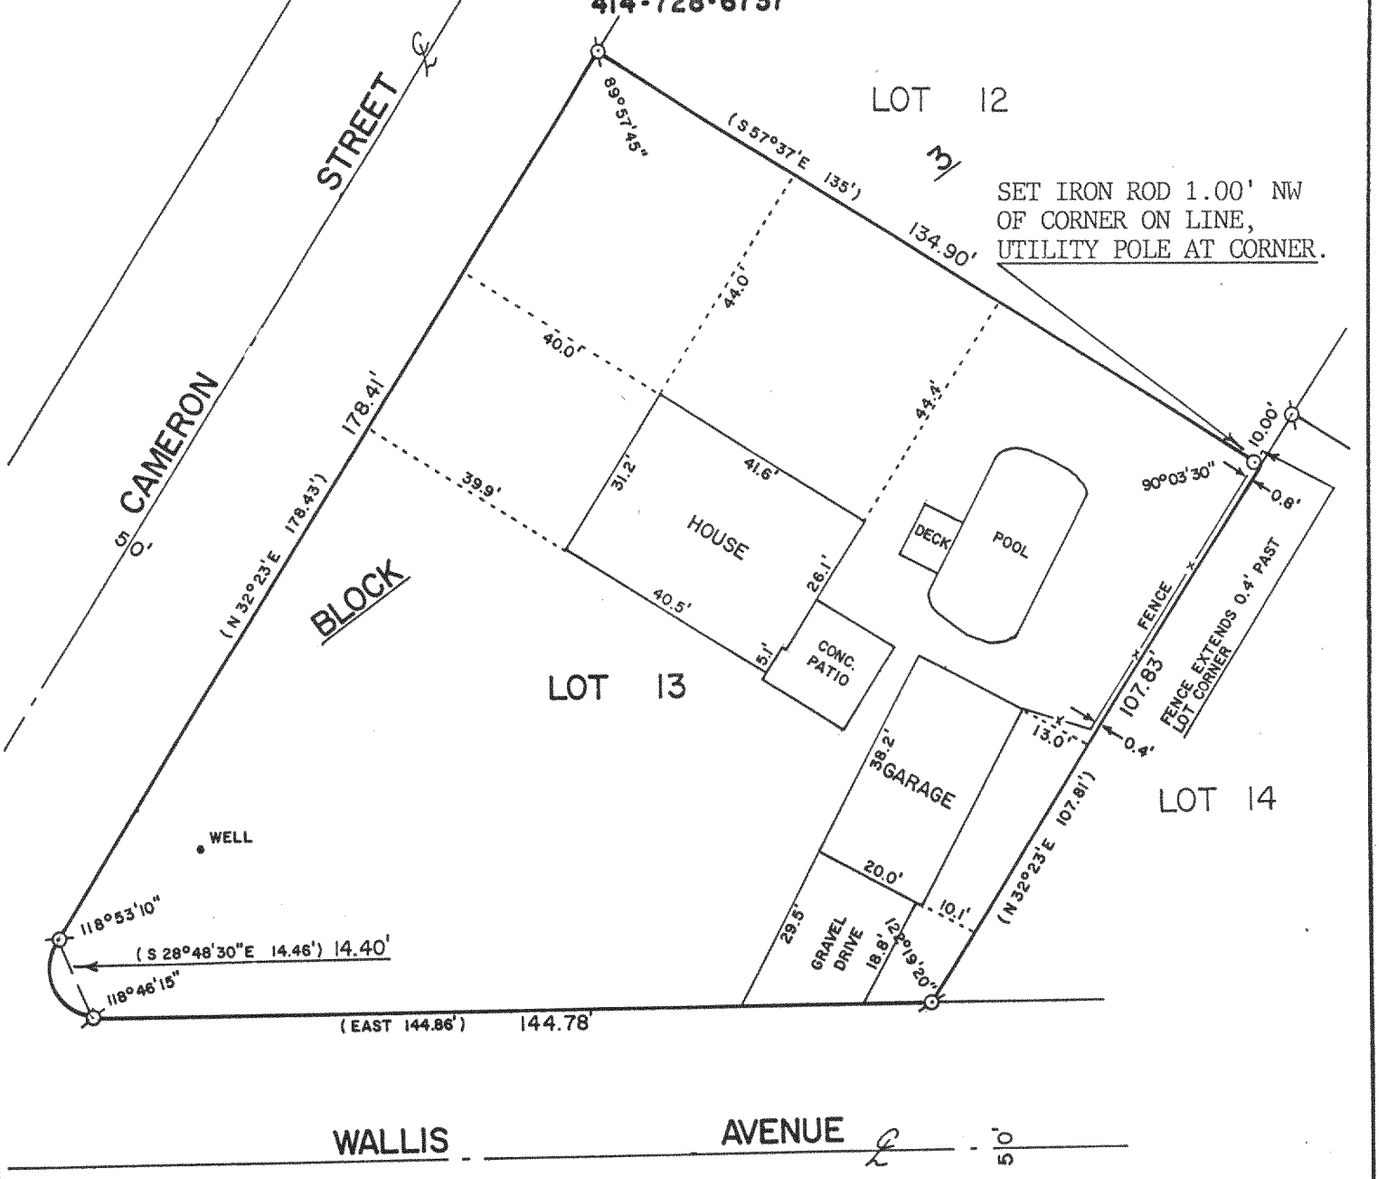

PLAT OF SURVEY OF

LOT 13, BLOCK 3, DELMAR SUBDIVISION, LOCATED IN T2N,R16E, WALWORTH COUNTY, WISCONSIN.

ORDERED BY: CENTURY 21 - SKANDIA REALTY
312 S. 7th STREET
DELAVAN, WI. 53115

OWNER: GERALD AND HELEN BRELLENTHIN

RECEIVED
APR 7

SCALE - 1"=30'

LEGEND
⌀ - IRON PIPE FOUND
○ - IRON ROD SET
( )- RECORDED AS

I, DAVID F. ABELL, DO HEREBY CERTIFY THAT I HAVE SURVEYED THE PROPERTY HEREON DESCRIBED ACCORDING TO THE OFFICIAL RECORDS AND THAT THE PLAT HEREON IS A CORRECT REPRESENTATION OF THE PROPERTY LINES TO THE BEST OF MY KNOWLEDGE AND BELIEF.

David F. Abell
DAVID F. ABELL
WISCONSIN REGISTERED LAND SURVEYOR, S-1596

March 19, 1988
DATE JOB NUMBER - 88036

NOTE: THIS IS NOT A CERTIFIED COPY UNLESS SEALED.

FDM-18B

216-1009