


DUNHAM SURVEYING, S.C.
SURVEYING & SUBDIVIDING
DELAVER, WISCONSIN 53115

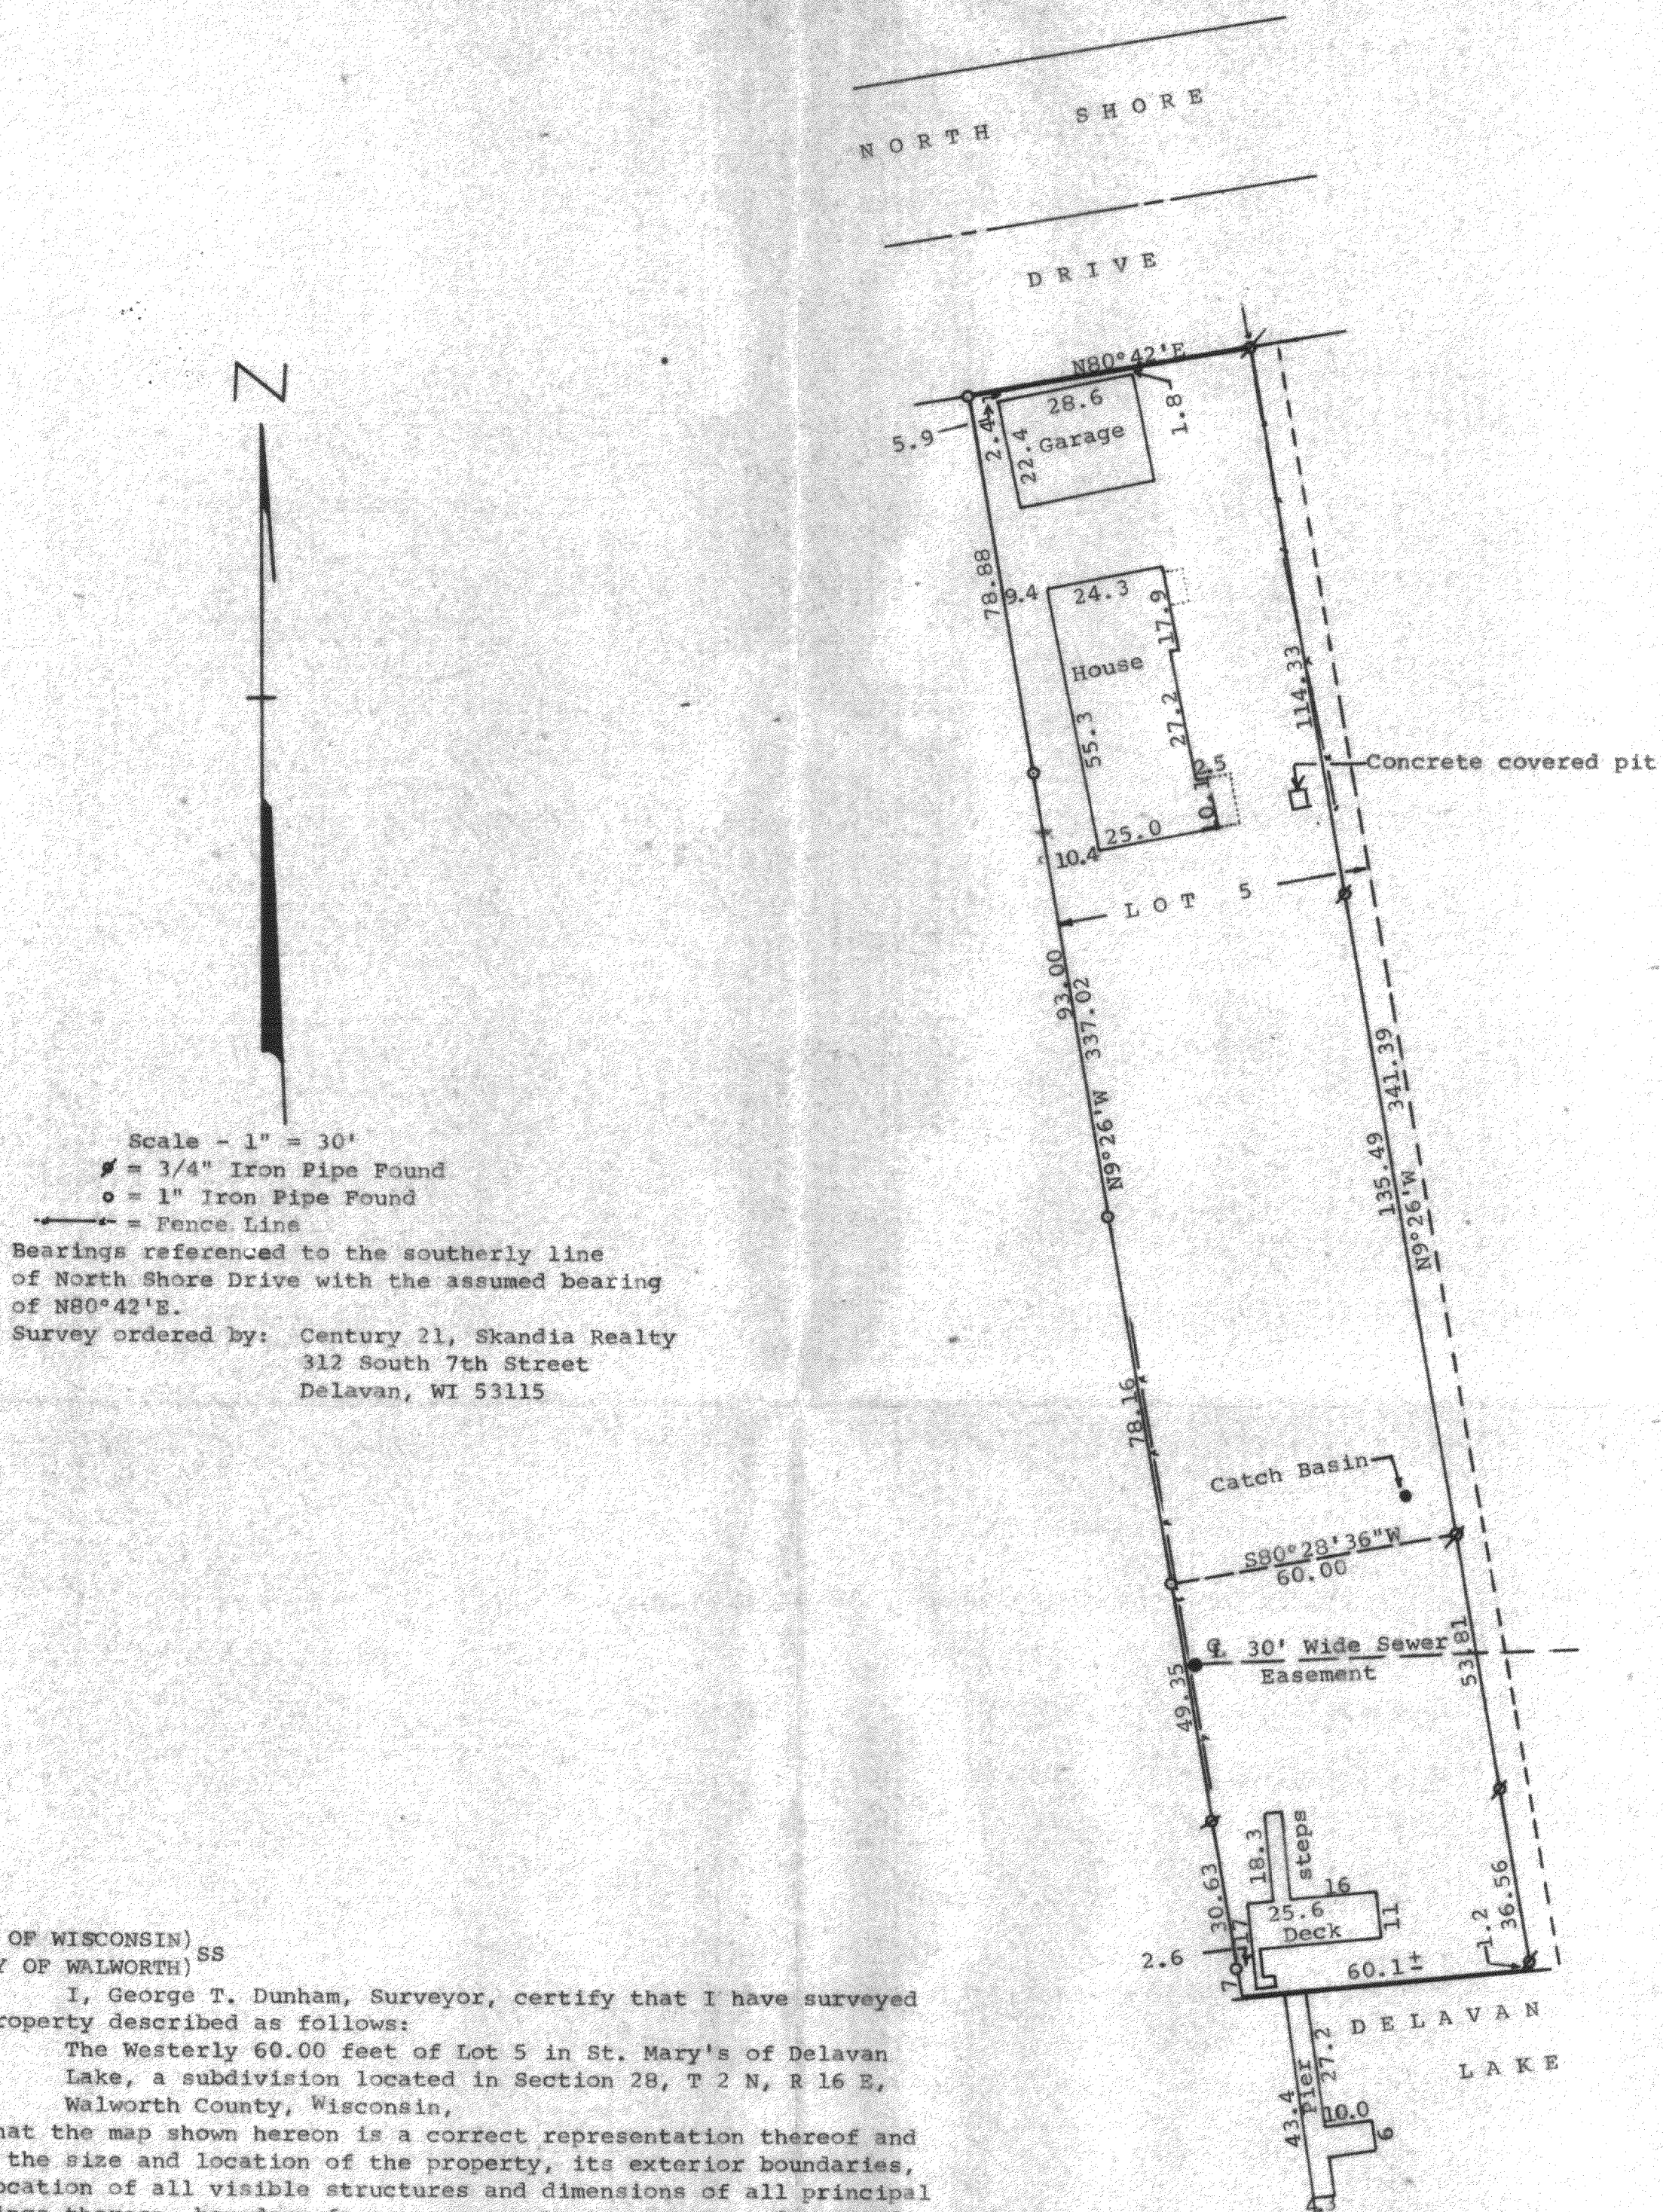

Scale - 1" = 30'
 * = 3/4" Iron Pipe Found
 o = 1" Iron Pipe Found
 --- = Fence Line
 Bearings referenced to the southerly line
 of North Shore Drive with the assumed bearing
 of N80°42'E.
 Survey ordered by: Century 21, Skandia Realty
 312 South 7th Street
 Delavan, WI 53115

STATE OF WISCONSIN) SS
 COUNTY OF WALWORTH)
 I, George T. Dunham, Surveyor, certify that I have surveyed
 the property described as follows:
 The Westerly 60.00 feet of Lot 5 in St. Mary's of Delavan
 Lake, a subdivision located in Section 28, T 2 N, R 16 E,
 Walworth County, Wisconsin,
 and that the map shown hereon is a correct representation thereof and
 shows the size and location of the property, its exterior boundaries,
 the location of all visible structures and dimensions of all principal
 buildings thereon, boundary fences, apparent easements, roadways and
 visible encroachments, if any, and that I have surveyed the property
 hereon described according to the official records, to the best of my
 knowledge and belief.
 June 7, 1985
 Dated & recertified this
 8th Day of February 1988

George T. Dunham
 George T. Dunham, Surveyor

