

DUNHAM SURVEYING, S. C.

SURVEYING & SUBDIVIDING
DELAVAN, WISCONSIN 53115

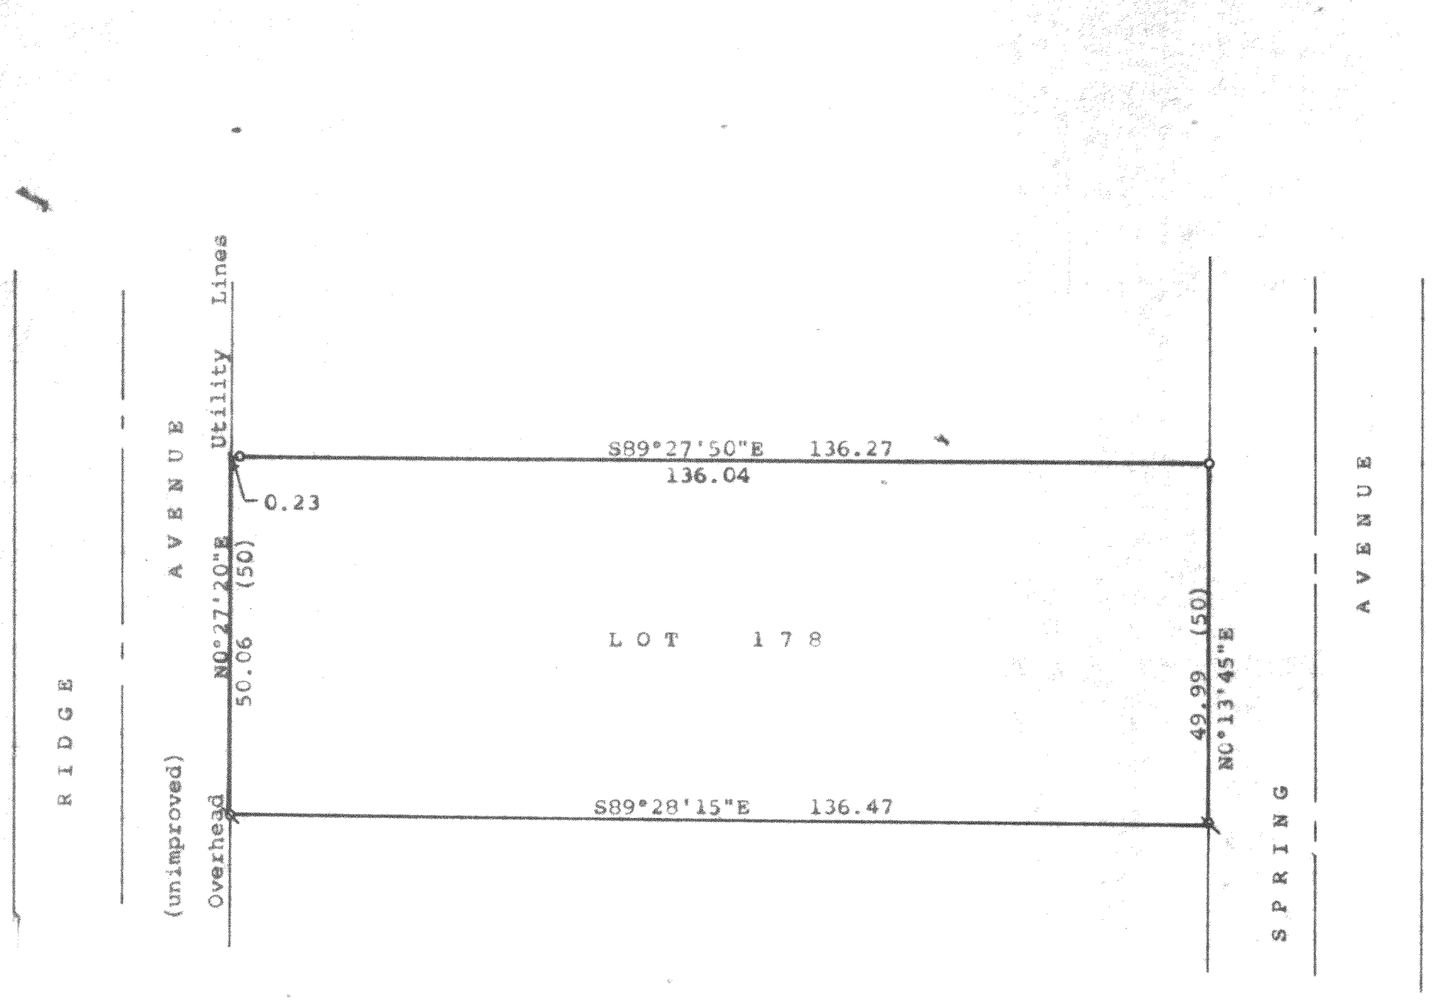

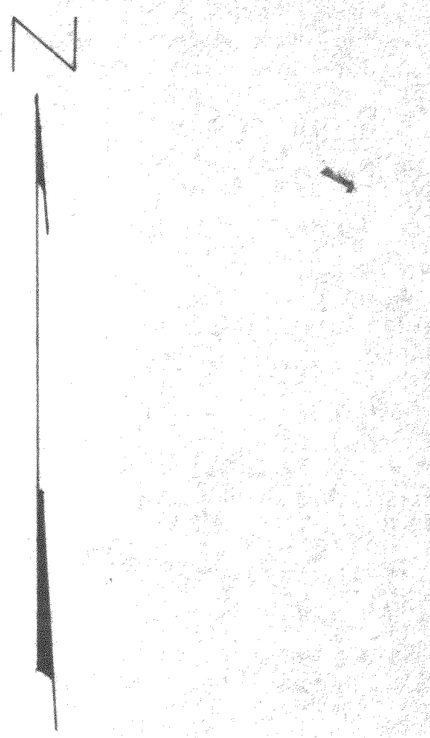

Scale - 1" = 20'
⊗= 1" Iron Pipe Found
o= 3/4" Iron Pipe Found
(0.00) = recorded distance
Bearings referenced to the assumed bearing of N0°27'20"E along the easterly line of Ridge Avenue.
Survey ordered by:
The Rauland Agency
Walworth, WI 53184

STATE OF WISCONSIN)
COUNTY OF WALWORTH) SS

I, George T. Dunham, Surveyor, certify that I have surveyed the property described as follows:

Lot 178 in Lake Delavan Highlands, a subdivision located in the South ½ of the Southeast ¼ ofSection 31, T 2 N, R 16 E, Walworth County, Wisconsin,

and that the plat shown hereon is a correct representation thereof and shows the size and location of the property, its exterior boundaries, the location of all visible structures and dimensions of all principal buildings thereon, boundary fences, apparent easements, roadways and visible encroachments, if any, and that I have surveyed the property hereon described, according to the official records, to the best of my knowledge and belief.

November 15, 1989

George T. Dunham, Surveyor

RECEIVED
AUG 16 1990

WISCONSIN
GEORGE T. DUNHAM
S-306
DELAVAN WIS.
LAND SURVEYOR

Survey# 216-1306

TAX KEY# FLAD 00139

513048
OMB 1020