

DUNHAM & RASMUSSEN
SURVEYING & ENGINEERING
DELAVAN, WISCONSIN

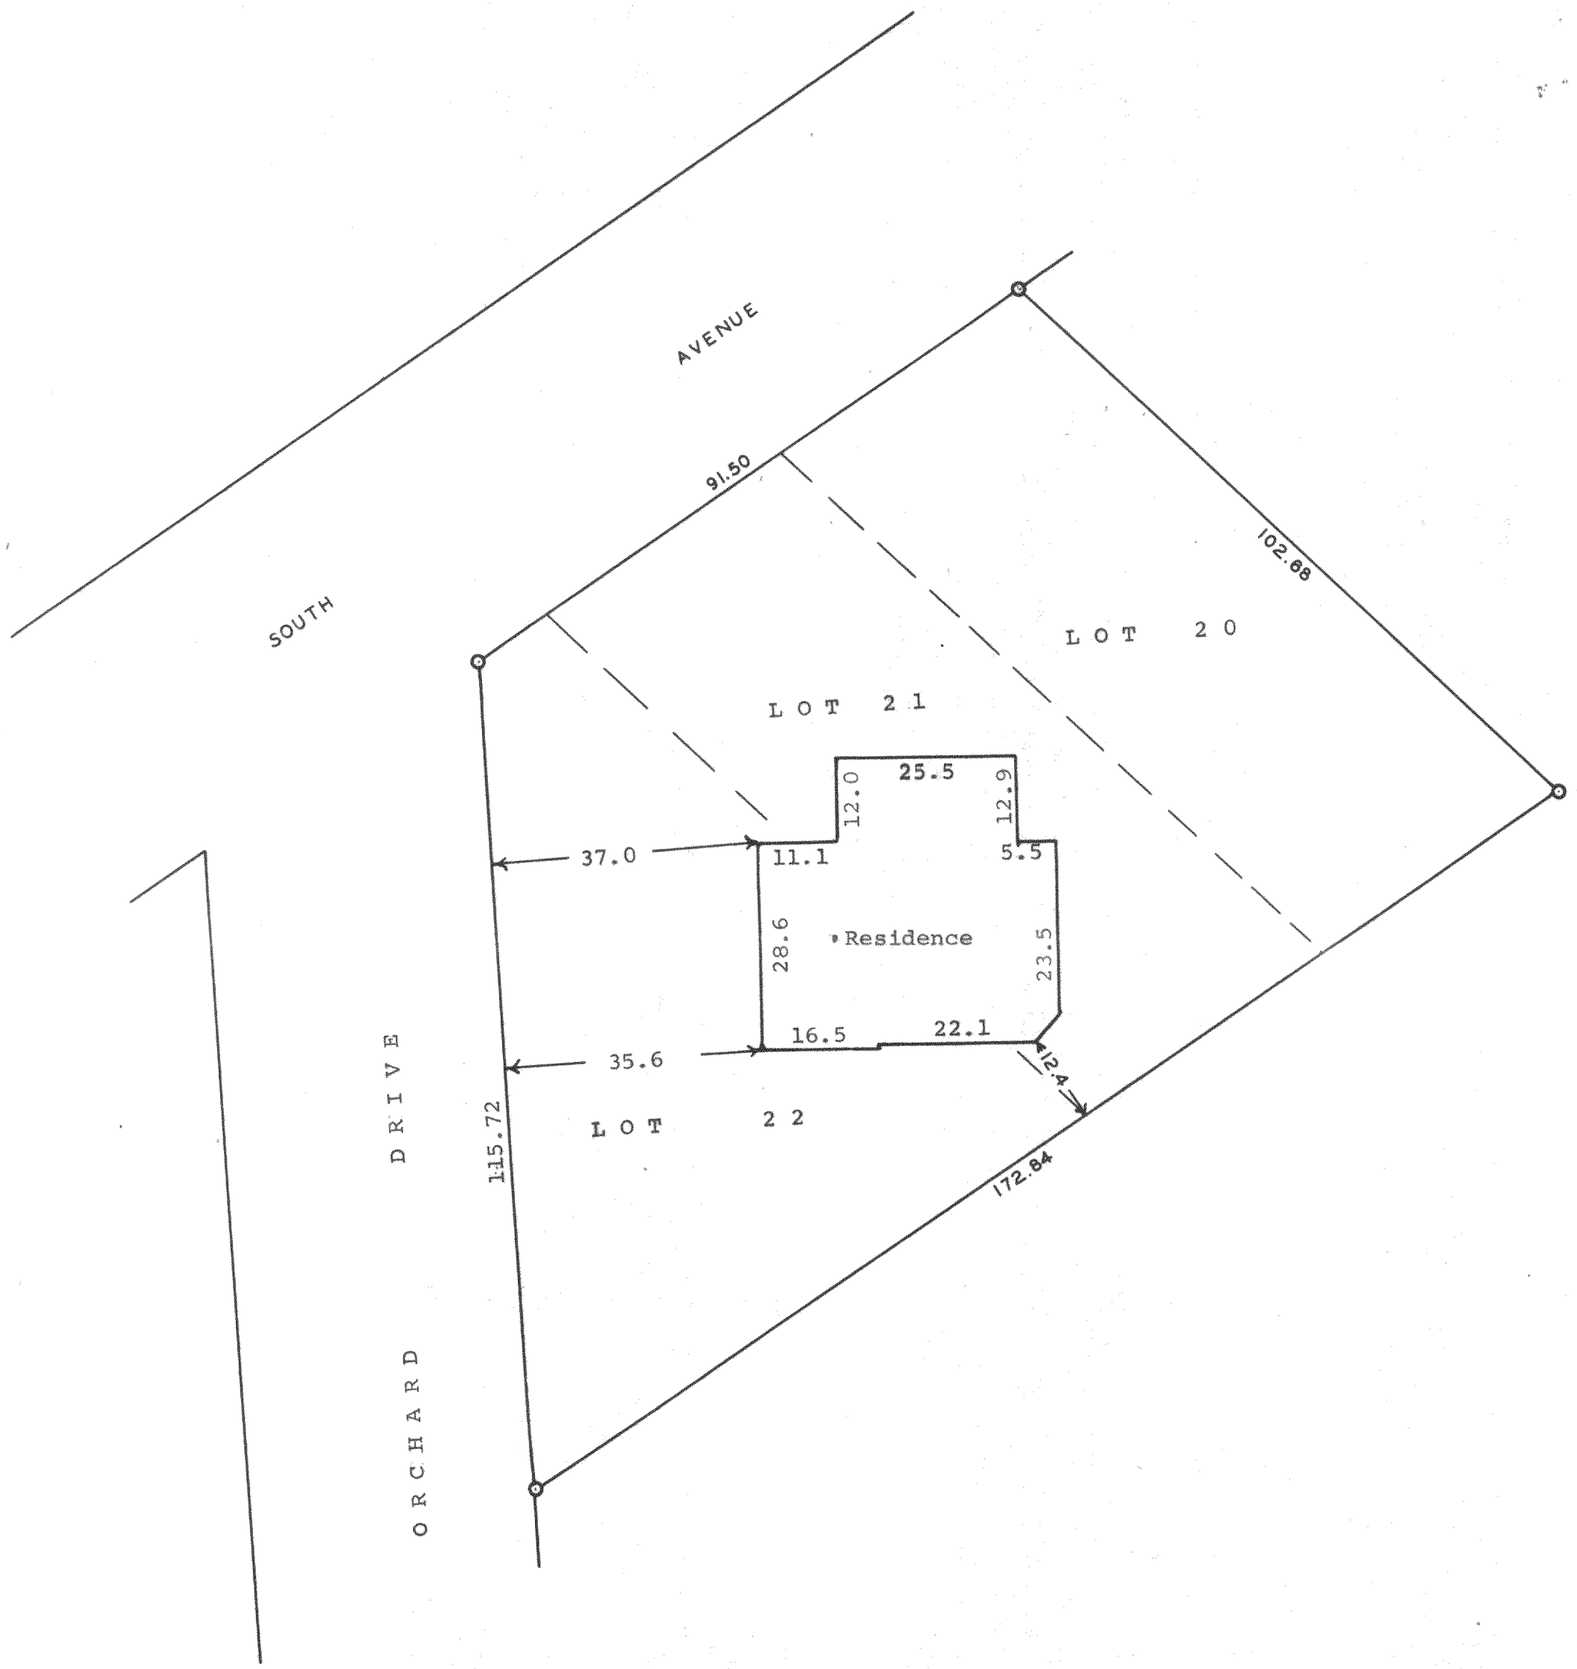

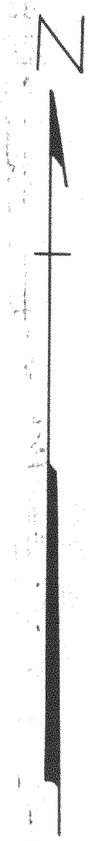

Scale - 1" = 20'
O = Iron Pipe

STATE OF WISCONSIN)
WALWORTH COUNTY) SS

I, George T. Dunham, do hereby certify that I have surveyed the property described as follows,

Lots 20, 21, and 22, Block 3, South Shore Manor located in Section 32, T 2 N R 16 E of Walworth County, Wisconsin

and that the plat shown above is a correct representation of the property lines and of the improvements located thereon.

April 19, 1962
Revised June 29, 1962

George T. Dunham
George T. Dunham, Surveyor

F55-59
(RVD)

216-147