
# ABELL
# SURVEYING & MAPPING

DELAVAN, WISCONSIN 53115
414-728-6737

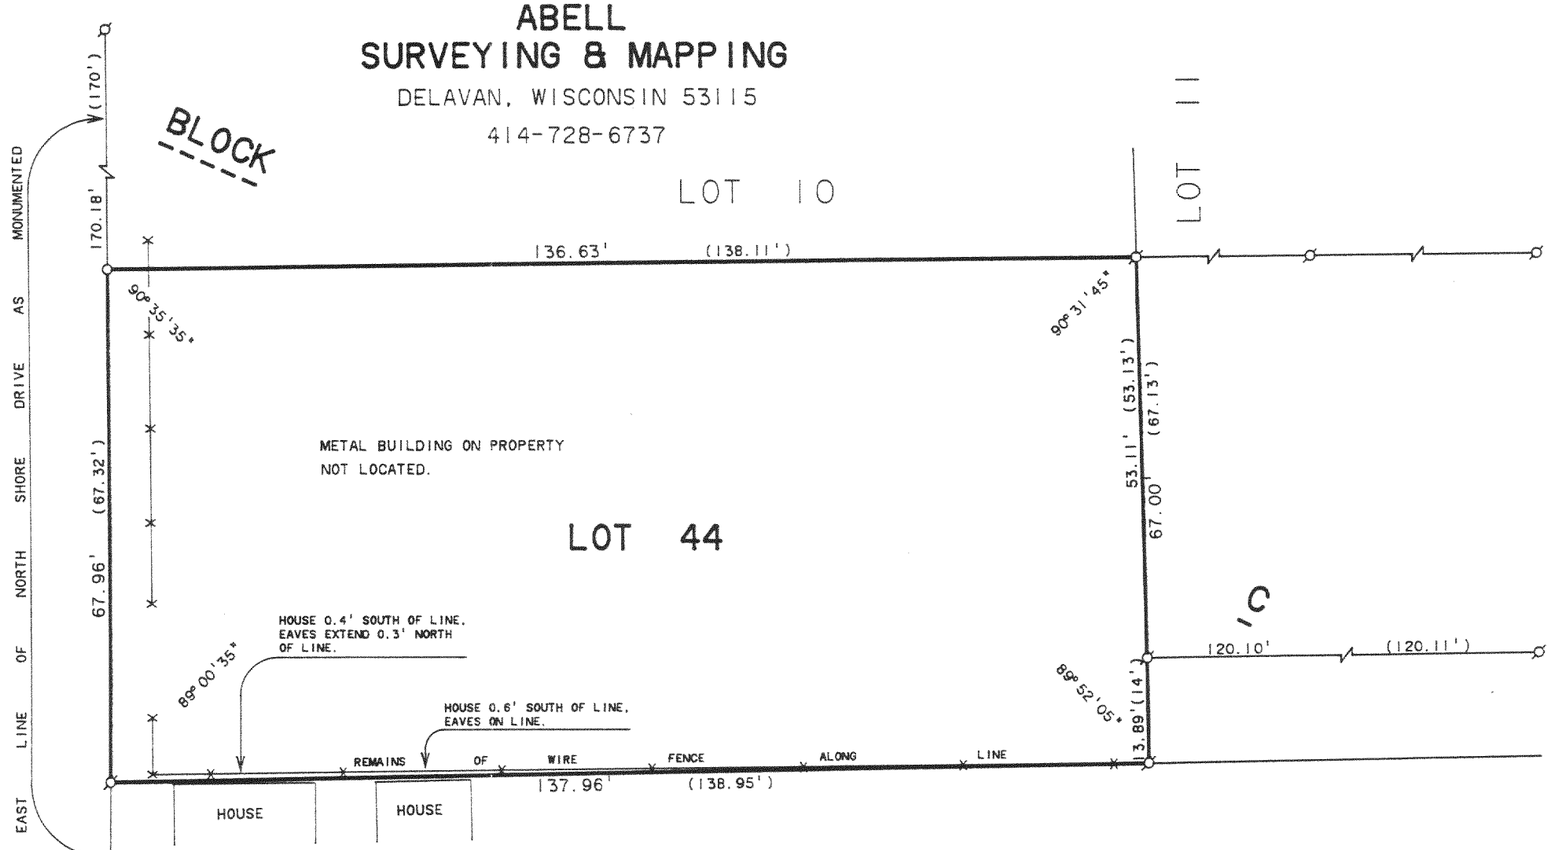


SCALE 1"=20'

LEGEND

- ⌀ - IRON PIPE FOUND
- ○ - IRON PIPE SET
- ✕——✕ - FENCE
- ( ) - RECORDED AS

## PLAT OF SURVEY OF

LOT 44, BLOCK C, DELAVAN LAKE ASSEMBLY GROUNDS
LOCATED IN R2N, T16E, WALWORTH COUNTY, WISCONSIN.

ORDERED BY: CHARLES RAWLINGS
1607 POTTAWATOMI DR.
DELAVAN, WI. 53115

RECEIVED
NOV 19 1991

I, DAVID F. ABELL, DO HEREBY CERTIFY THAT I HAVE SURVEYED THE PROPERTY HEREON DESCRIBED ACCORDING TO THE OFFICAL RECORDS AND THAT THE PLAT HEREON IS A CORRECT REPRESENTATION OF THE PROPERTY LINES TO THE BEST OF MY KNOWLEDGE AND BELIEF.

David F. Abell

DAVID F. ABELL
WISCONSIN REGISTERED LAND SURVEYOR, S-1596

July 3, 1991

DATE JOB NUMBER - 91123

NOTE: THIS IS NOT A CERTIFIED COPY UNLESS SEALED.

216-1477

FDLA -44F