


DUNHAM SURVEYING, S.C.
SURVEYING & SUBDIVIDING
DELAVER, WISCONSIN 53115

N

Scale - 1" = 20'
Ø = 1 1/4" Iron Pipe Found
Q = 1" Iron Pipe Found
● = 1" X 24" Iron Pipe Set
○ = 3/4" X 24" Iron Pipe Set
Survey ordered by:
Loepke Construction Co.
Route 1, Box 343
Walworth, WI 53184
--- = Fence Line

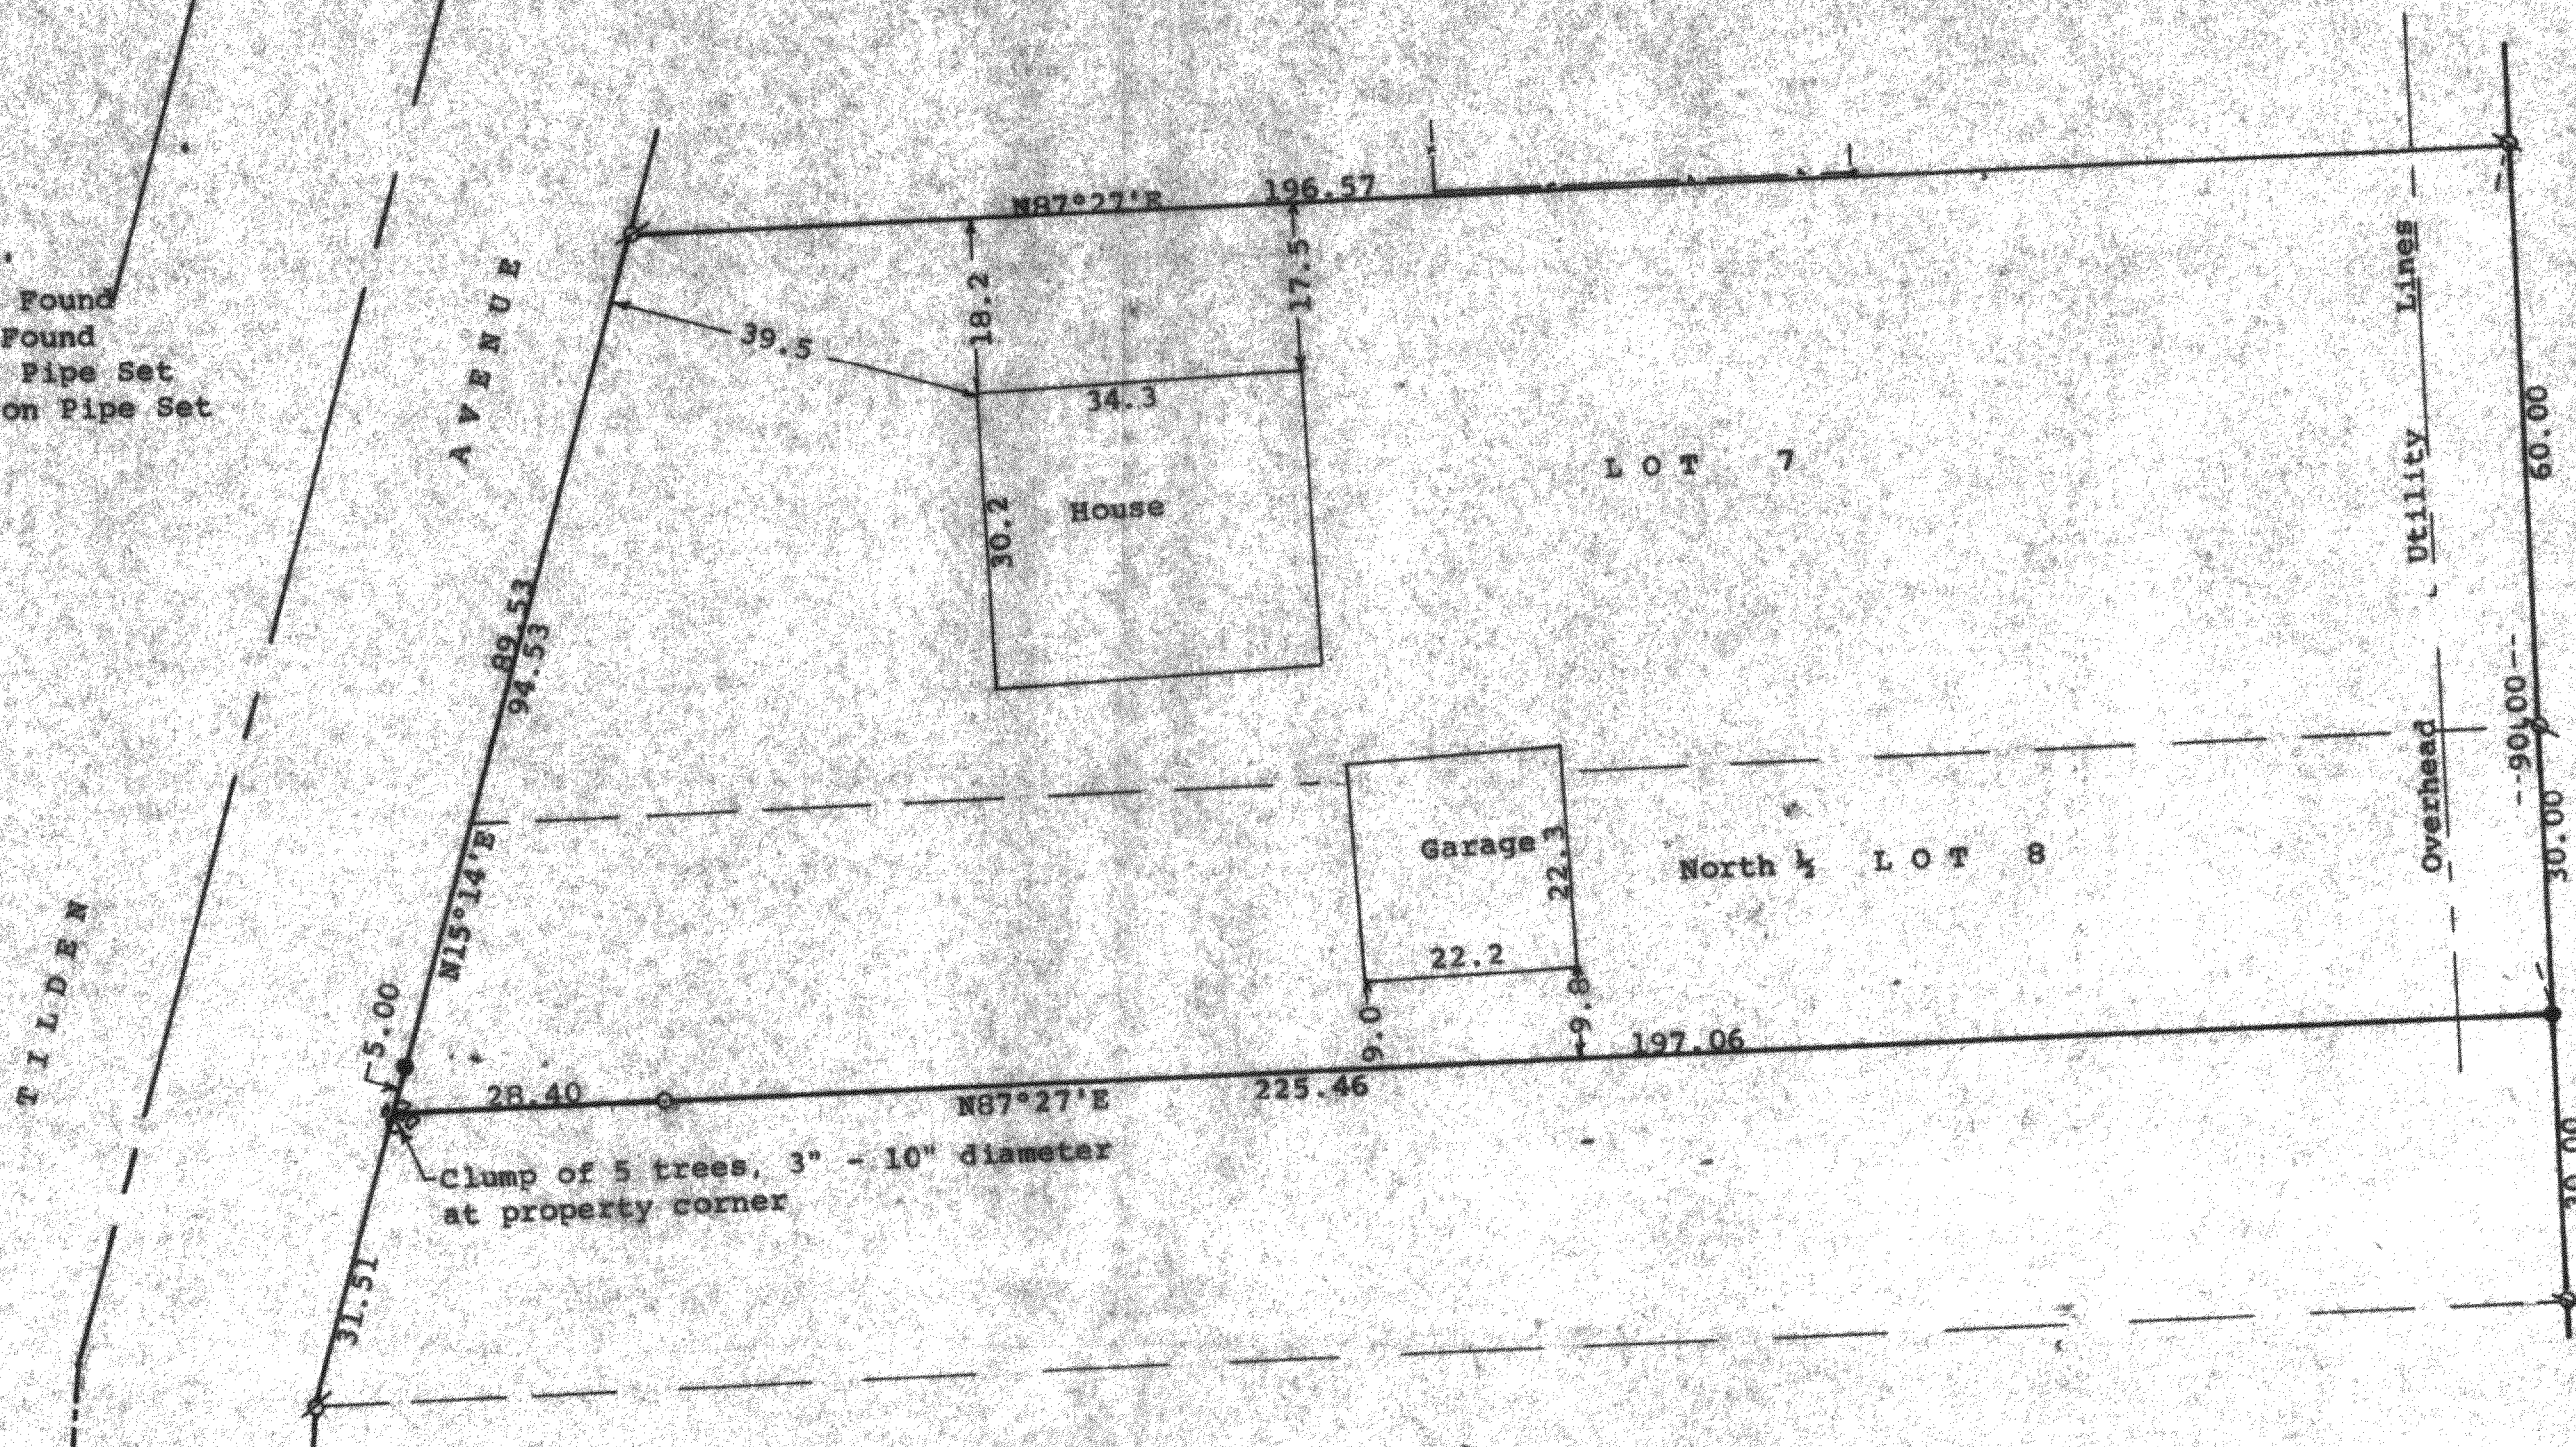

STATE OF WISCONSIN)
COUNTY OF WALWORTH) ss

I, George T. Dunham, Surveyor, certify that I have surveyed the property described as follows:

Lot 7 and the North 1/2 of Lot 8, in Block 7 of Delmar, a subdivision located in Section 27, T 2 N, R 16 E, Walworth County, Wisconsin, and that the plat shown hereon is a correct representation thereof and shows the size and location of the property, its exterior boundaries, the location of all visible structures and dimensions of all principal buildings thereon, boundary fences, apparent easements, roadways and visible encroachments, if any, and that I have surveyed the property hereon described, according to the official records, to the best of my knowledge and belief.
December 15, 1993

George T. Dunham
George T. Dunham, Surveyor

