LEMEL HOMES
Goethal


PLAT OF SURVEY

LOCATION: 2559 North Shore Drive, Delavan, Wisconsin

LEGAL DESCRIPTION: Lot 1 in **CERTIFIED SURVEY MAP NO. 2552**, located in the Southwest 1/4 of the Northwest 1/4 of Section 28, Town 2 North, Range 16 East, Town of Delevan, Walworth County, Wisconsin.

June 7, 1995

Survey No. 2117-B

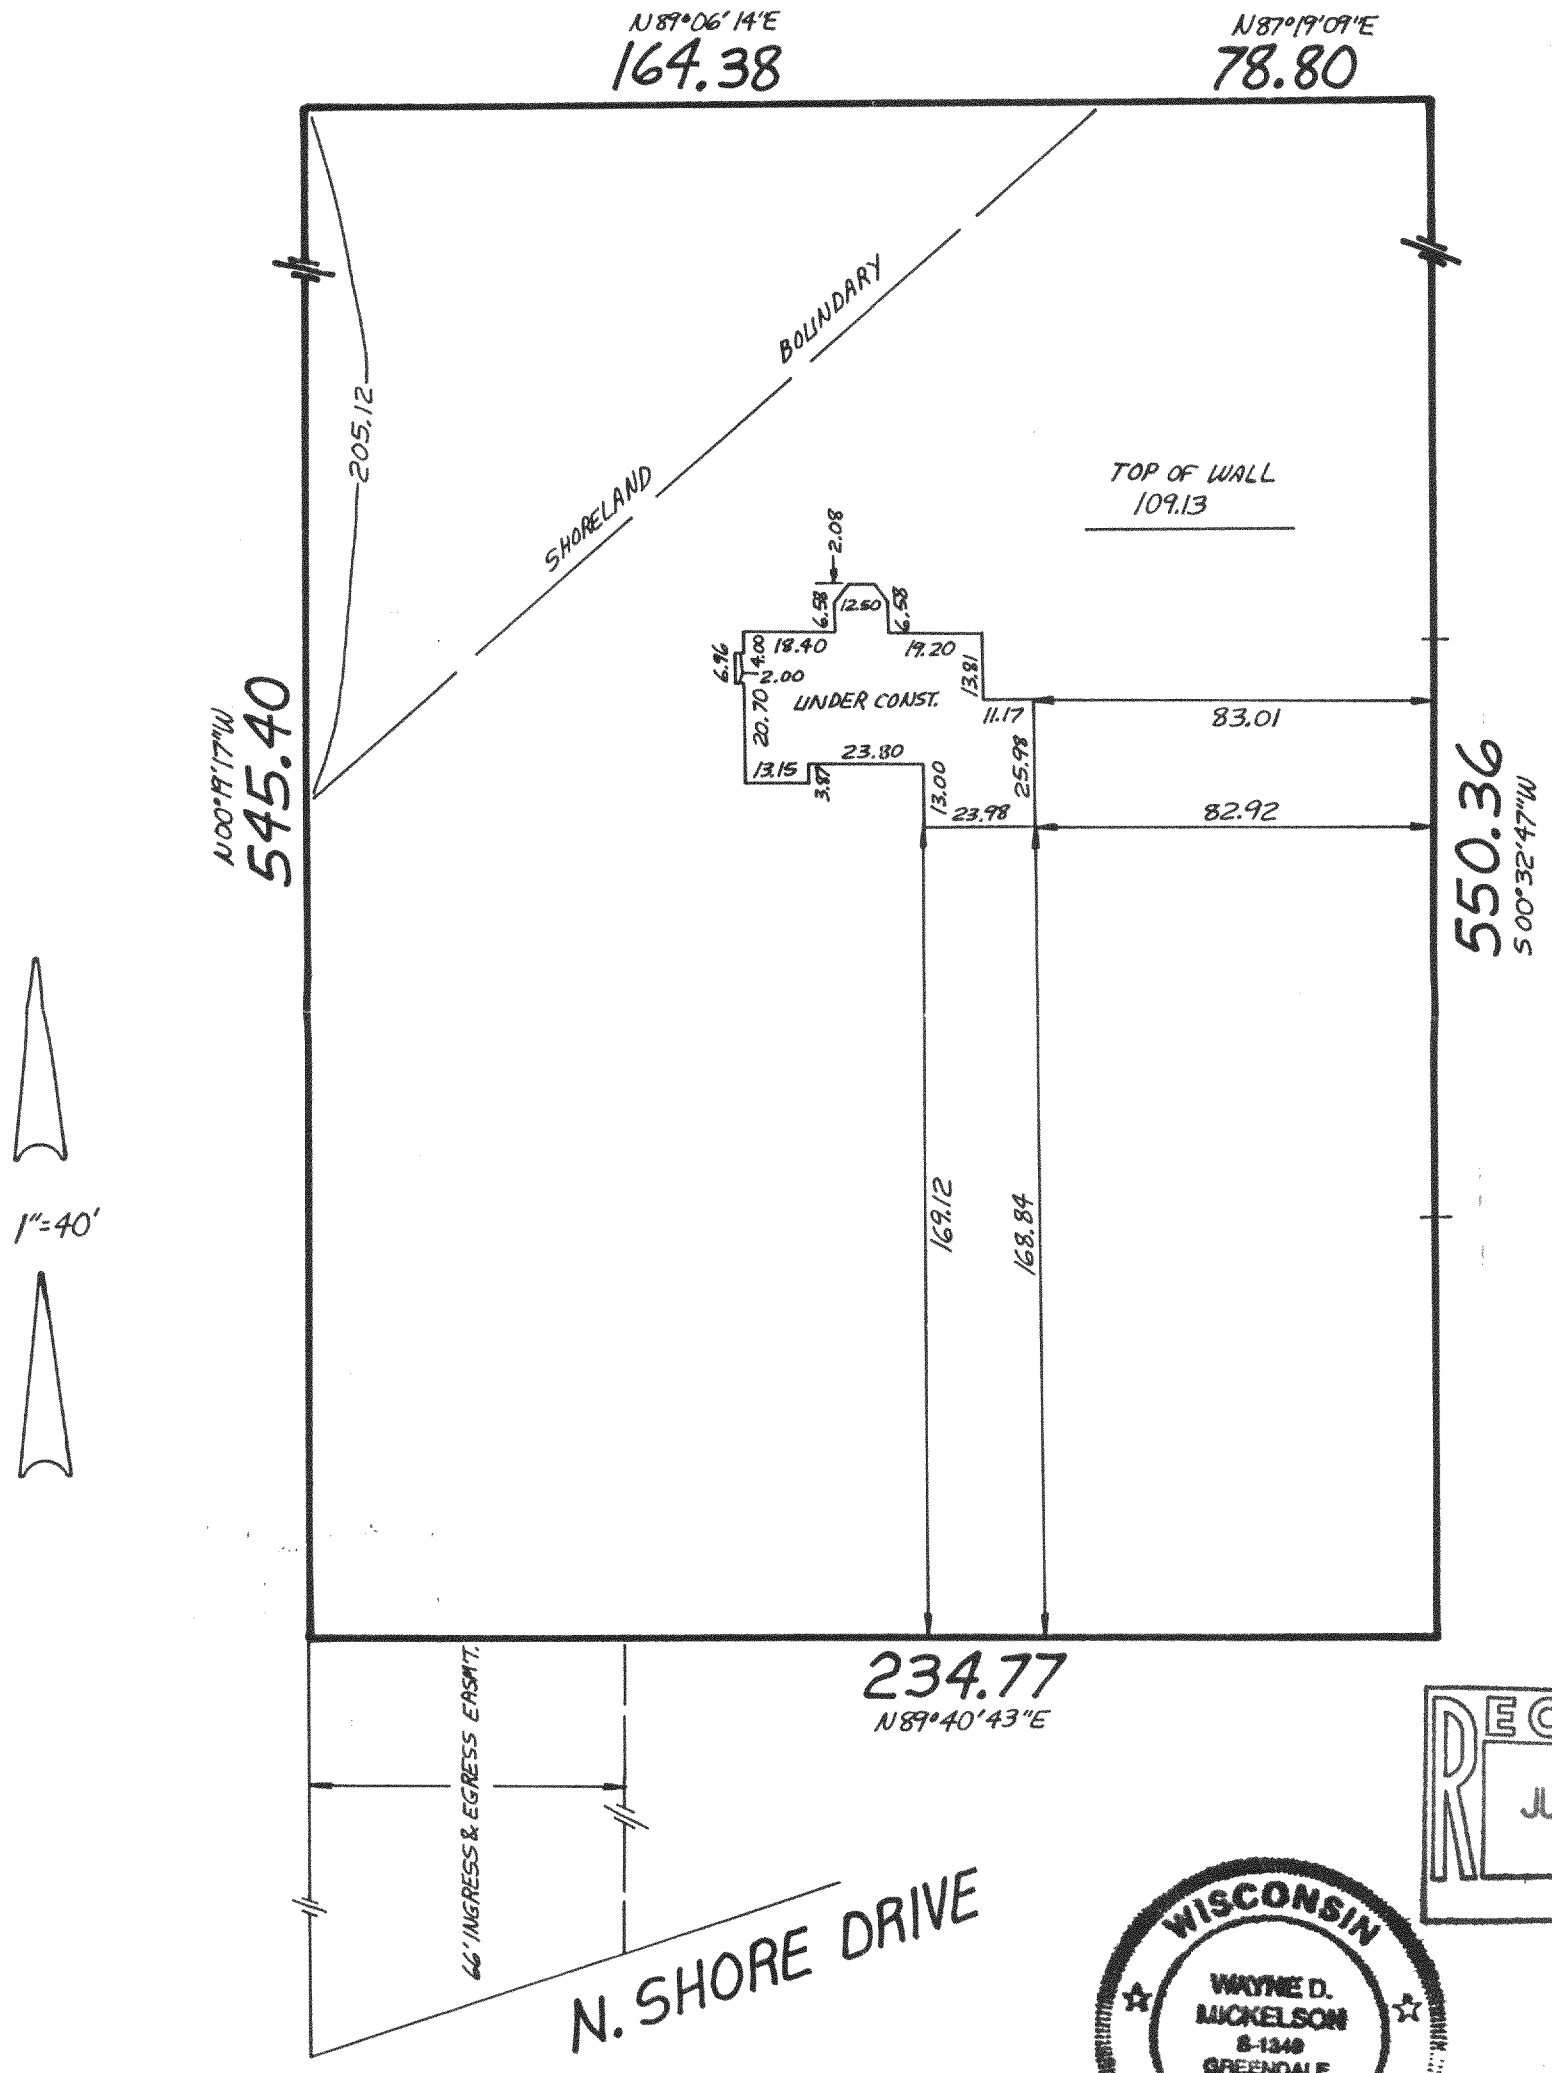

RECEIVED
JUL 21 1995

WISCONSIN
WAYNE D. MICKELSON
S-1349
GREENDALE
WI
LAND SURVEYOR

I HEREBY CERTIFY THAT I HAVE SURVEYED THE ABOVE DESCRIBED PROPERTY AND THAT THE ABOVE MAP IS A TRUE REPRESENTATION THEREOF AND SHOWS THE SIZE AND LOCATION OF THE PROPERTY, ITS EXTERIOR BOUNDARIES, THE LOCATION OF ALL VISIBLE STRUCTURES AND DIMENSIONS OF ALL PRINCIPAL BUILDINGS THEREON, BOUNDARY FENCES, APPARENT EASEMENTS AND ROADWAYS AND VISIBLE ENCROACHMENTS, IF ANY.

THIS SURVEY IS MADE FOR THE EXCLUSIVE USE OF THE PRESENT OWNERS OF THE PROPERTY, AND AI SO THOSE WHO PURCHASE, MORTGAGE, OR GUARANTEE THE TITLE THERETO WITHIN ONE (1) YEAR FROM DATE HEREOF.

SIGNED Wayne D. Mickelson

Wayne D. Mickelson
Registered Land Surveyor S-1349

METROPOLITAN ENTERPRISES, INC.
REGISTERED LAND SURVEYORS
9415 W. FOREST HOME AVE., SUITE 202, HALES CORNERS, WI 53130
PH. 529-5380 FAX 529-9787

FA-2552-1

216-2142