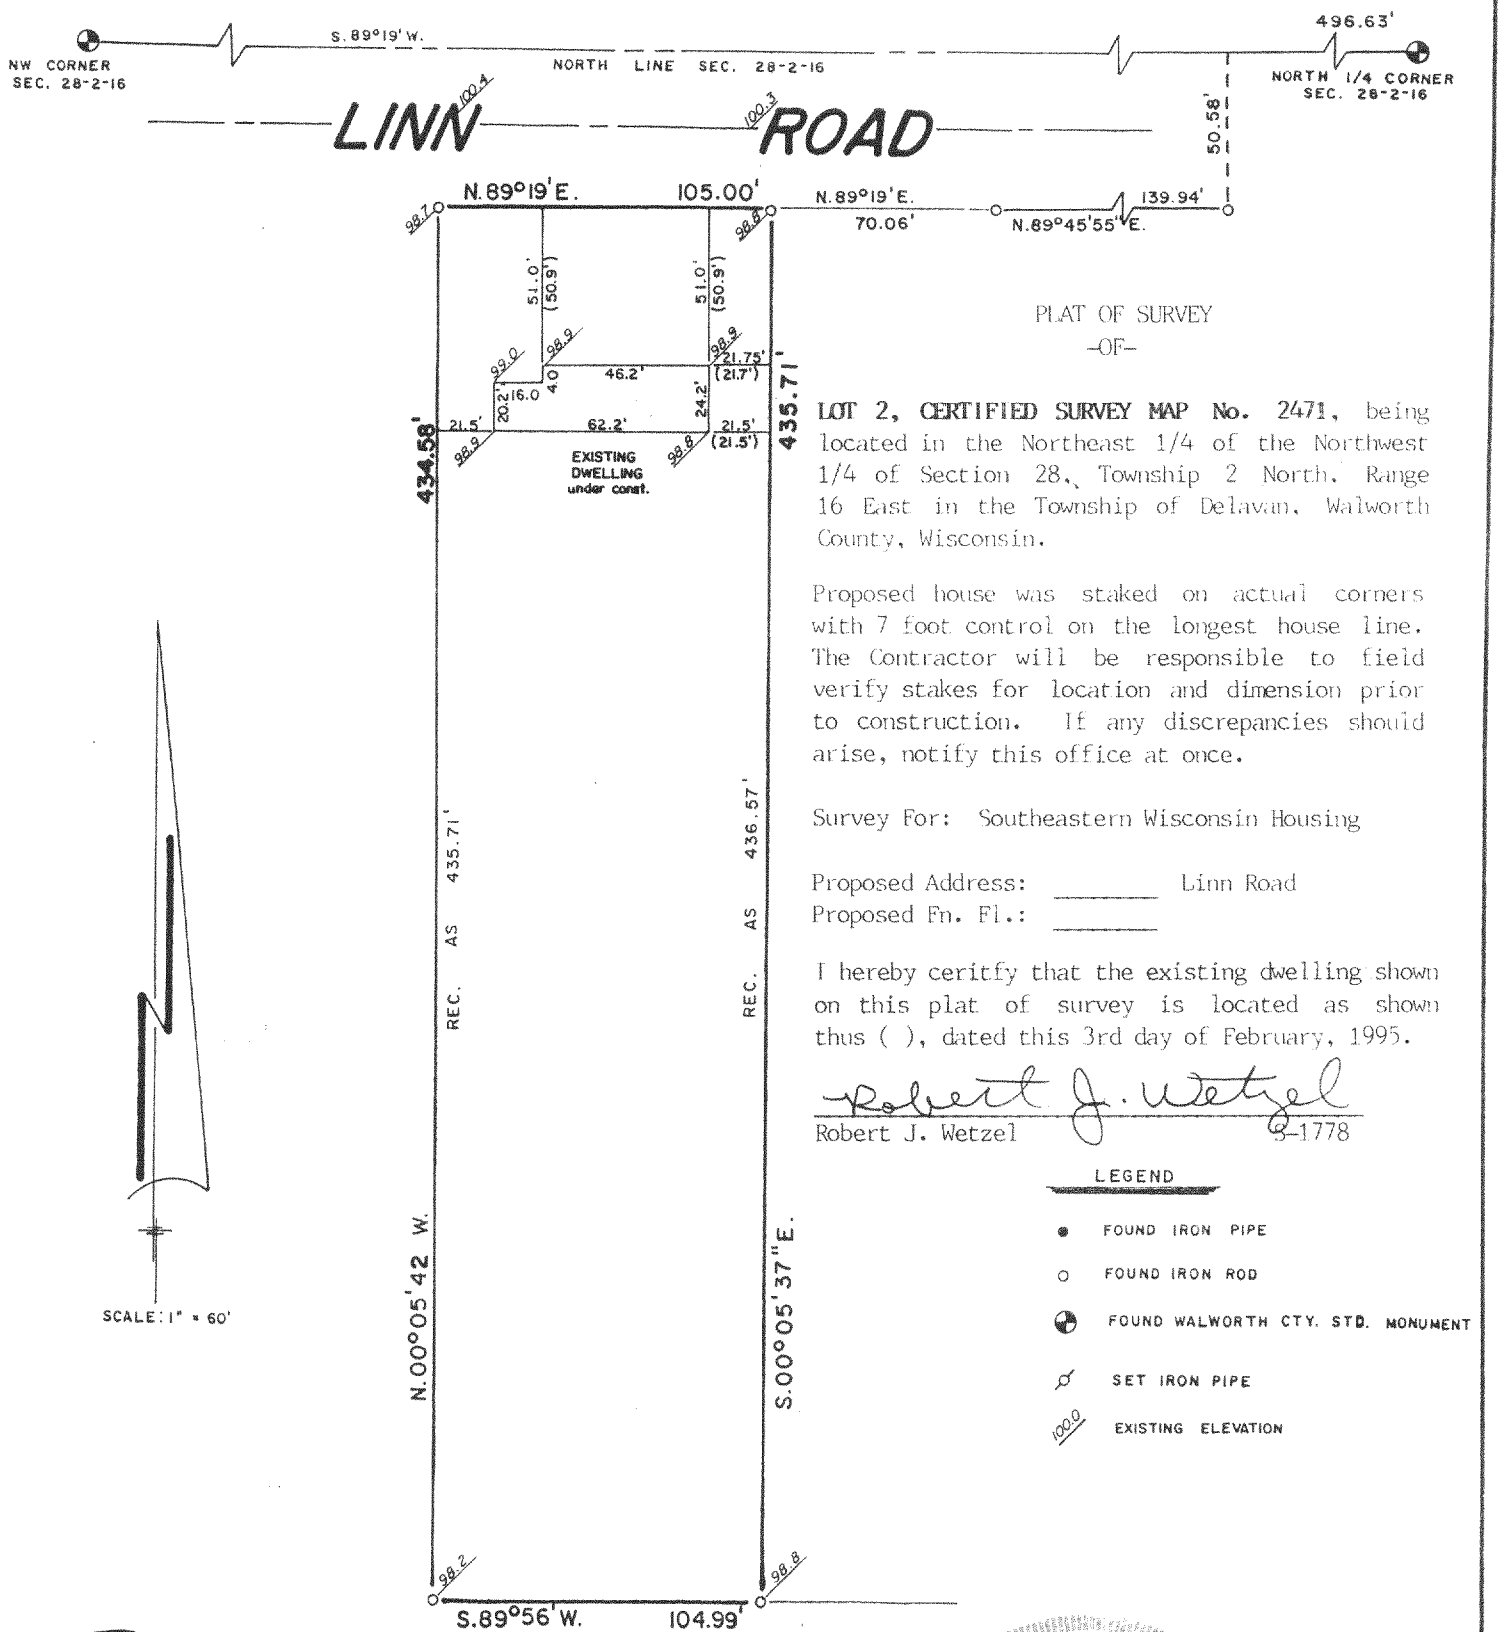

PLAT OF SURVEY
-OF-

LOT 2, CERTIFIED SURVEY MAP No. 2471, being located in the Northeast 1/4 of the Northwest 1/4 of Section 28, Township 2 North, Range 16 East in the Township of Delavan, Walworth County, Wisconsin.

Proposed house was staked on actual corners with 7 foot control on the longest house line. The Contractor will be responsible to field verify stakes for location and dimension prior to construction. If any discrepancies should arise, notify this office at once.

Survey For: Southeastern Wisconsin Housing

Proposed Address: _____ Linn Road
Proposed Fn. Fl.: _____

I hereby ceritfy that the existing dwelling shown on this plat of survey is located as shown thus ( ), dated this 3rd day of February, 1995.

Robert J. Wetzel
Robert J. Wetzel S-1778

LEGEND

- ● FOUND IRON PIPE
- ○ FOUND IRON ROD
- FOUND WALWORTH CTY. STD. MONUMENT
- SET IRON PIPE
- 100.0 EXISTING ELEVATION

B.W. SURVEYING
Land Surveys
Mapping And Planning
35117 Academy Road
Burlington, Wisconsin 53105
(414) 534-4109

RECEIVED
JUL 17 1995
ds

WISCONSIN
ROBERT J. WETZEL
S-1778
BURLINGTON
WI

THIS IS NOT AN ORIGINAL PRINT
UNLESS THIS SEAL IS RED

"I hereby certify that I have surveyed the above described property and that the above map is a true representation thereof and shows the size and location of the property, its exterior boundaries, the location of all visible structures and dimensions of all principal buildings thereon, boundary fences, apparent easements, roadways and encroachments, if any."

"This survey is made for the use of the present owners of the property, and those who purchase, mortgage, or guarantee the title thereto within one year from date hereof."

Robert J. Wetzel
ROBERT J. WETZEL
REGISTERED LAND SURVEYOR - 1778

REV.: 9/15/94 REVISED: 02/02/95

8-3-94	1796
DATE	JOB NUMBER

Rev. 9/29/94

FA-2471-2

216-2145