
PLAT OF SURVEY

LOT 8 OF GENEVA WEST ESTATES

LOCATED IN THE SOUTHEAST 1/4 OF SECTION 25, TOWN 2 NORTH, RANGE 16 EAST, WALWORTH COUNTY, WISCONSIN

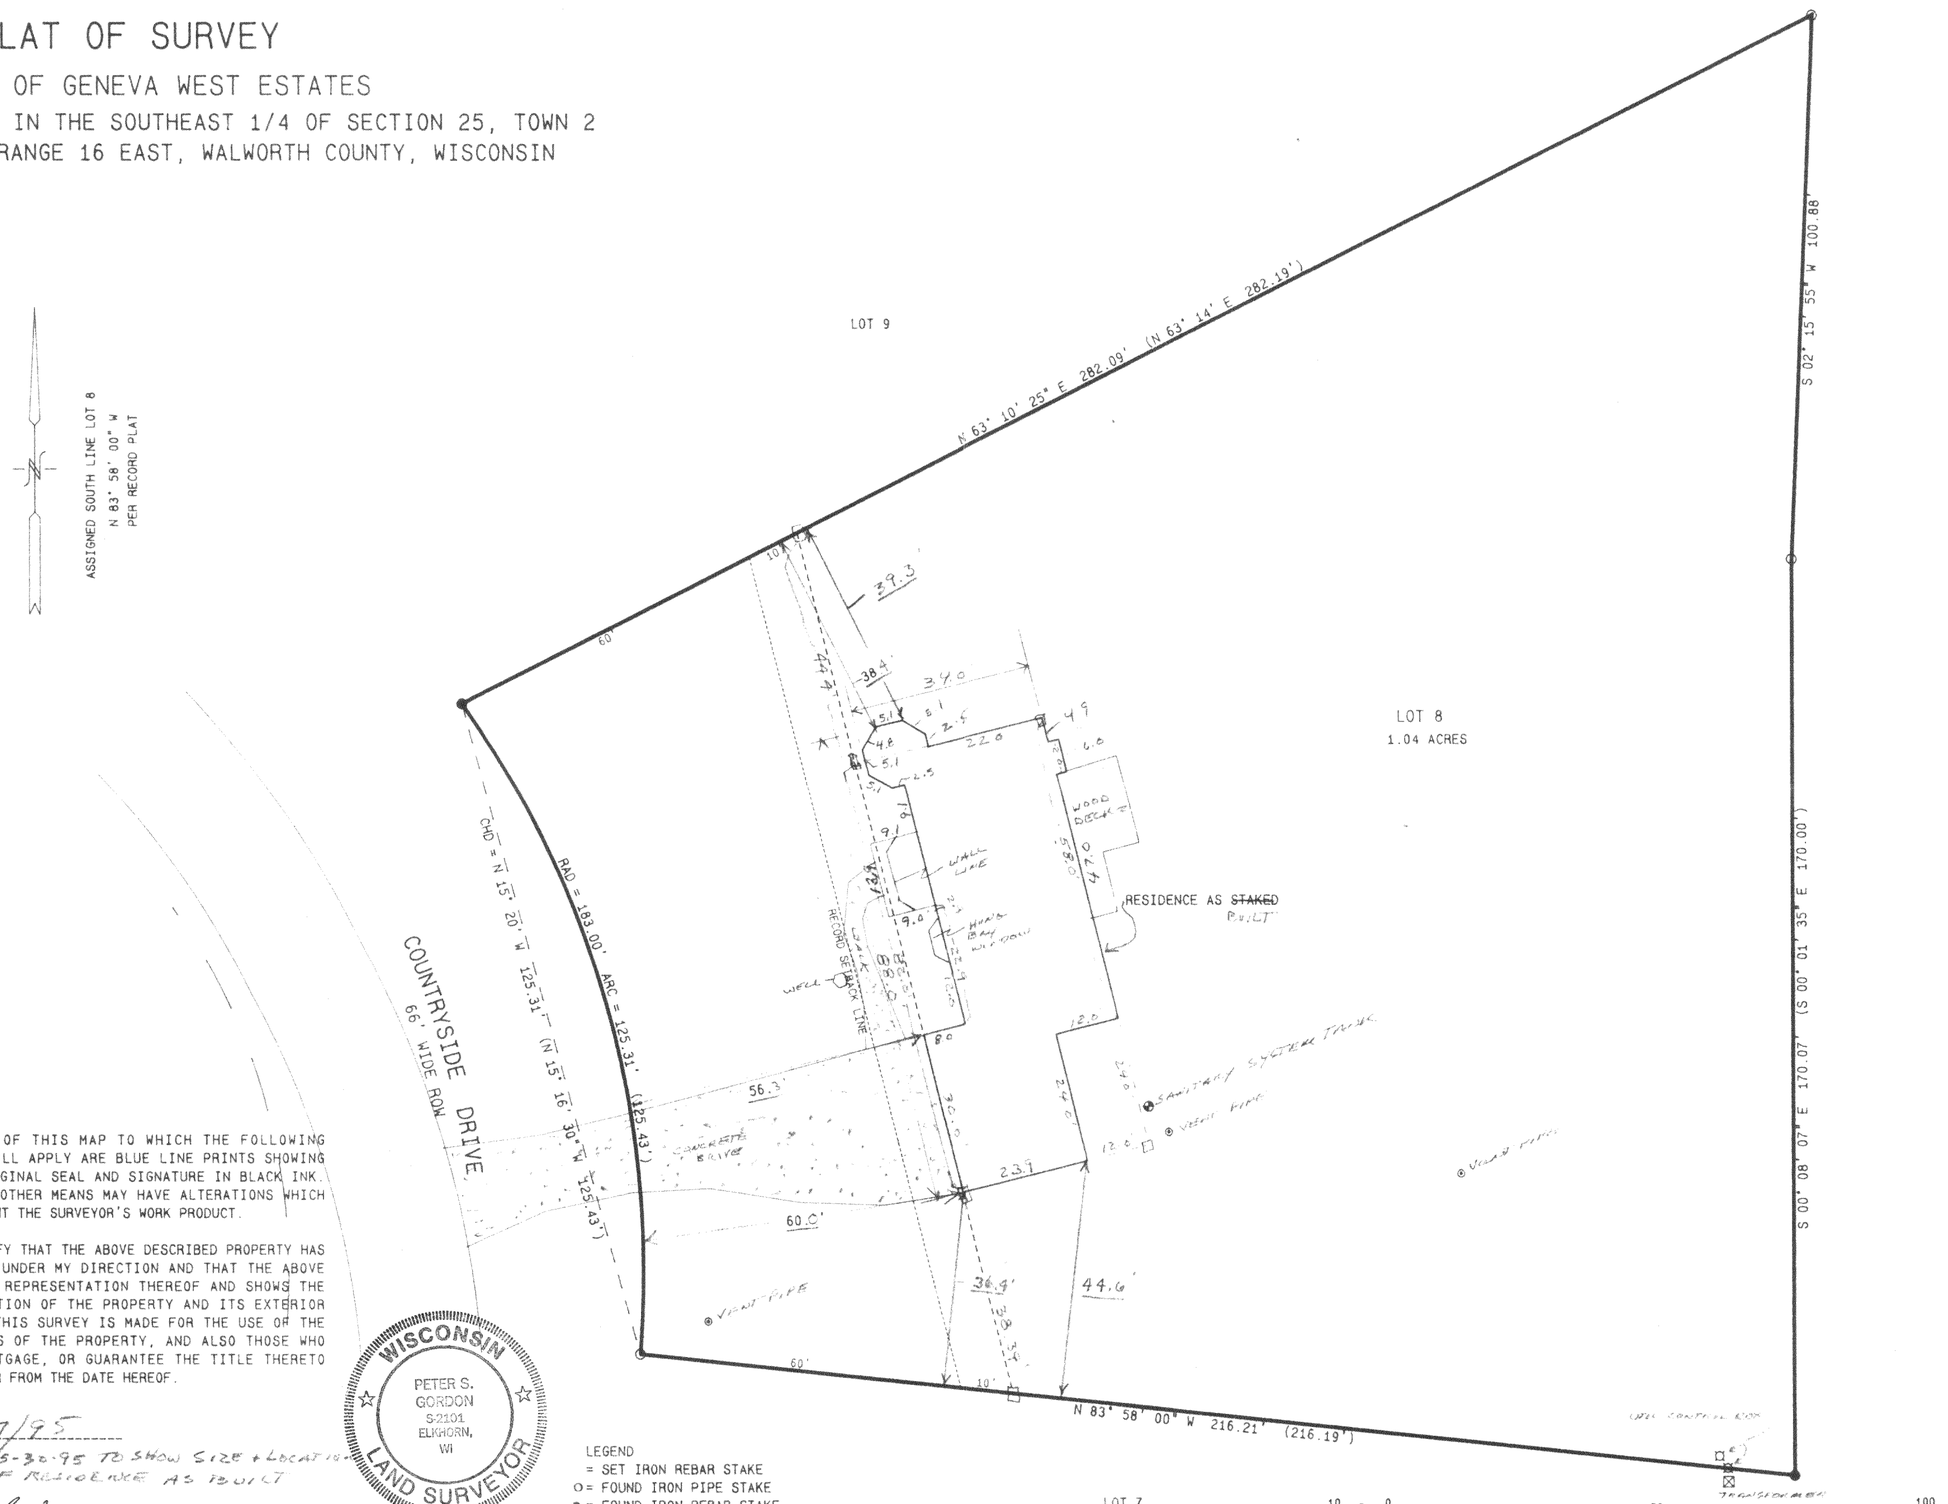

NOTE: COPIES OF THIS MAP TO WHICH THE FOLLOWING CERTIFICATE WILL APPLY ARE BLUE LINE PRINTS SHOWING SURVEYOR'S ORIGINAL SEAL AND SIGNATURE IN BLACK INK. COPIES BY ANY OTHER MEANS MAY HAVE ALTERATIONS WHICH DO NOT REPRESENT THE SURVEYOR'S WORK PRODUCT.

I HEREBY CERTIFY THAT THE ABOVE DESCRIBED PROPERTY HAS BEEN SURVEYED UNDER MY DIRECTION AND THAT THE ABOVE MAP IS A TRUE REPRESENTATION THEREOF AND SHOWS THE SIZE AND LOCATION OF THE PROPERTY AND ITS EXTERIOR BOUNDARIES. THIS SURVEY IS MADE FOR THE USE OF THE PRESENT OWNERS OF THE PROPERTY, AND ALSO THOSE WHO PURCHASE, MORTGAGE, OR GUARANTEE THE TITLE THERETO WITHIN ONE YEAR FROM THE DATE HEREOF.

DATED: 3/27/95

REVISED 5-30-95 TO SHOW SIZE + LOCATION OF RESIDENCE AS BUILT

PETER S. GORDON R.L.S. 2101

REVISED 11/7/95 TO UPDATE PHYSICAL IMPROVEMENT

WISCONSIN PETER S. GORDON S-2101 ELKHORN, WI LAND SURVEYOR

LEGEND
= SET IRON REBAR STAKE
O = FOUND IRON PIPE STAKE
● = FOUND IRON REBAR STAKE
(XXX) = RECORDED AS
XXX = AS BUILT LOCATION

RECEIVED NOV 14 1995

FGEW-8
216-2153

WORK ORDERED BY: HAP ARNOLD
SUPERB BUILDERS
5516 STATE ROAD 11
ELKHORN, WIS. 53121

FARRIS, HANSEN & ASSOCIATES, INC.
Engineering, Architecture, Surveying
7 Ridgway Court P.O. Box 437
ELKHORN, WISCONSIN 53121
Office: (414) 723-2098
Fax: (414) 723-5886

REVISIONS

PROJECT NO. 4273
DATE 03/27/95
SHEET NO. 1 OF 1