
ABELL
SURVEYING & MAPPING

DELAVAN, WISCONSIN 53115

414-728-6737

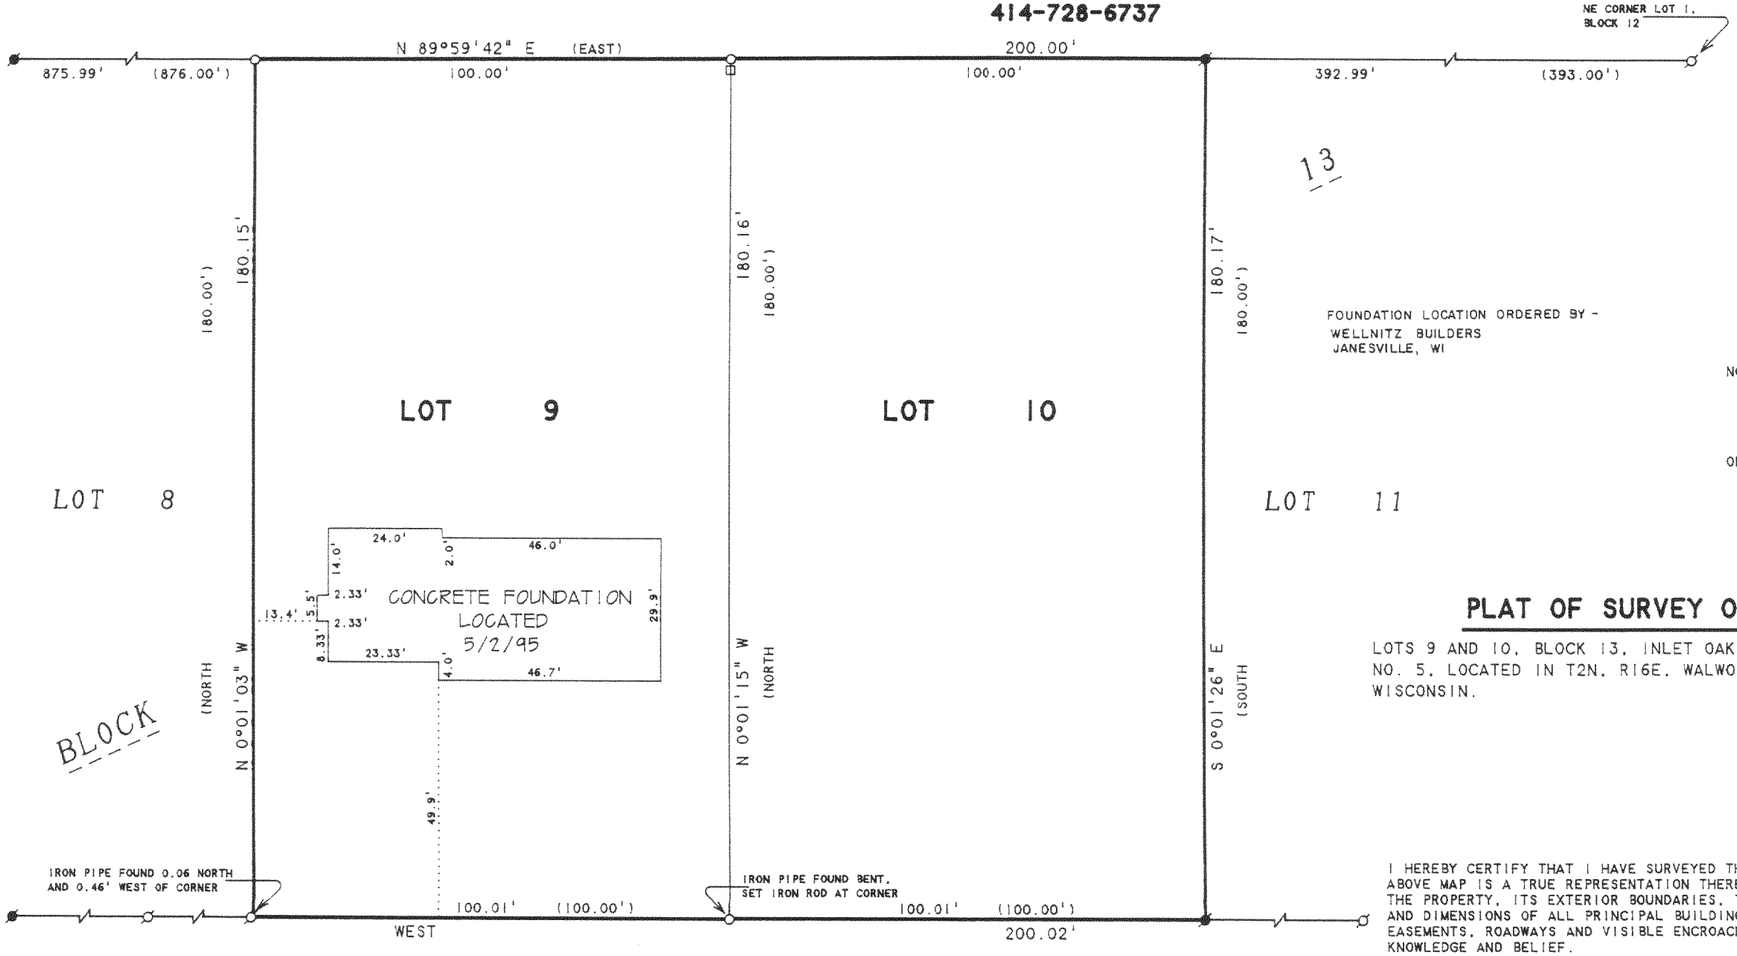

13

FOUNDATION LOCATION ORDERED BY -
WELLNITZ BUILDERS
JANESVILLE, WI

SCALE 1"=30'

LEGEND

- ⌀ -IRON PIPE FOUND
- ● -IRON ROD FOUND
- ○ -IRON ROD SET found 5/2/95
- □ -UTILITY PED.
- ( )-RECORDED AS

NOTE: BEARINGS ARE REFERENCED TO THE RECORDED SUBDIVISION PLAT.

ORDERED BY: JULIE BAKER
334 TYRRELL COURT # 8
DELAVAN, WI 53115

PLAT OF SURVEY OF

LOTS 9 AND 10, BLOCK 13, INLET OAKS SUBDIVISION NO. 5, LOCATED IN T2N, R16E, WALWORTH COUNTY, WISCONSIN.

I HEREBY CERTIFY THAT I HAVE SURVEYED THE ABOVE DESCRIBED PROPERTY AND THAT THE ABOVE MAP IS A TRUE REPRESENTATION THEREOF AND SHOWS THE SIZE AND LOCATION OF THE PROPERTY, ITS EXTERIOR BOUNDARIES, THE LOCATION OF ALL VISIBLE STRUCTURES AND DIMENSIONS OF ALL PRINCIPAL BUILDINGS THEREON, BOUNDARY FENCES, APPARENT EASEMENTS, ROADWAYS AND VISIBLE ENCROACHMENTS, IF ANY, TO THE BEST OF MY KNOWLEDGE AND BELIEF.

THIS SURVEY IS MADE FOR THE USE OF THE PRESENT OWNERS OF THE PROPERTY, AND ALSO THOSE WHO PURCHASE, MORTGAGE, OR GUARANTEE THE TITLE THERETO WITHIN ONE (1) YEAR FROM DATE HEREON.

David F. Abell

DAVID F. ABELL
WISCONSIN REGISTERED LAND SURVEYOR, S-1596

March 14, 1995 — REVISED DATE MAY 3, 1995

DATE — JOB NUMBER - 95023

NOTE: THIS IS NOT A CERTIFIED COPY UNLESS SEALED.

RECEIVED
OCT 9 1995

FINS-35
FINS-36

216-2193