
GEORGE T. DUNHAM
SURVEYING & SUBDIVIDING
DELAVAN, WISCONSIN

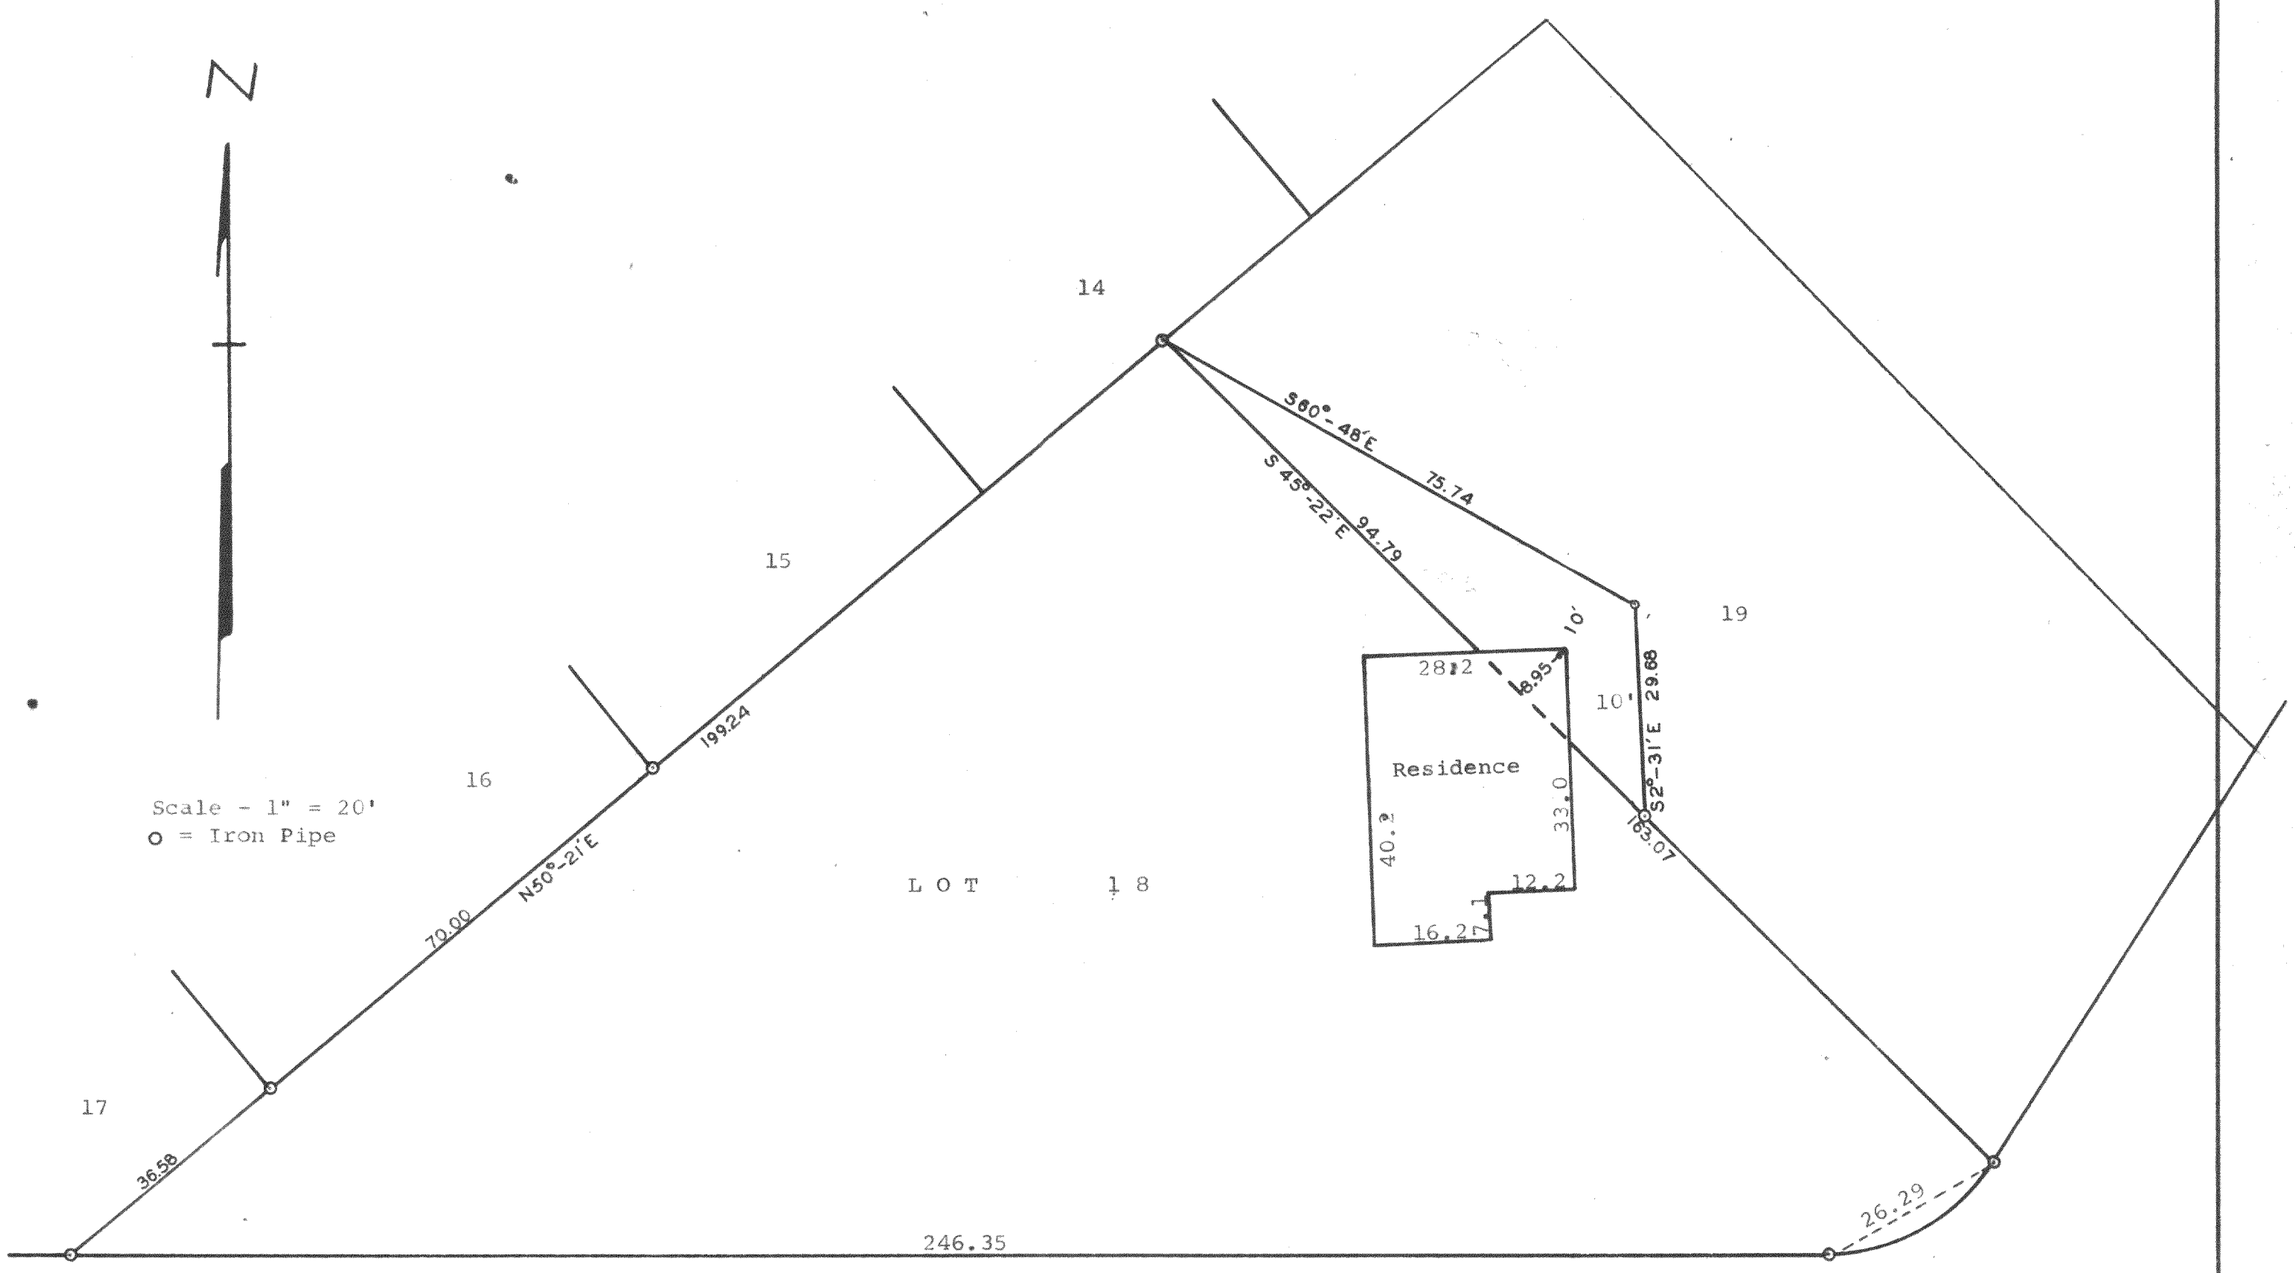

Plat of survey of Lot 18, Block 2, Delmar Subdivision located in Section 27, T 2 N, R 16 E, Walworth County, Wisconsin
August 23, 1966
Revised May 1967
Revised 7/21/67 George T. Dunham, Surveyor

(RVD)

FDM-12B

K & E 10-5155—250-8-64

216-220