


DUNHAM SURVEYING, S.C.
SURVEYING & SUBDIVIDING
DELAVER, WISCONSIN 53115

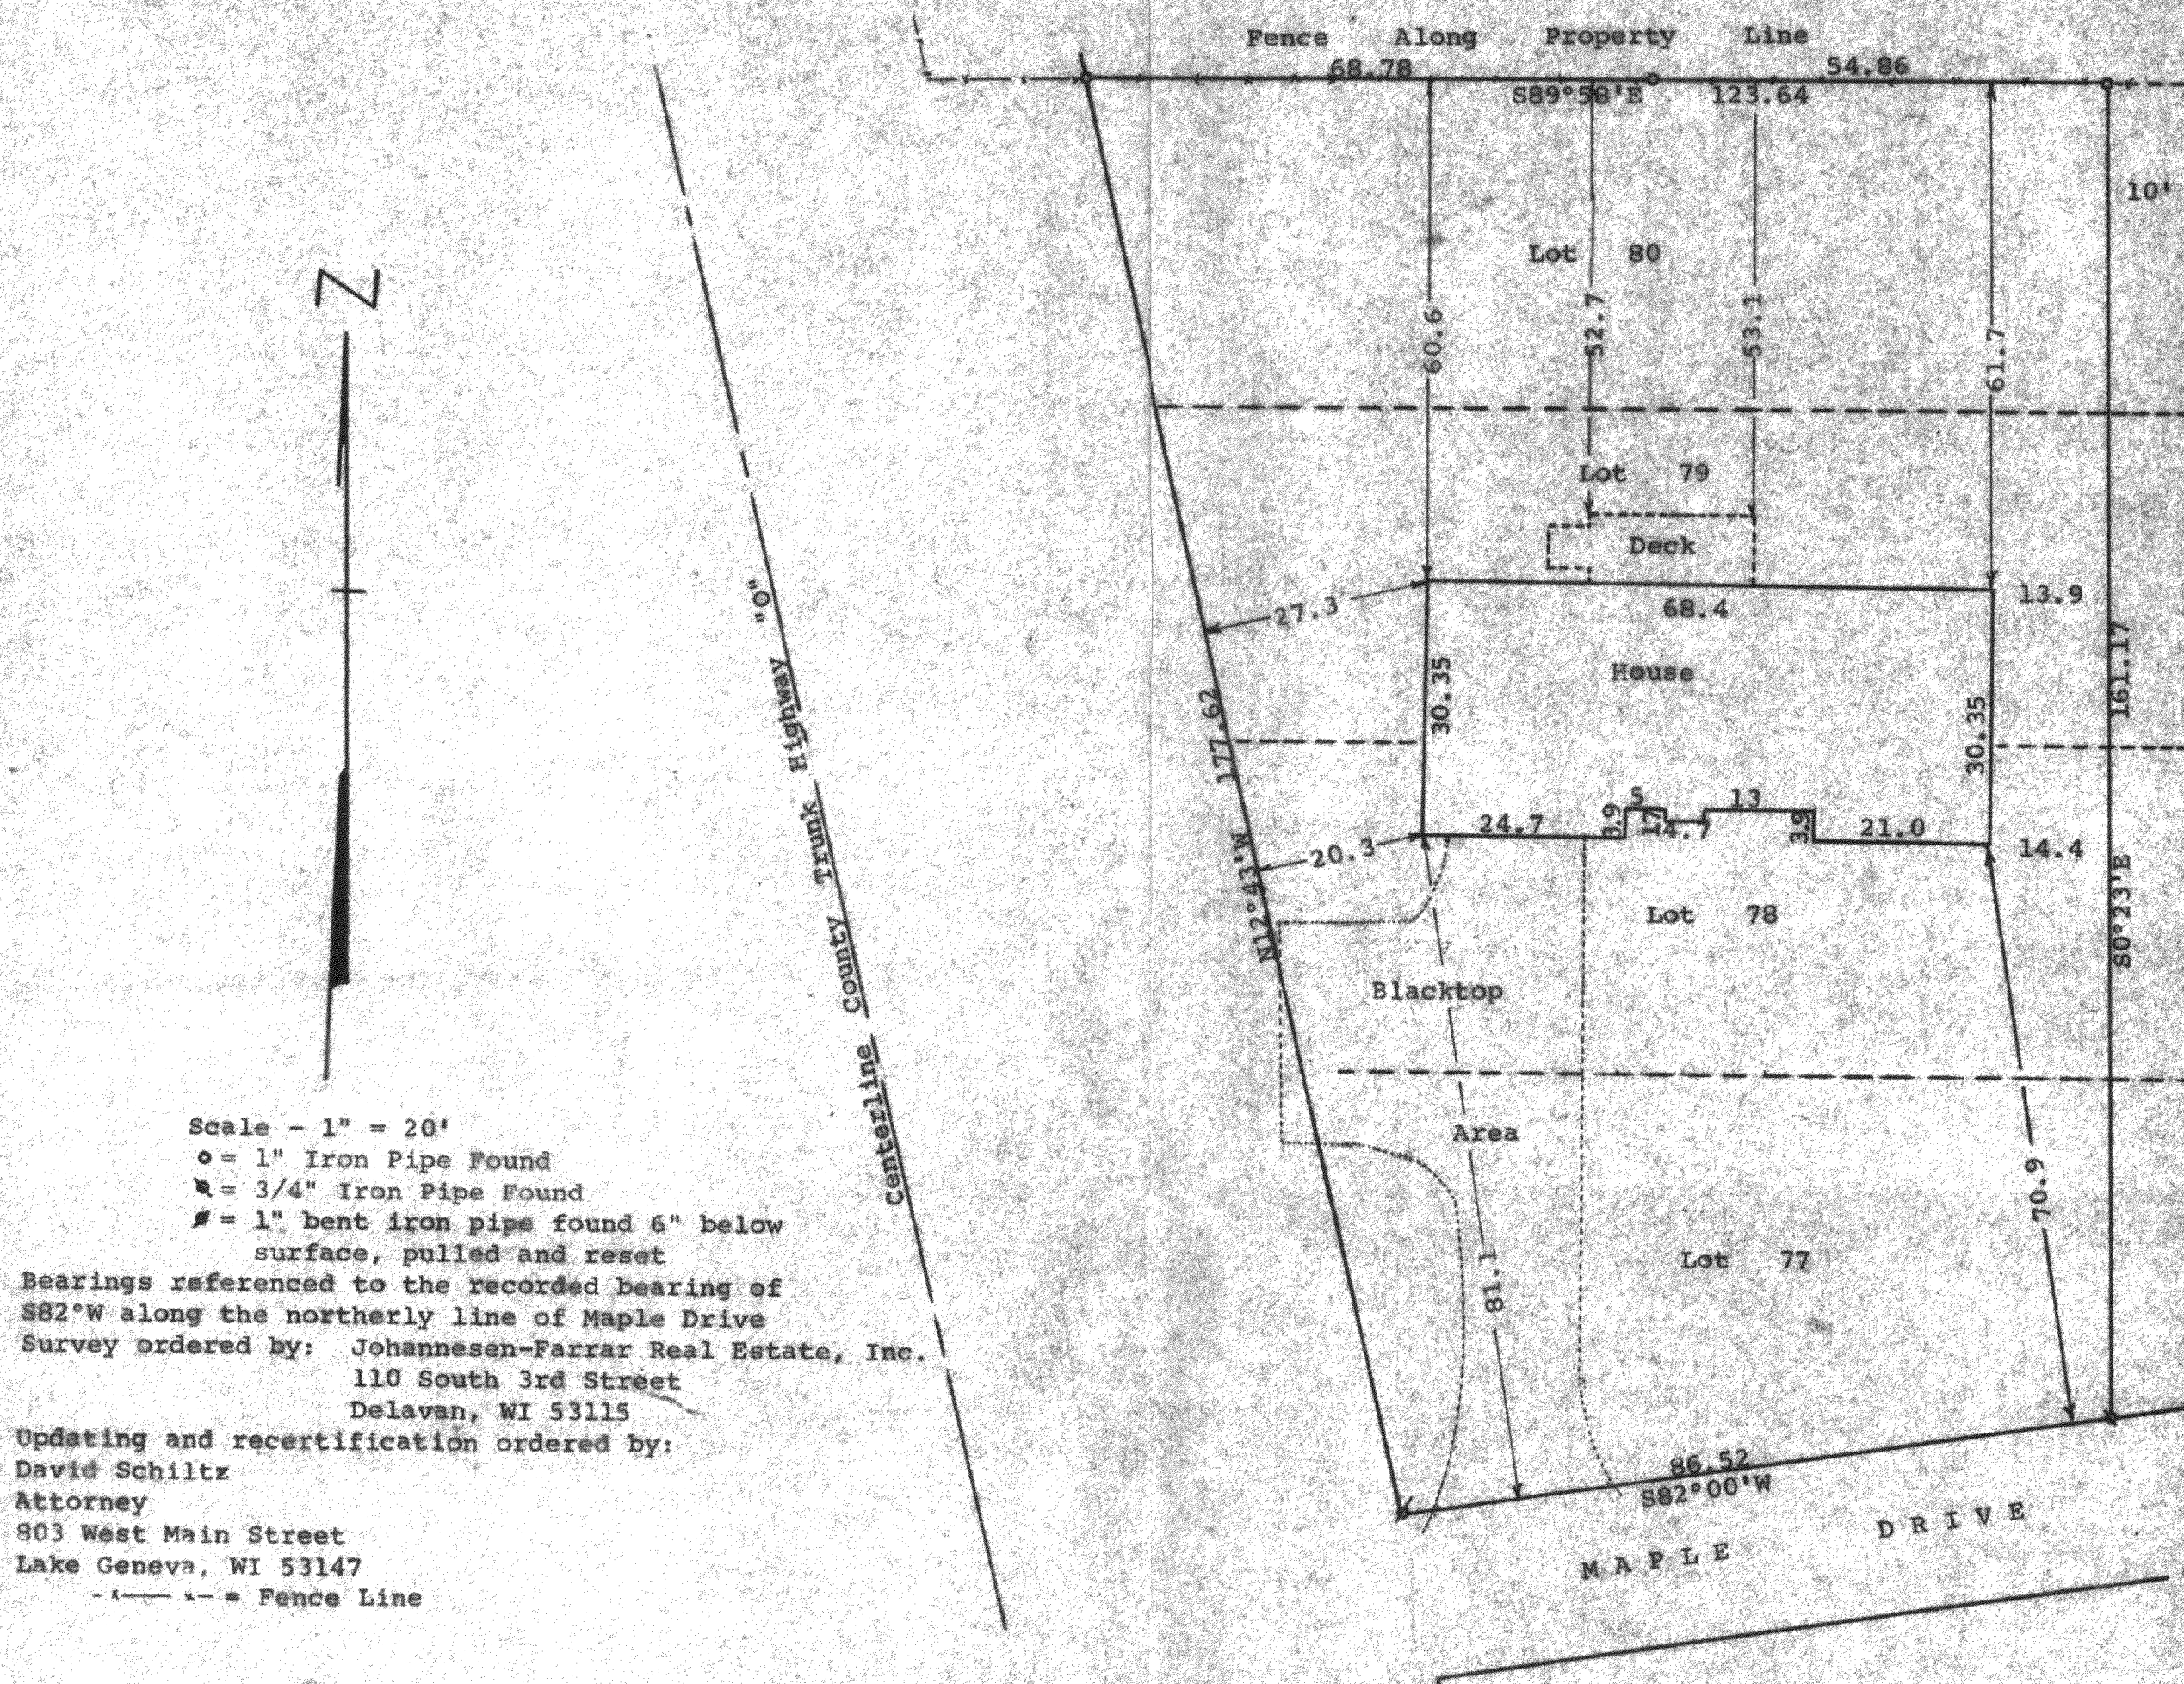

STATE OF WISCONSIN) ss
COUNTY OF WALWORTH)

I, George T. Dunham, Surveyor, certify that I have surveyed the property described as follows:

Lots 77, 78, 79, and 80 in Krumhaar's 3rd Addition to Ravenswood, a subdivision located in Section 31, T 2 N, R 16 E, Walworth County, Wisconsin, EXCEPTING therefrom the East 10.00 feet of said lots and also excepting the Westerly 17.00 feet of said lots.

and that the map shown above is a true representation thereof and shows the size and location of the property, its exterior boundaries, the location of all visible structures and dimensions of all principal buildings thereon, boundary fences, apparent easements, roadways and visible encroachments, if any, and that I have surveyed the property hereon described according to the official records, to the best of my knowledge and belief.

November 8, 1993

Updated and recertified to this

20th day of October, 1995

Updated January 16, 1996

George T. Dunham
George T. Dunham, Surveyor

