
DUNHAM SURVEYING, S.C.
SURVEYING & SUBDIVIDING
DELAVAN, WISCONSIN 53115

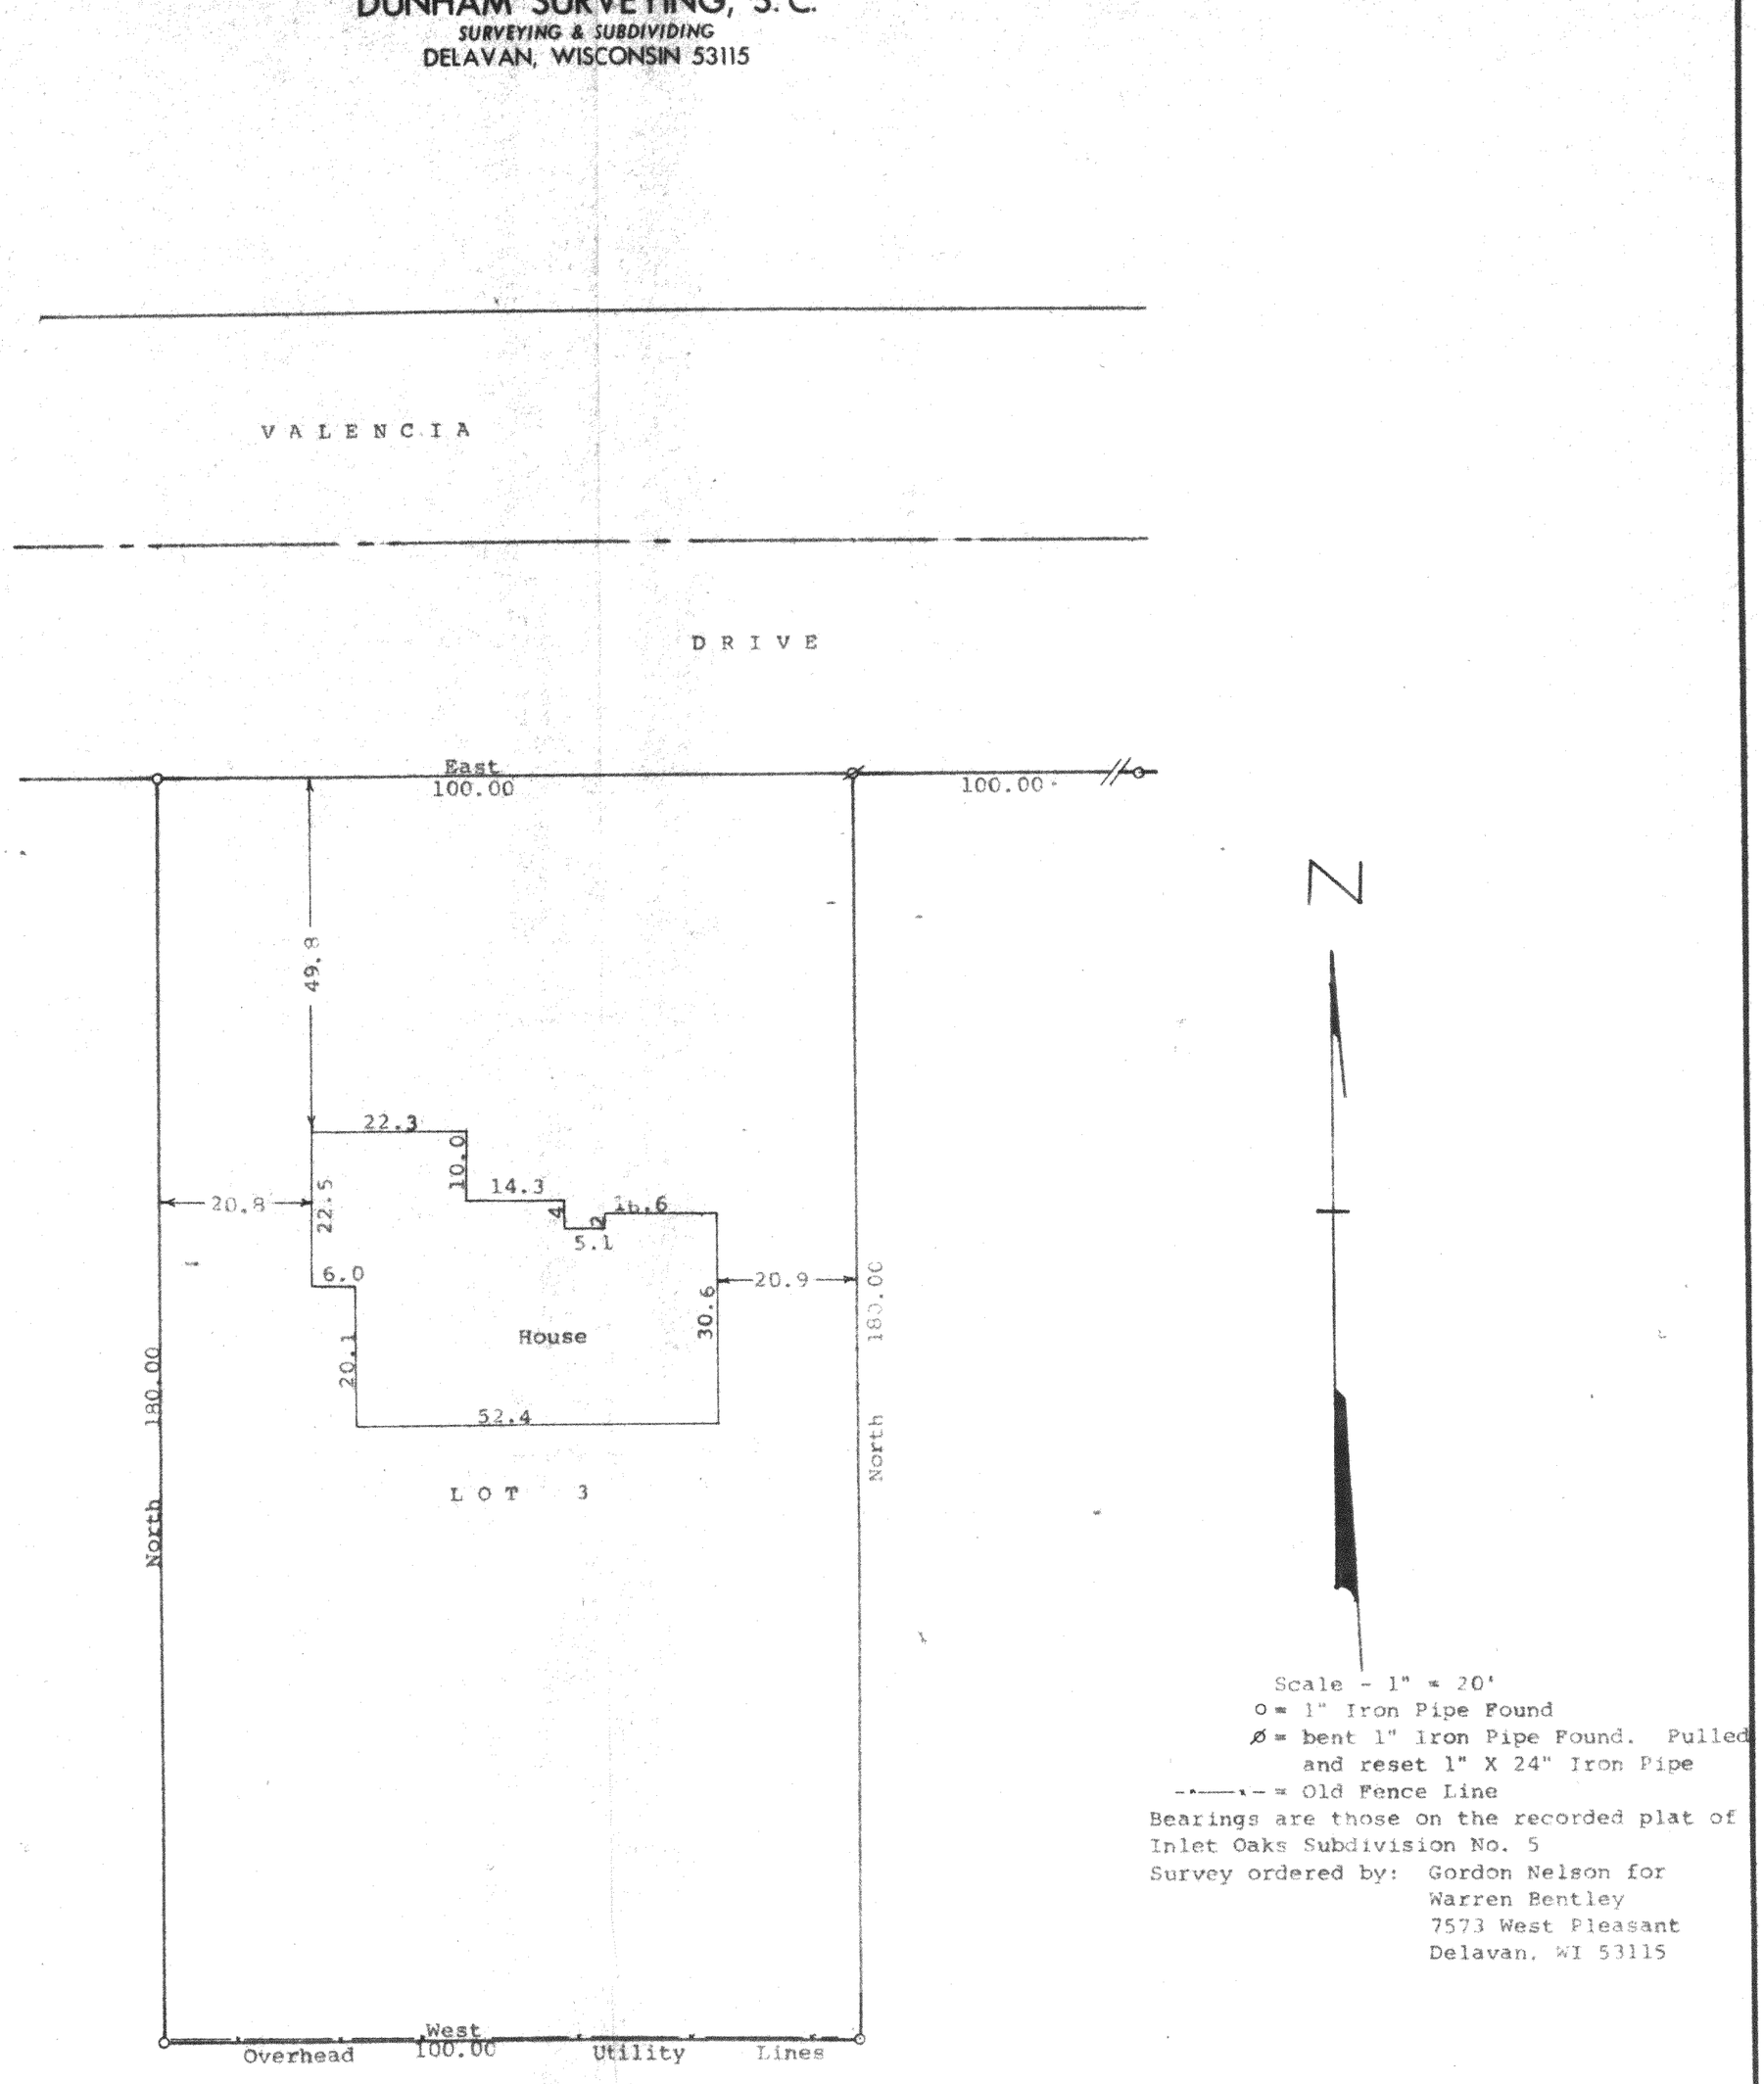

STATE OF WISCONSIN)
COUNTY OF WALWORTH) SS

I, George T. Dunham, Surveyor, certify that I have surveyed the property described as follows:

Lot 3 in Block 10 of Inlet Oaks Subdivision No. 5, located in Section 15, T 2 N, R 16 E, Walworth County, Wisconsin.

and that the plat shown hereon is a correct representation thereof and shows the size and location of the property, its exterior boundaries, the location of all visible structures and dimensions of the proposed house to be built thereon; apparent easements, roadways and visible encroachments, if any, and that I have surveyed theproperty hereon described, according to the official records, to the best of my knowledge and belief.

September7, 1994
Revised September 24, 1994
Updated to show location of new house
and recertified to this 12th day of
September, 1995

George T. Dunham, Surveyor

WISCONSIN
GEORGE T. DUNHAM
S-306
DELAVAN WIS.
LAND SURVEYOR

RECEIVED
AUG 12 1996

FINS-3

216-2303