
DUNHAM SURVEYING, S.C.

SURVEYING & SUBDIVIDING
DELAVAN, WISCONSIN 53115

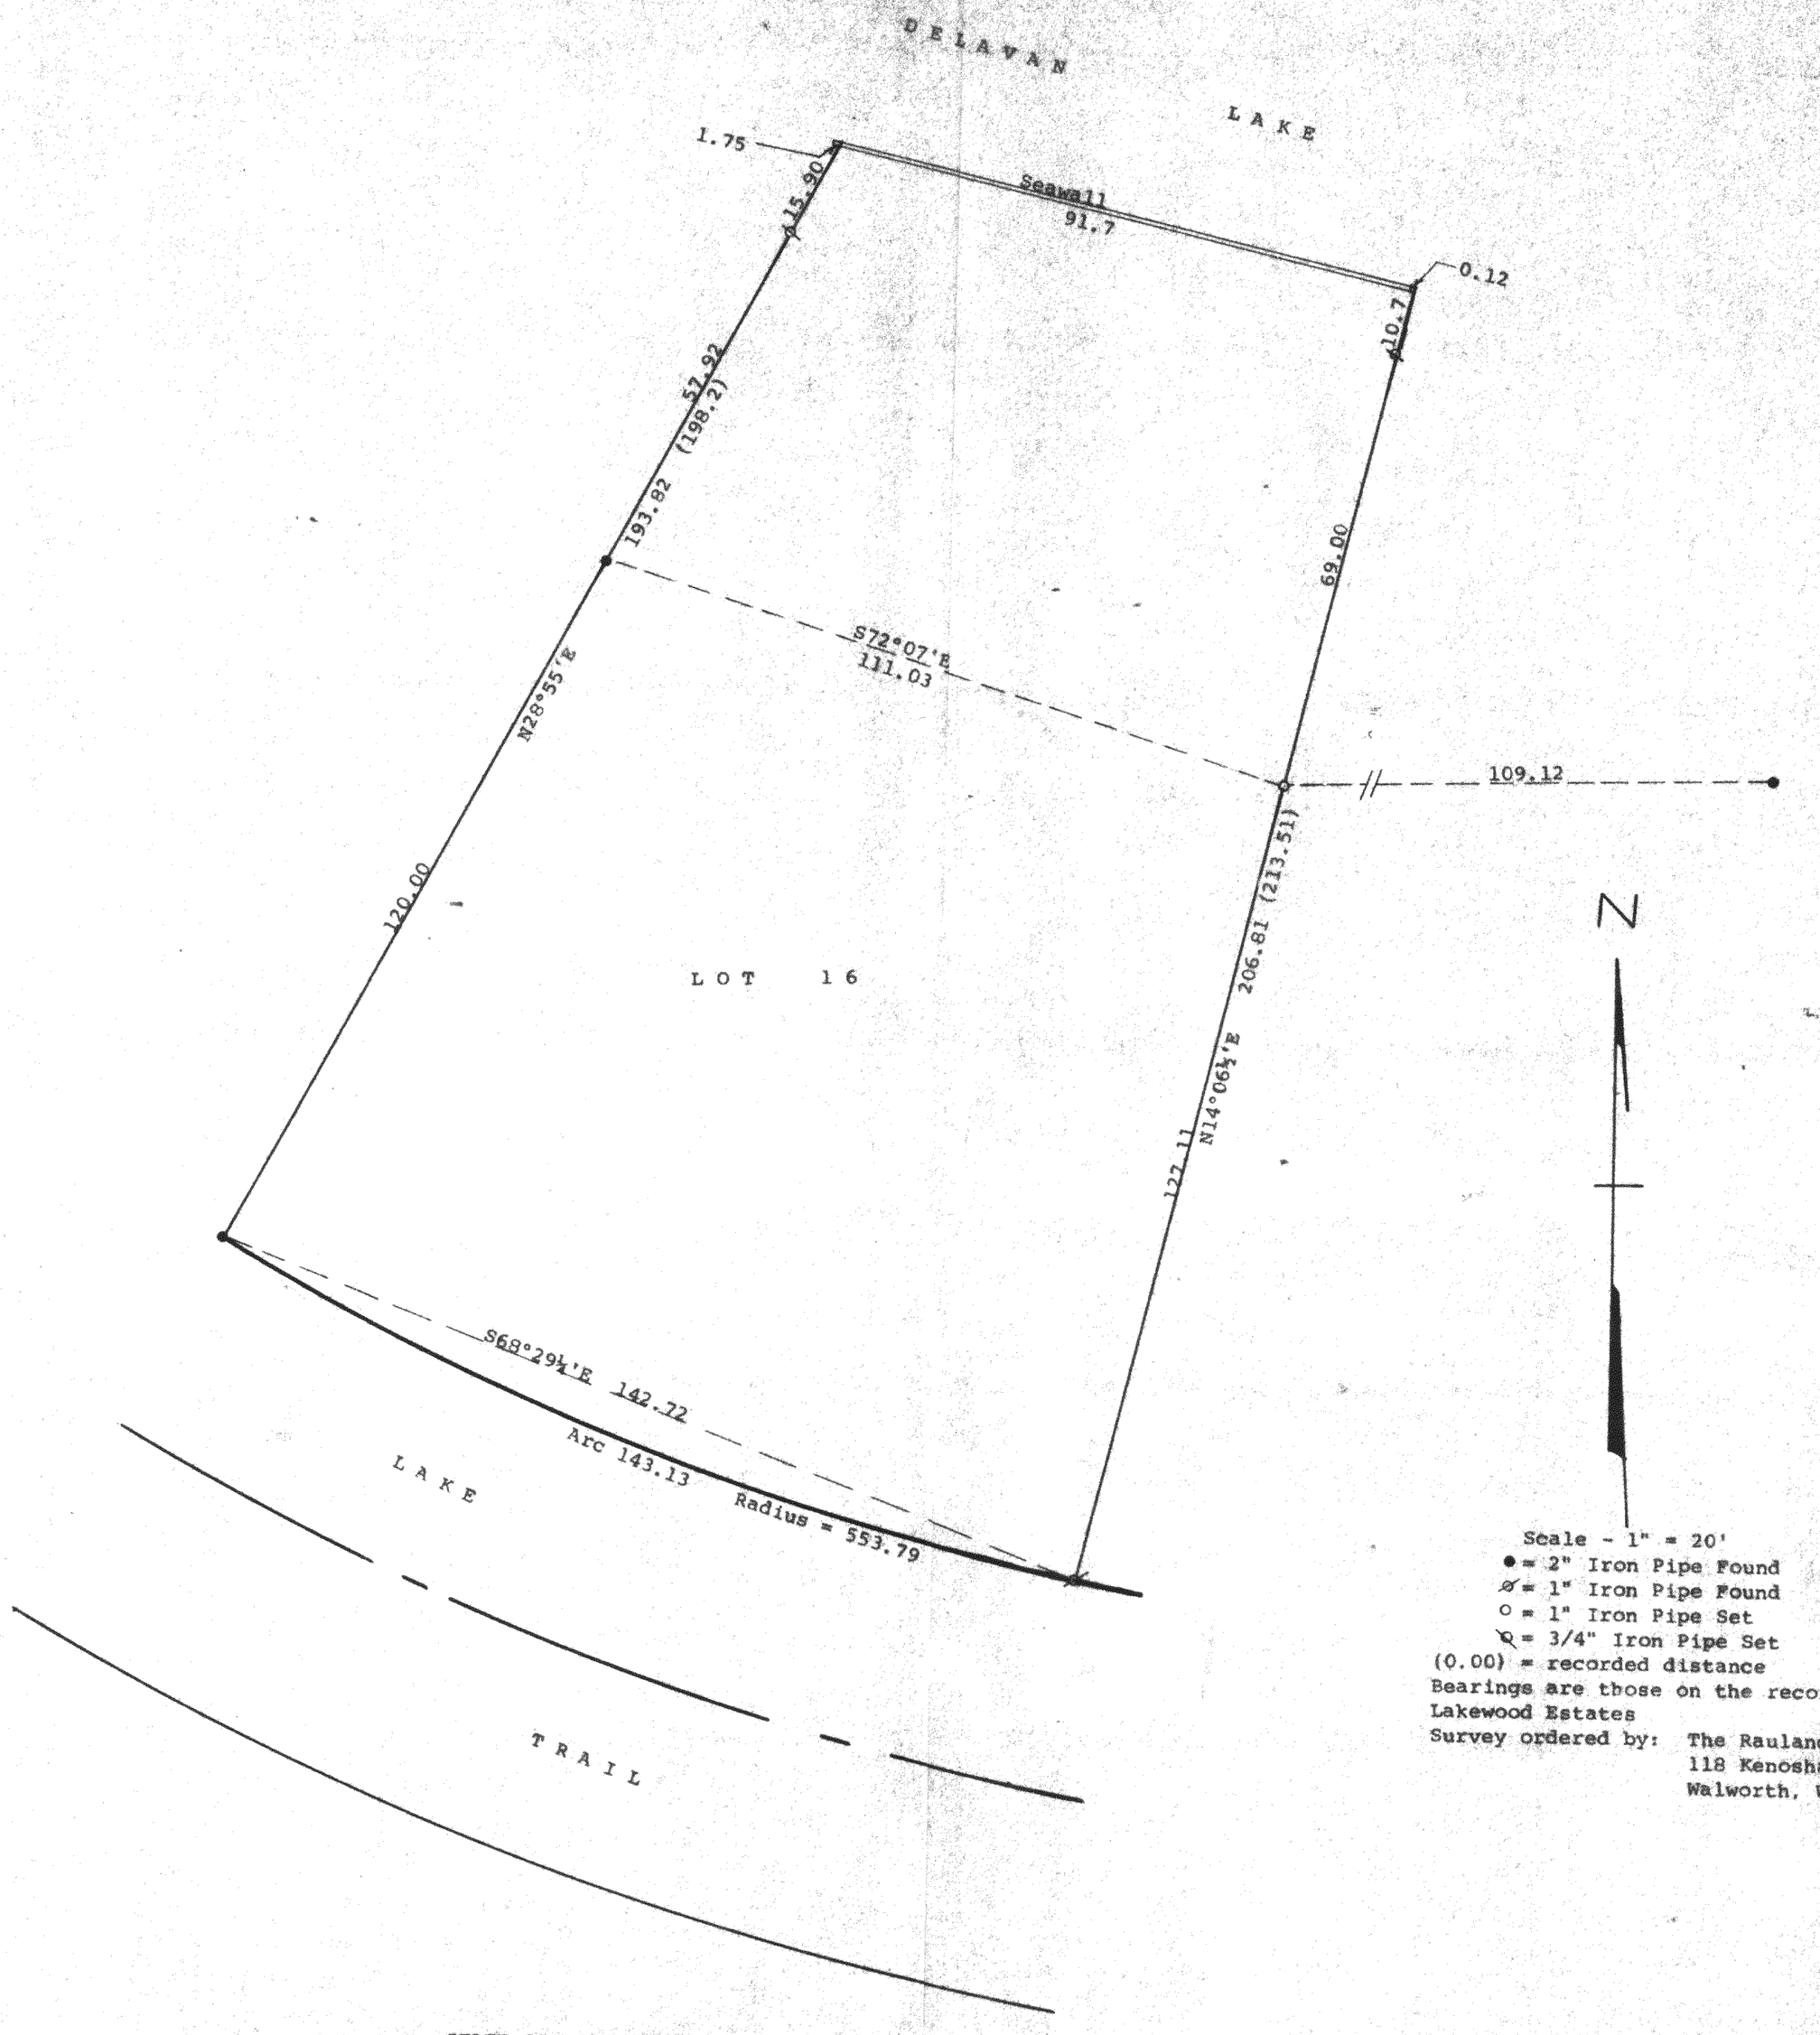

Scale - 1" = 20'
● = 2" Iron Pipe Found
⌀ = 1" Iron Pipe Found
○ = 1" Iron Pipe Set
⌀ = 3/4" Iron Pipe Set
(0.00) = recorded distance
Bearings are those on the recorded plat of Lakewood Estates
Survey ordered by: The Rauland Agency
118 Kenosha Street
Walworth, WI 53184

STATE OF WISCONSIN)
SS
COUNTY OF WALWORTH)

I, George T. Dunham, Surveyor, certify that I have surveyed the property described as follows:

Lot 16 in Lakewood Estates, a subdivision located Section 21, T 2 N, R 16 E, Walworth County, Wisconsin

and that the plat shown hereon is a correct representation thereof and shows the size and location of the property, its exterior boundaries, the location of all visible structures and dimensions of all principal buildings thereon, boundary fences, apparent easements, roadways and visible encroachments, if any, and that I have surveyed the property hereon described, according to the official records, to the best of my knowledge and belief.
June 14, 1995

George T. Dunham, Surveyor

WISCONSIN
GEORGE T. DUNHAM
S-306
DELAVAN WIS.
LAND SURVEYOR

RECEIVED
AUG 12 1996

FLE-16
216-2307

645273

GMB 1020