
ABELL
SURVEYING & MAPPING

1140 SEQUOIA STREET • DELAVAN, WISCONSIN 53115
414-728-6737

RECEIVED
SEP 11 1997

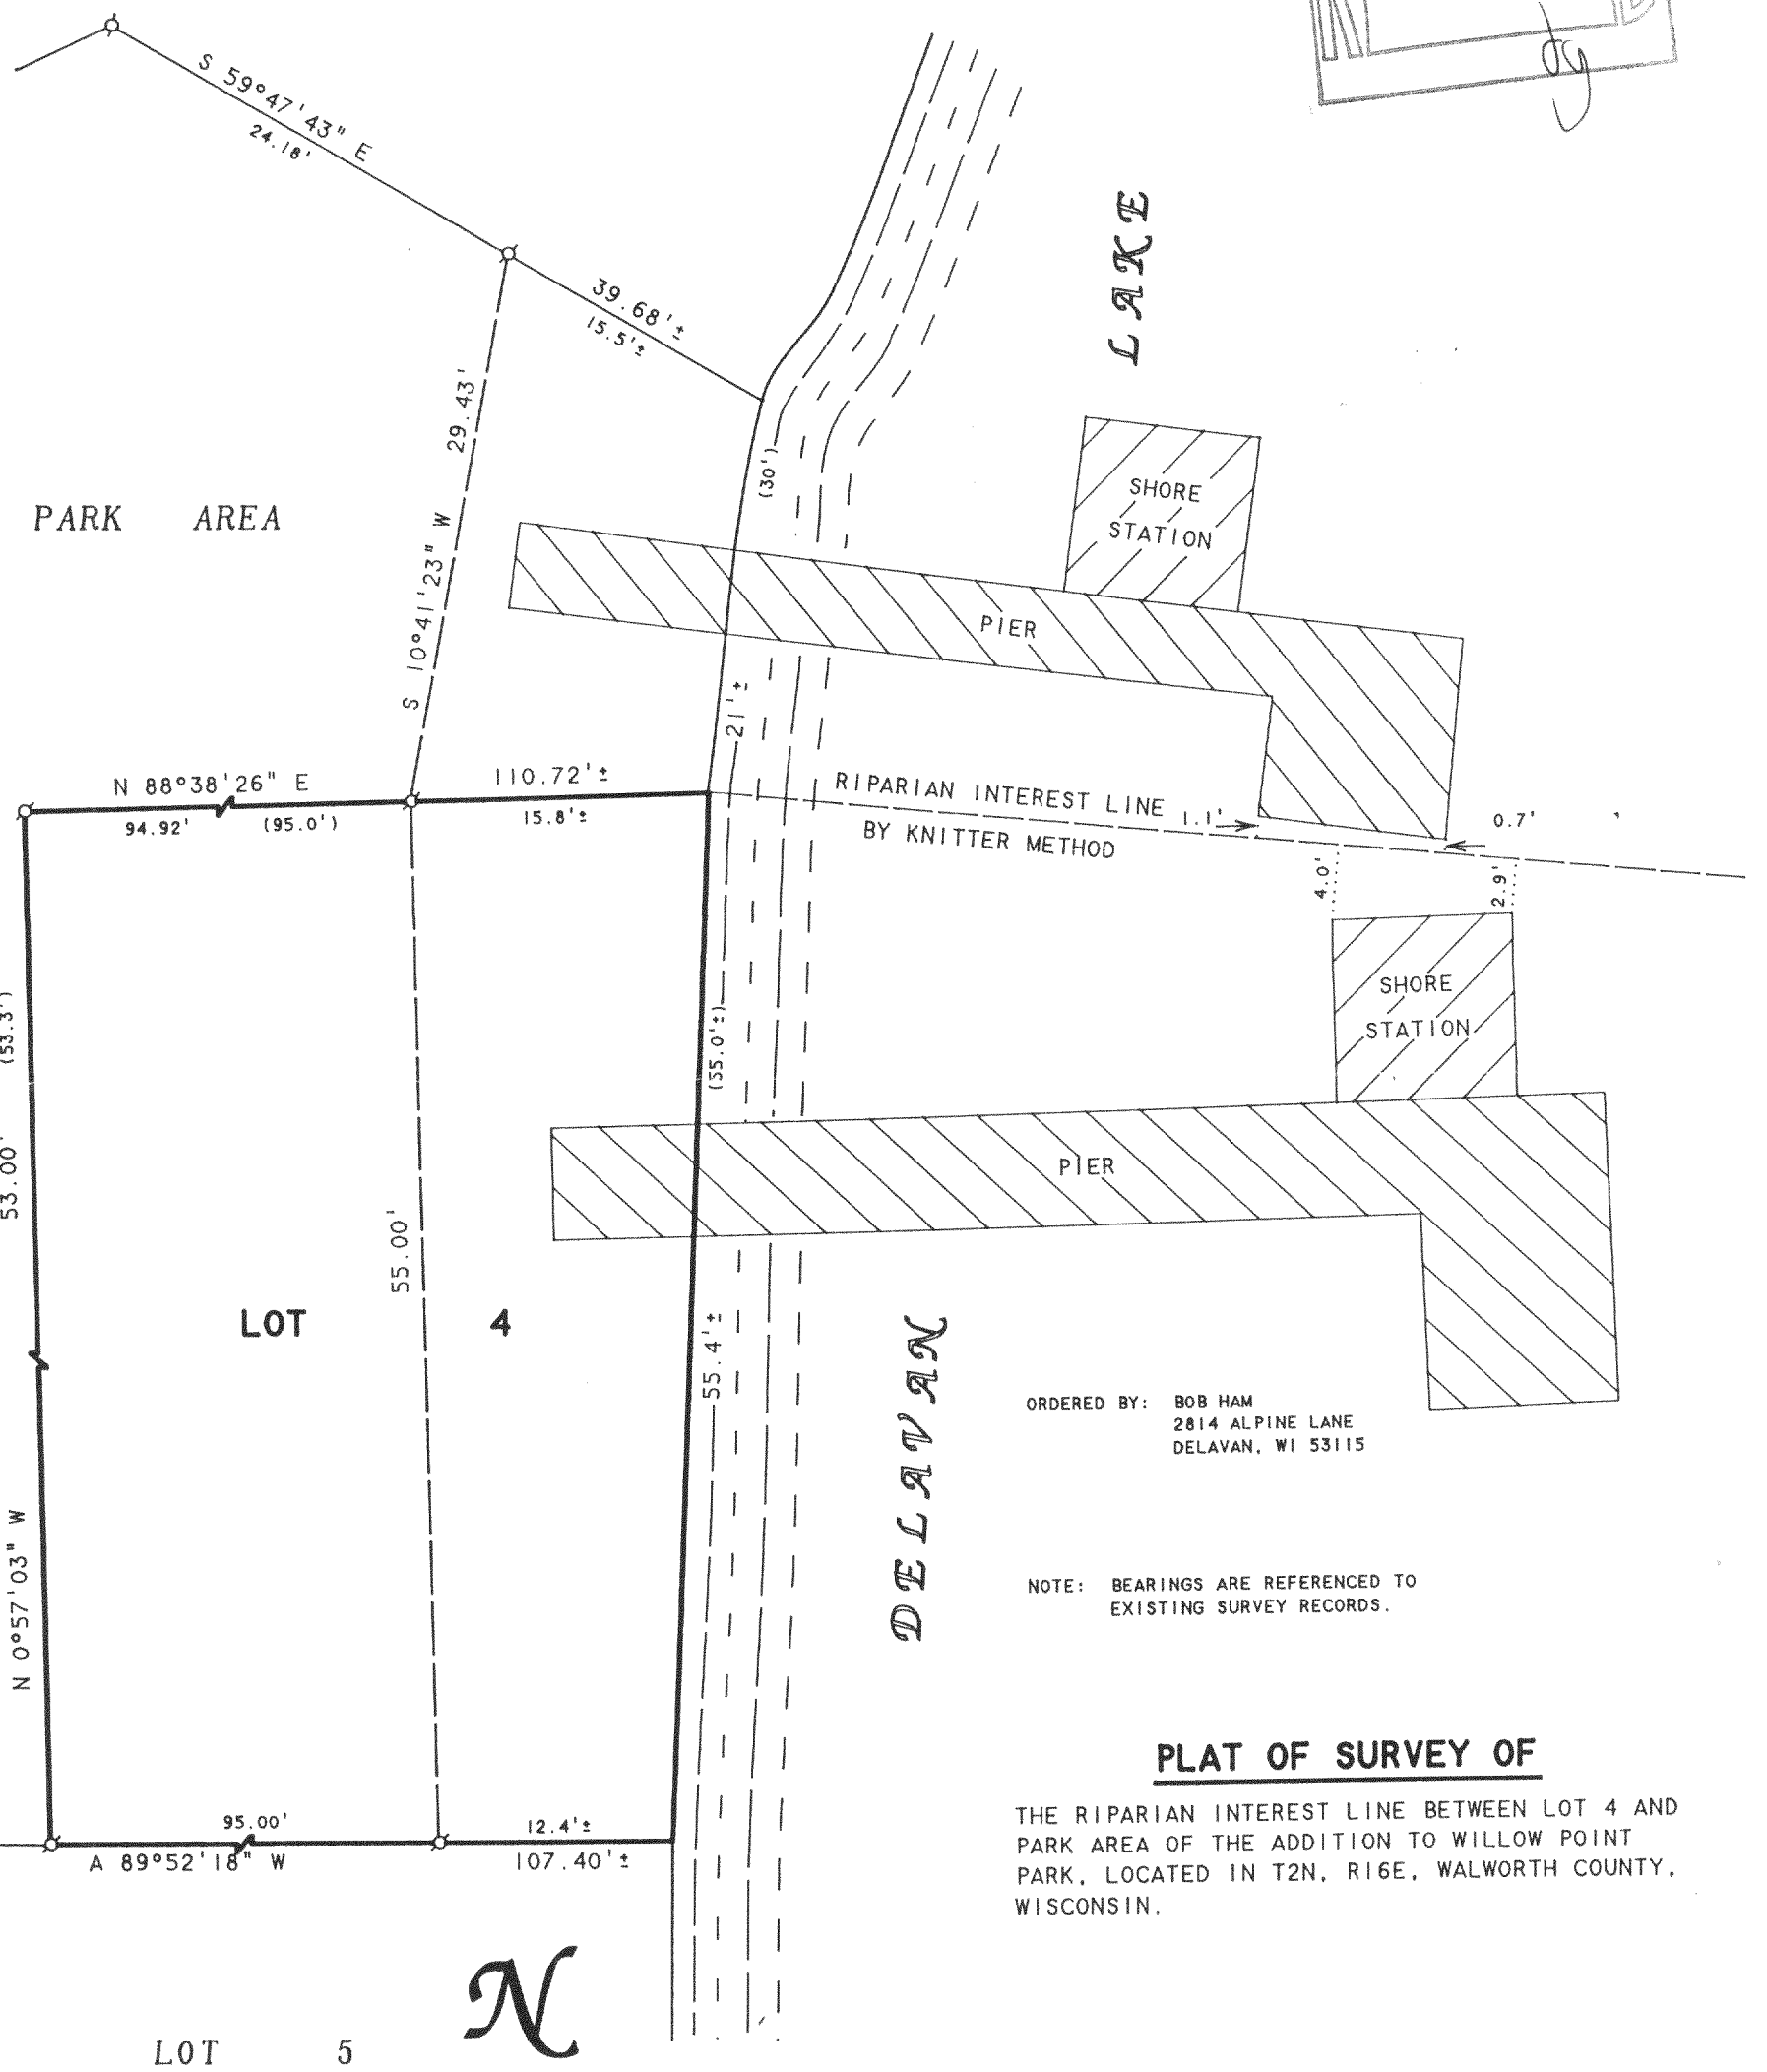

LEGEND

Ø -IRON PIPE FOUND
( )-RECORDED AS

ORDERED BY: BOB HAM
2814 ALPINE LANE
DELAVAN, WI 53115

NOTE: BEARINGS ARE REFERENCED TO EXISTING SURVEY RECORDS.

PLAT OF SURVEY OF

THE RIPARIAN INTEREST LINE BETWEEN LOT 4 AND PARK AREA OF THE ADDITION TO WILLOW POINT PARK, LOCATED IN T2N, R16E, WALWORTH COUNTY, WISCONSIN.

I, DAVID F. ABELL, DO HEREBY CERTIFY THAT I HAVE SURVEYED THE PROPERTY HEREON DESCRIBED ACCORDING TO THE OFFICAL RECORDS AND THAT THE PLAT HEREON IS A CORRECT REPRESENTATION OF THE PROPERTY LINES TO THE BEST OF MY KNOWLEDGE AND BELIEF.

David F. Abell

DAVID F. ABELL
WISCONSIN REGISTERED LAND SURVEYOR, S-1596

July 2, 1997

DATE JOB NUMBER - 91192

NOTE: THIS IS NOT A CERTIFIED COPY UNLESS SEALED.

FW1A-4
216-2432