
GEORGE T. DUNHAM

SURVEYING & SUBDIVIDING

DELAVAN, WISCONSIN



Scale - 1" = 20'

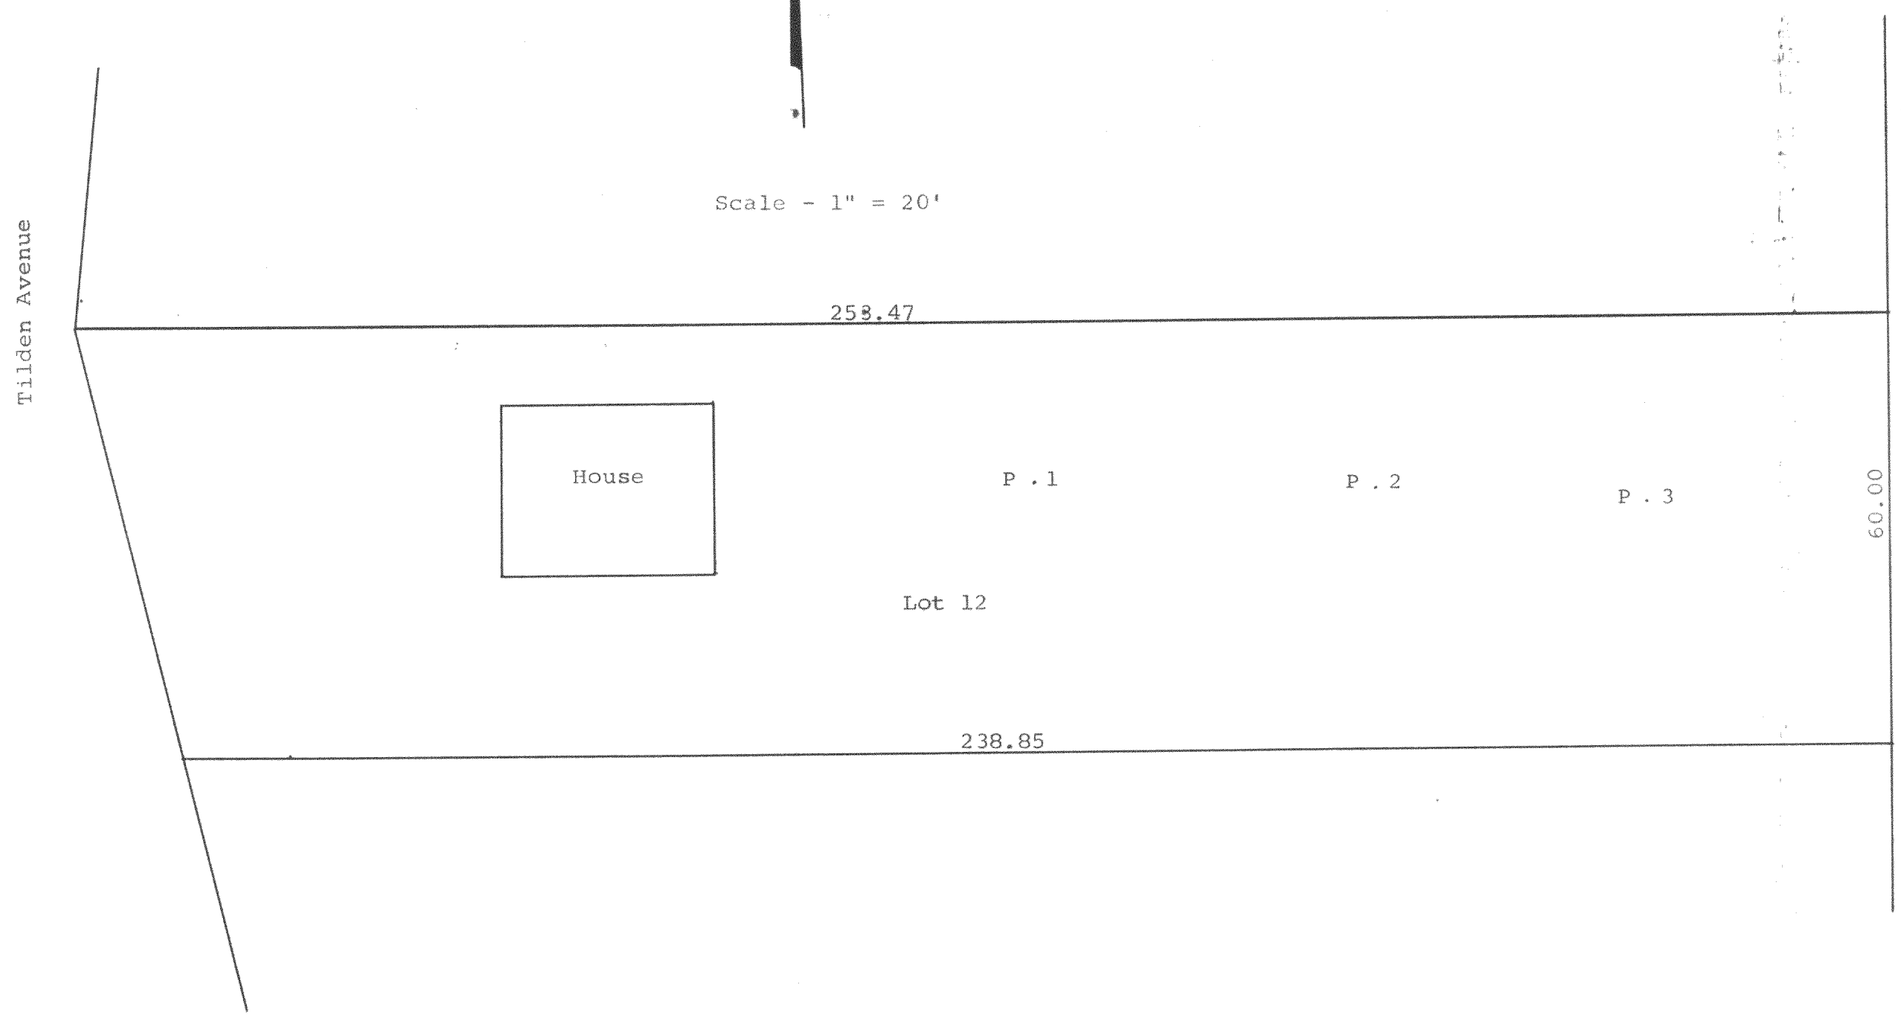

Plat showing the location of the percolation tests made on Lot 12, Block 7, Delmar Subdivision, Town of Delavan, Walworth County, Wisconsin. Bernard Kozel - Owner.
November 15, 1967

George T. Dunham

George T. Dunham, Surveyor

216-257

FDM-36