
ABELL
SURVEYING & MAPPING

1140 SEQUOIA STREET • DELAVAN, WISCONSIN 53115
262-728-6737

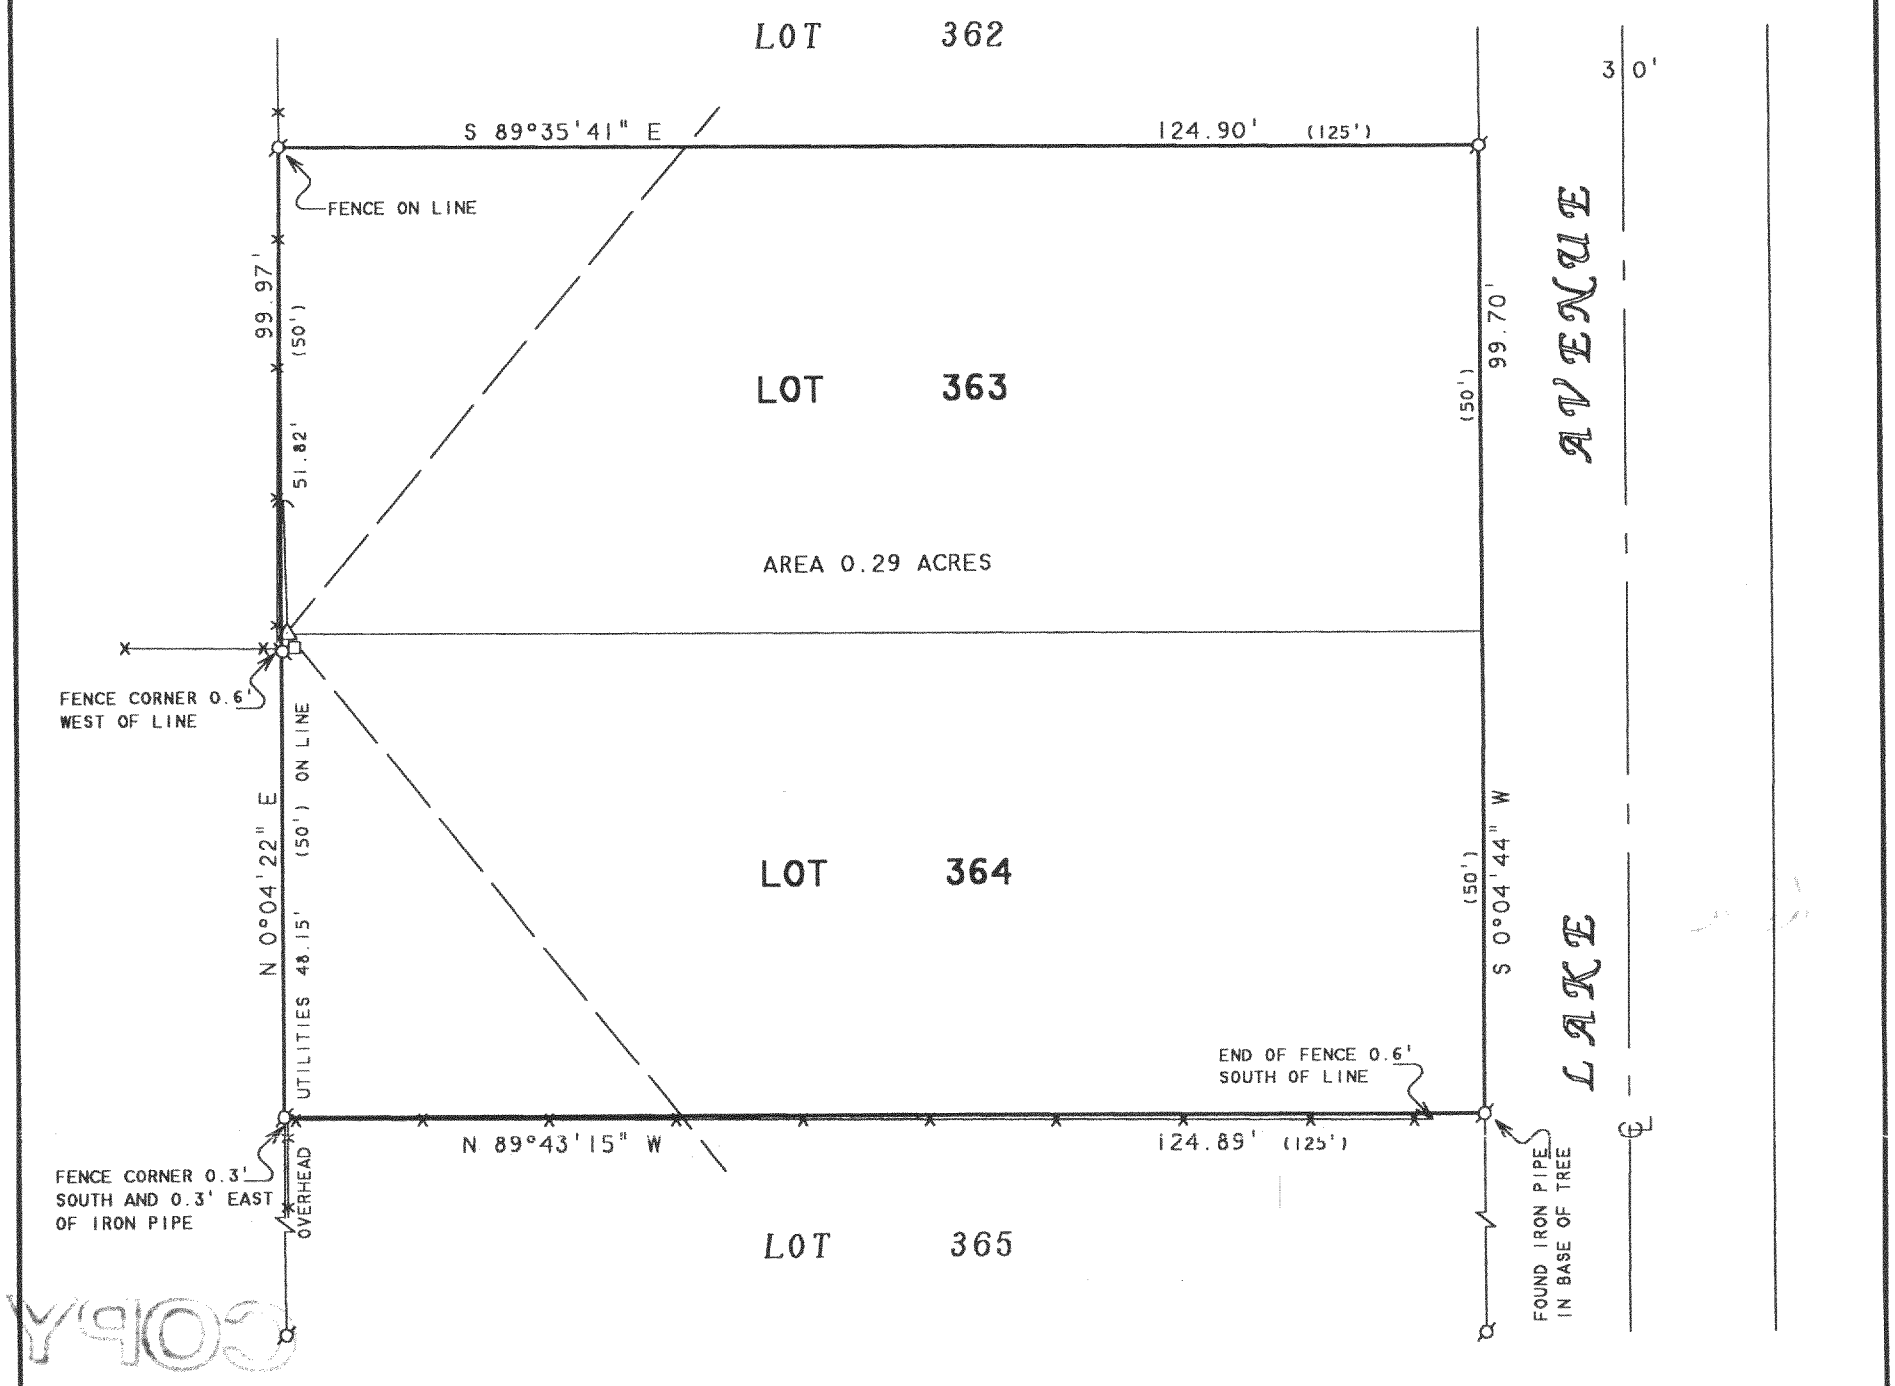

NOTE: BEARINGS ARE REFERENCED TO EXISTING SURVEY RECORDS.

N

SCALE 1"=20'

LEGEND

- ⌀ -IRON PIPE FOUND
- △ -UTILITY POLE
- —→ -GUY WIRE
- □ -UTILITY PED.
- ——— ——— -OVERHEAD UTILITY LINES
- ×———× -CHAINLINK FENCE
- ( )-RECORDED AS

ORDERED BY: ALBERT WOLFGRAM
5567 EDGEWATER COURT
DELAVAN, WI 53115

PLAT OF SURVEY OF

LOTS 363 AND 364, LAKE DELAVAN HIGHLANDS,
LOCATED IN T2N, R16E, WALWORTH COUNTY,
WISCONSIN.

RECEIVED
AUG

I HEREBY CERTIFY THAT I HAVE SURVEYED THE ABOVE DESCRIBED PROPERTY AND THAT THE ABOVE MAP IS A TRUE REPRESENTATION THEREOF AND SHOWS THE SIZE AND LOCATION OF THE PROPERTY, ITS EXTERIOR BOUNDARIES, THE LOCATION OF ALL VISIBLE STRUCTURES AND DIMENSIONS OF ALL PRINCIPAL BUILDINGS THEREON, BOUNDARY FENCES, APPARENT EASEMENTS, ROADWAYS AND VISIBLE ENCROACHMENTS, IF ANY, TO THE BEST OF MY KNOWLEDGE AND BELIEF.

THIS SURVEY IS MADE FOR THE USE OF THE PRESENT OWNERS OF THE PROPERTY, AND ALSO THOSE WHO PURCHASE, MORTGAGE, OR GUARANTEE THE TITLE THERETO WITHIN ONE (1) YEAR FROM DATE HEREON.

David F. Abell

DAVID F. ABELL
WISCONSIN REGISTERED LAND SURVEYOR, S-1596

June 24, 2000

DATE JOB NUMBER - 00073

NOTE: THIS IS NOT A CERTIFIED COPY UNLESS SEALED.

FLAD-273

216-2901