
ABELL
SURVEYING & MAPPING

1140 SEQUOIA STREET • DELAVAN, WISCONSIN 53115
262-728-6737

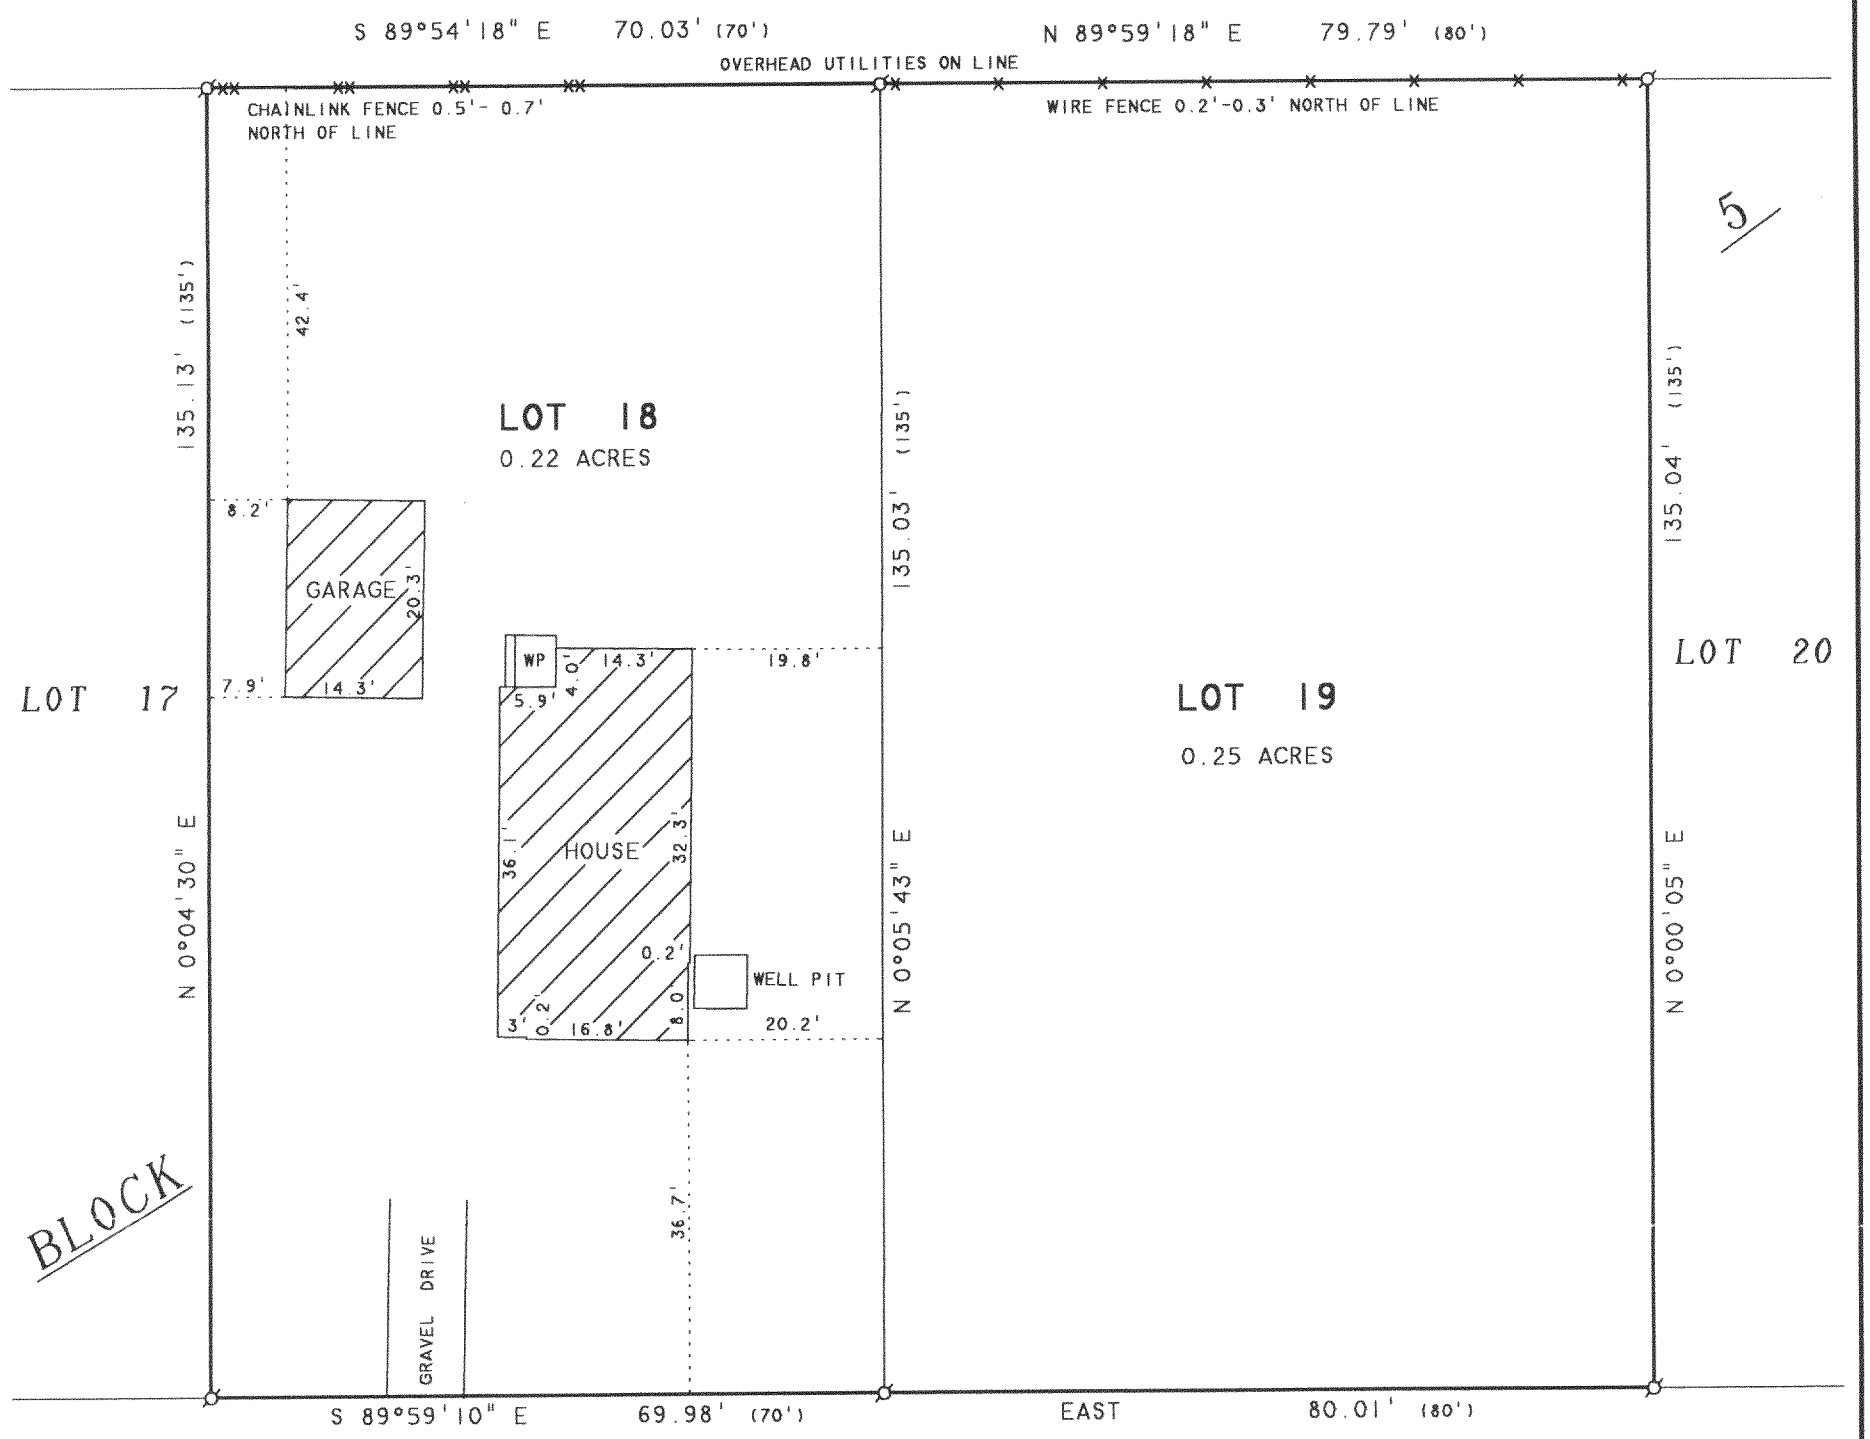

PLAT OF SURVEY OF

LOT 18 AND LOT 19, BLOCK 5, DELMAR SUBDIVISION,
LOCATED IN T2N,R16E, WALWORTH COUNTY, WISCONSIN.

ORDERED BY: DARLEEN MEES
601 N. 2ND AVENUE
VILLA PARK, IL 60181

RECEIVED
DEC 2 1 2001

NOTE: BEARINGS ARE REFERENCED TO THE RECORDED SUBDIVISION PLAT.

N

SCALE 1"-20'

LEGEND

Ø - IRON PIPE FOUND
WP - WOOD PORCH
( )- RECORDED AS

I, DAVID F. ABELL, DO HEREBY CERTIFY THAT I HAVE SURVEYED THE PROPERTY HEREON DESCRIBED ACCORDING TO THE OFFICAL RECORDS AND THAT THE PLAT HEREON IS A CORRECT REPRESENTATION OF THE PROPERTY LINES TO THE BEST OF MY KNOWLEDGE AND BELIEF.

David F. Abell

DAVID F. ABELL
WISCONSIN REGISTERED LAND SURVEYOR, S-1596

September 19, 2001

DATE JOB NUMBER - 01142

NOTE: THIS IS NOT A CERTIFIED COPY UNLESS SEALED.

FDM-2881 216-3092