


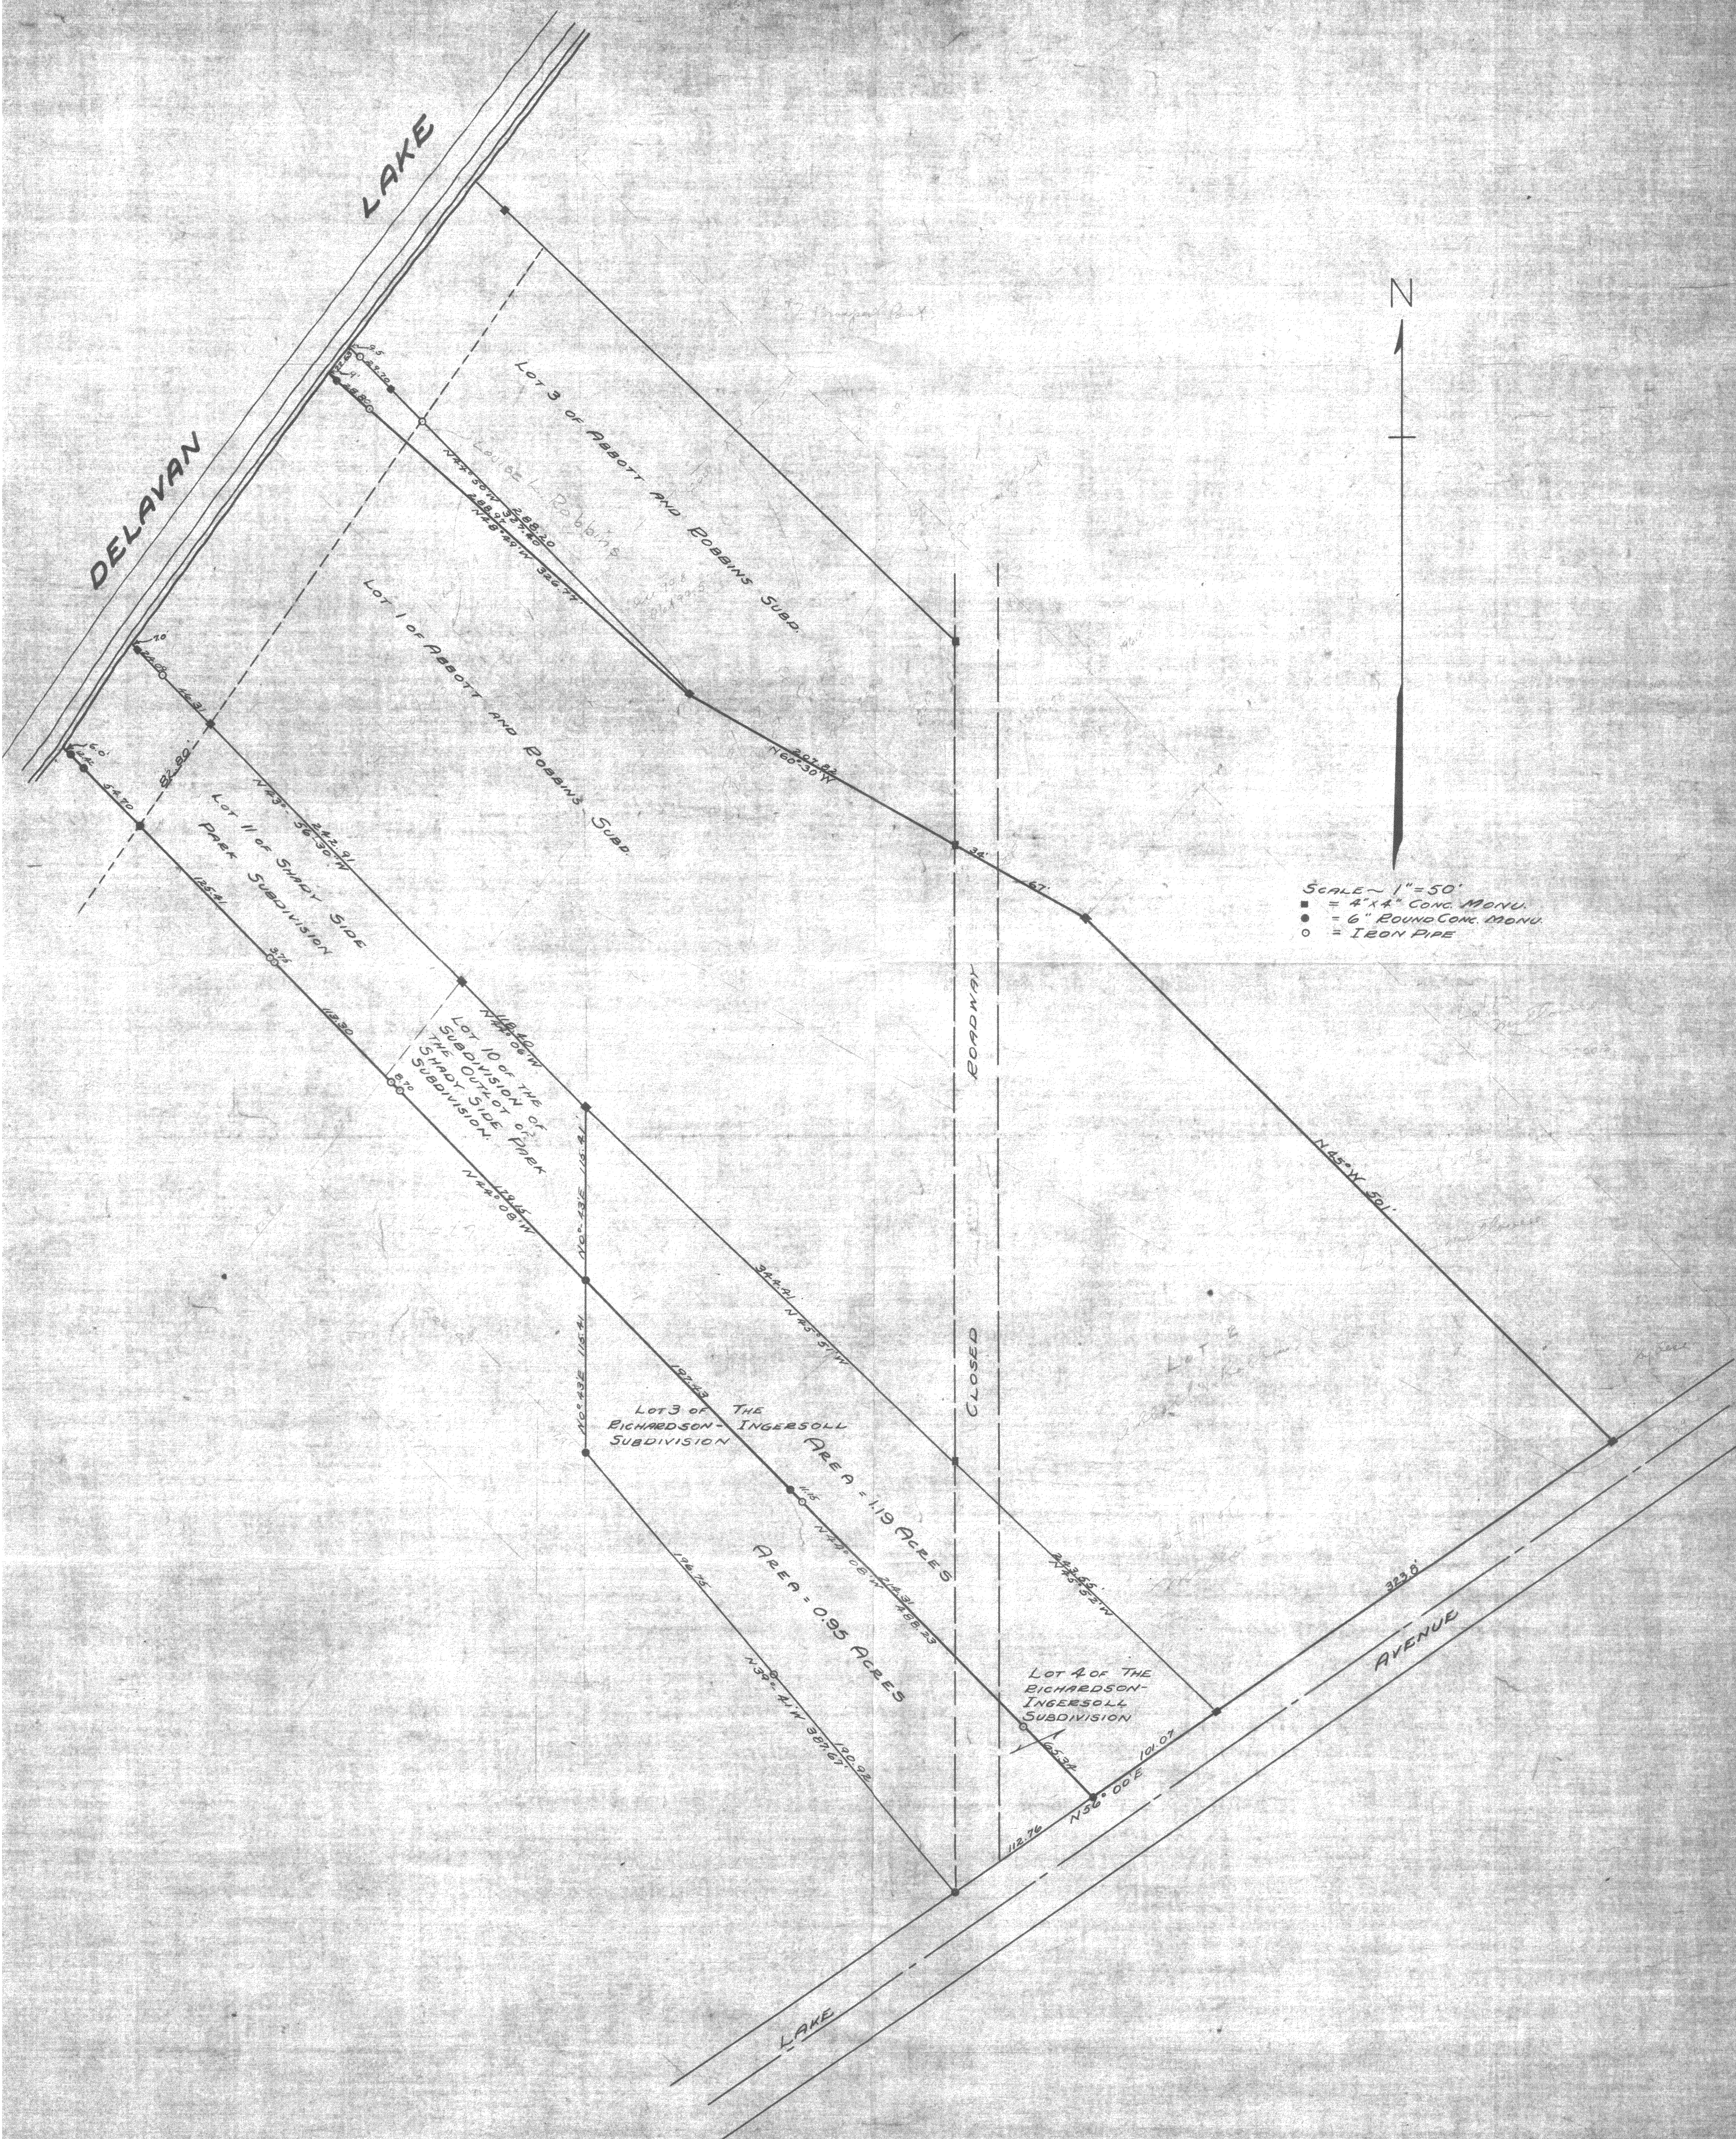

PLAT OF SURVEY OF LOT 11 OF SHADY SIDE PARK SUBDIVISION, LOT 10 OF THE SUBDIVISION OF THE OUTLOT OF SHADY SIDE PARK SUBDIVISION, LOTS 3 AND 4 OF THE RICHARDSON-INGERSOLL SUBDIVISION AND PART OF LOT 1 OF ABBOTT AND BOBBINS SUBDIVISION, ALL OF WHICH IS LOCATED IN SECTIONS 28 AND 33, T2N R16E OF WALWORTH COUNTY, WISCONSIN
Nov 1939

Floyd F. Jensen
COUNTY SURVEYOR

216-31.1

ESH - 6 and FRI - 1B
FSHJ - 6 " 2