
FARRIS, HANSEN & ASSOCIATES, INC.

ENGINEERING – ARCHITECTURE – SURVEYING
7 RIDGWAY COURT – P.O. BOX 437 – ELKHORN, WISCONSIN 53121
PHONE: (262) 723–2098 FAX: (262) 723–5886

PLAT OF SURVEY

UNIT 8 OF WINDTREE ACRES, A CONDOMINIUM
LOCATED IN THE SE 1/4 OF SECTION 21, TOWN 2 NORTH,
RANGE 16 EAST, WALWORTH COUNTY, WISCONSIN

– WORK ORDERED BY –
GARY WILSON – RJM BUILDERS
15855 W. NATIONAL AVENUE
NEW BERLIN, WI. 53151

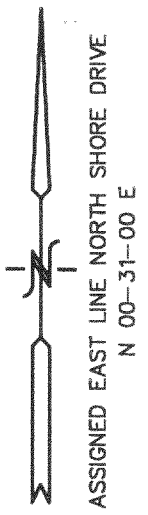


100 90 80 70 60 50 40 30 20 10 0 50 100
MAP SCALE IN FEET ORIGINAL 1" = 40'

LEGEND

- o = FOUND IRON PIPE STAKE
- ● = FOUND IRON REBAR STAKE
- ◙ = SET IRON REBAR STAKE
- ⏃ = SET "PK" NAIL
- ⊙ = POWER POLE
- ▫ = UTILITY BOX
- (XXX) = RECORDED AS

RECEIVED
JAN 2 2002

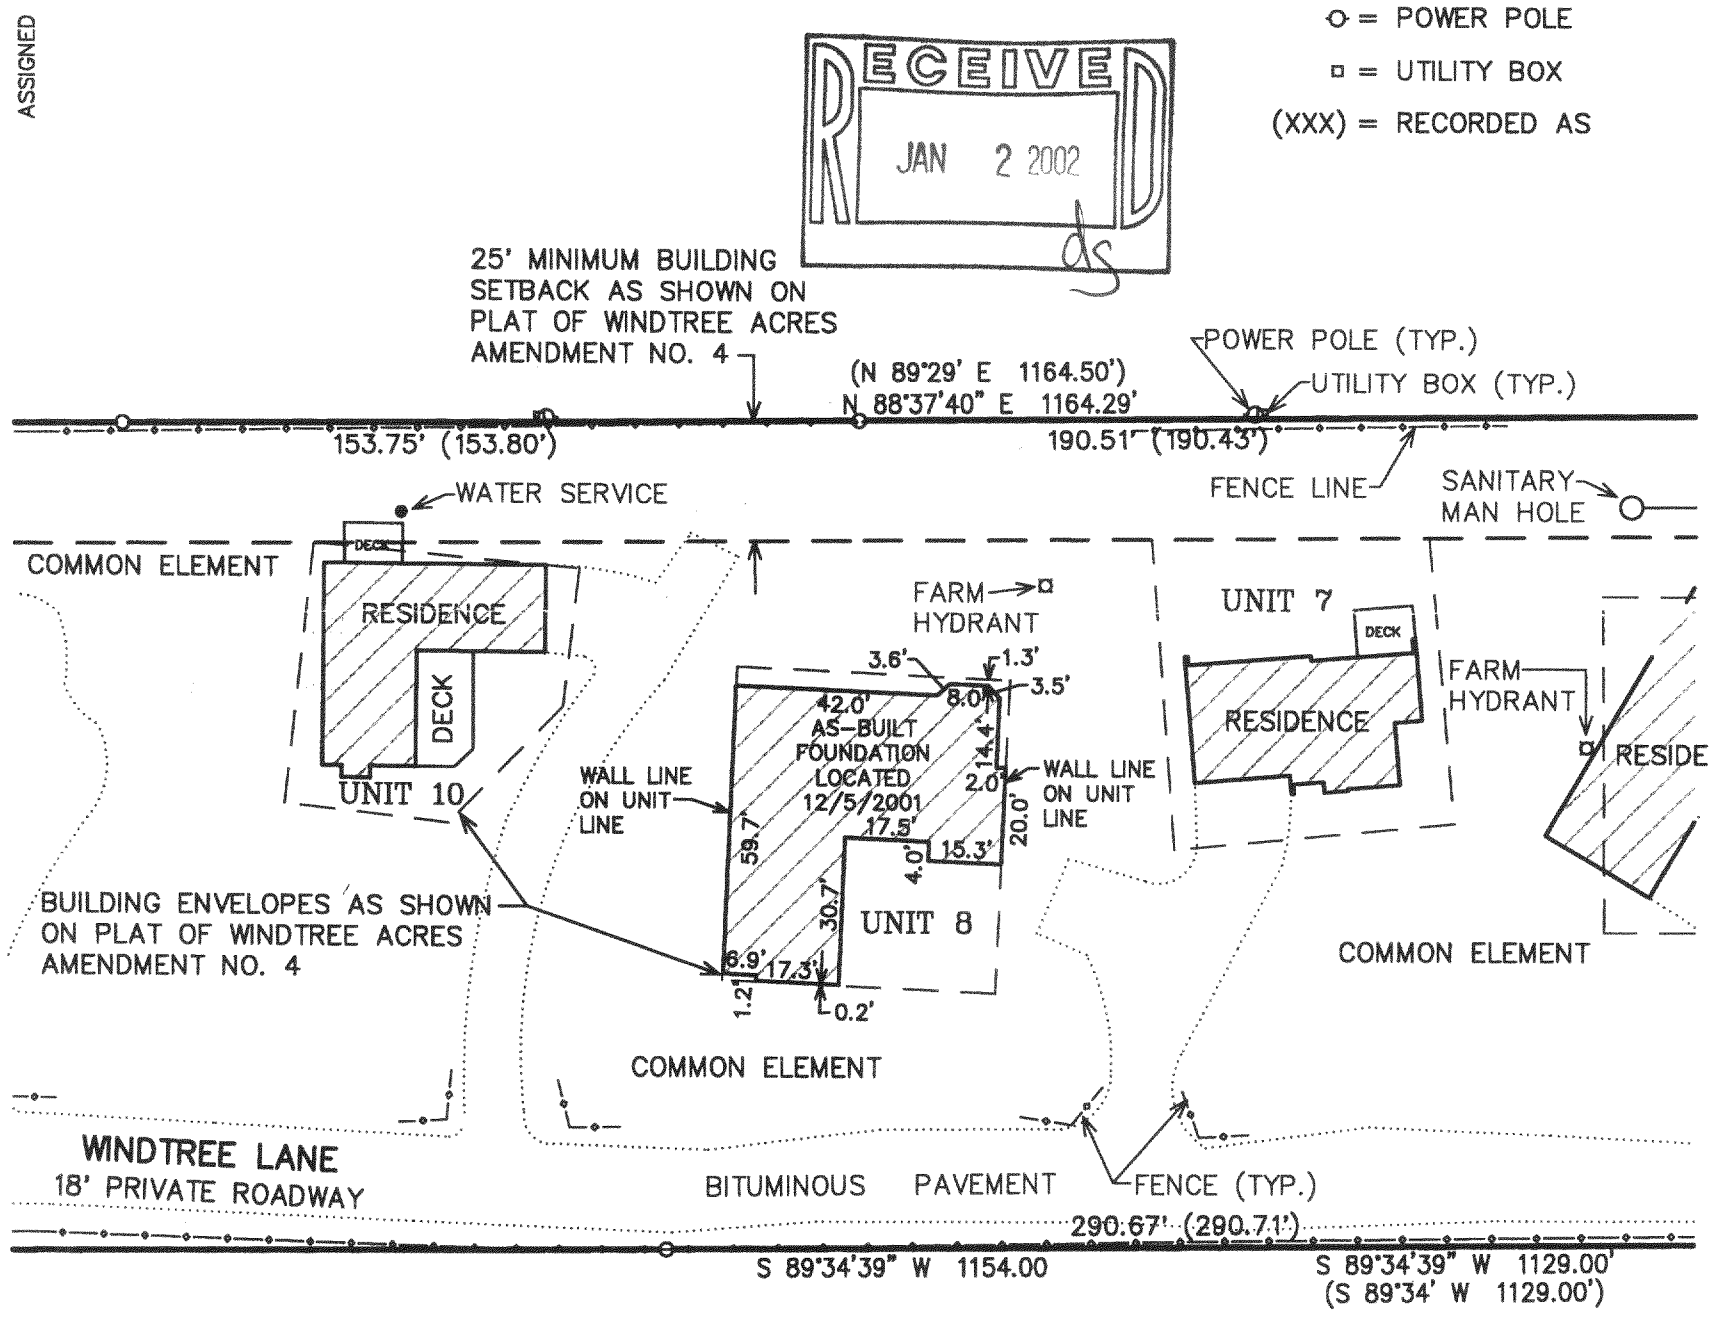

NOTE: COPIES OF THIS MAP TO WHICH THE FOLLOWING CERTIFICATE WILL APPLY SHOW THE SURVEYOR'S ORIGINAL SEAL AND SIGNATURE IN RED INK. COPIES BY ANY OTHER MEANS MAY HAVE ALTERATIONS WHICH DO NOT REPRESENT THE SURVEYOR'S WORK PRODUCT.

I HEREBY CERTIFY THAT THE ABOVE DESCRIBED PROPERTY HAS BEEN SURVEYED UNDER MY DIRECTION AND THAT THE ABOVE MAP IS A TRUE REPRESENTATION THEREOF AND SHOWS THE SIZE AND LOCATION OF THE PROPERTY AND ITS EXTERIOR BOUNDARIES. THIS SURVEY IS MADE FOR THE USE OF THE PRESENT OWNERS OF THE PROPERTY, AND ALSO THOSE WHO PURCHASE, MORTGAGE, OR GUARANTEE THE TITLE THERETO WITHIN ONE YEAR FROM THE DATE HEREOF.

DATED: 12-7-2001

PETER S. GORDON R.L.S. 2101

PROJECT: 2045.08.01
DATE: 12/06/2001
SHEET 1 OF 1

FWIN-8L 216-3121

METROPOLITAN ENGINEERING, INC.
ENGINEERS – LAND SURVEYORS
20875 CROSSROADS CIRCLE, SUITE 150 WAUKESHA, WI 53186
(262) 782-2221 FAX 782-4426


PLAT OF SURVEY

PREPARED FOR: RJM BUILDERS

LOCATION: Windtree Lane, Delavan, Wisconsin

LEGAL DESCRIPTION: UNIT 8 WINDTREE ACRES, located in the SE 1/4 of Section 21, Town 2 North, Range 16 East, Town of Delavan, Walworth County, Wisconsin.

October 11, 2001 Survey No. 201481

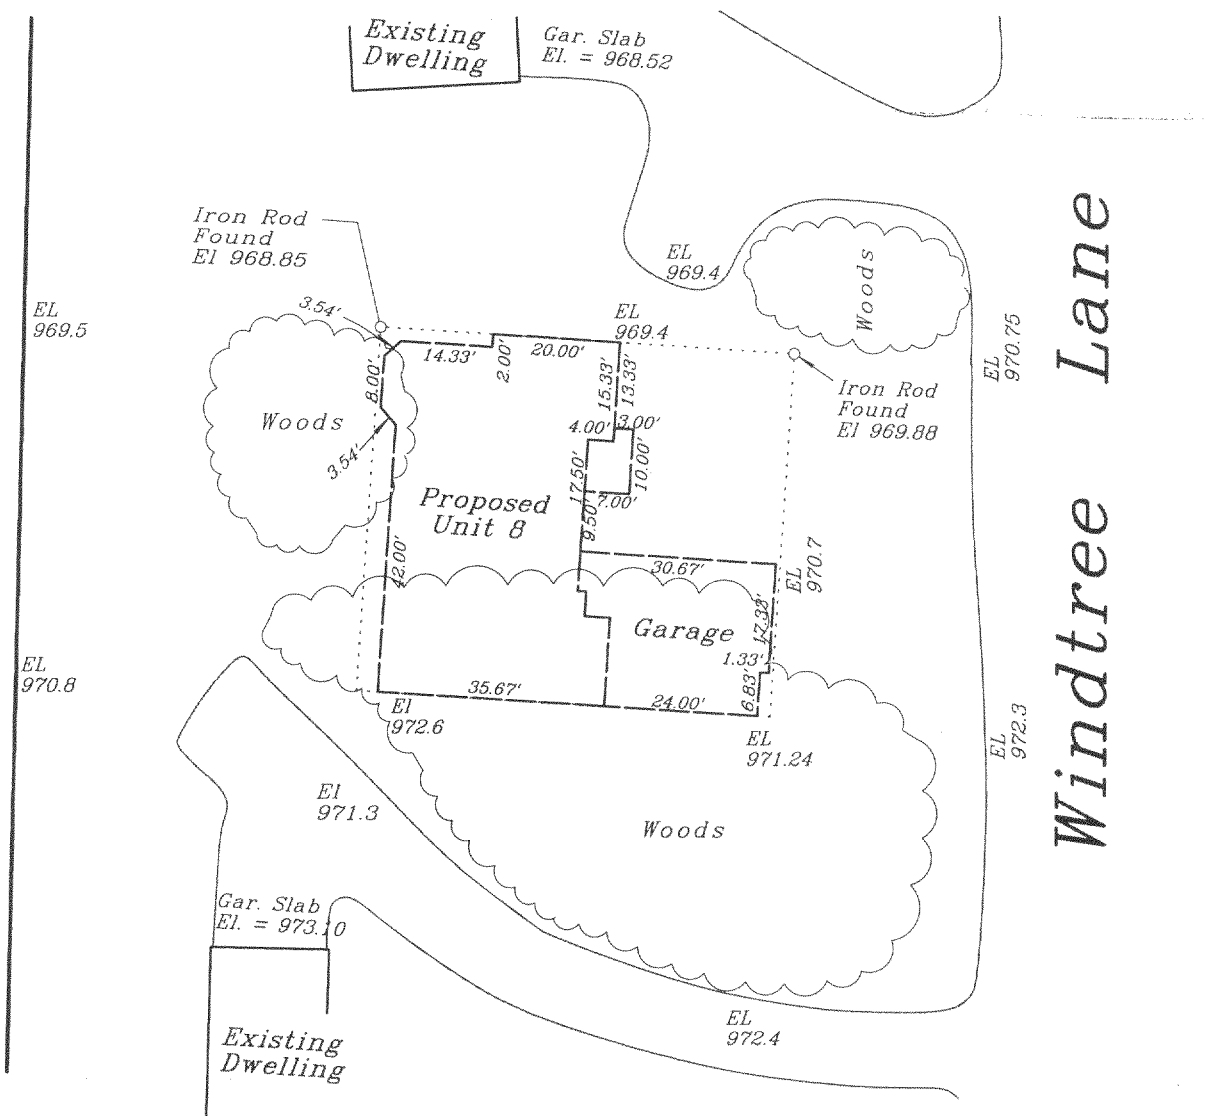

RECEIVED
JAN 1 1 2002

Scale: 1" = 30'

40'

10' Bench Mark:
San. Manhole
Rim = 973.08
8" E&W = 966.91

WISCONSIN
NORBERT F. STACHOWSKI
S-1480
HARTLAND
WI
LAND SURVEYOR

I hereby certify that I have surveyed the above described property and the above map is a true representation thereof and shows the size and location of the property, its exterior boundaries, the location of all visible structures and dimensions of all principal buildings thereon, boundary fences, apparent easements, roadway and visible encroachments, if any. This survey is made for the present owners of the property, and also those who purchase, mortgage, or guarantee, the title thereto within one (1) year from date hereof.

Signed _____

FWIN-8

216-3121