
ABELL
SURVEYING & MAPPING
1140 SEQUOIA STREET · DELAVAN, WISCONSIN 53115
262-728-6737

RECEIVED

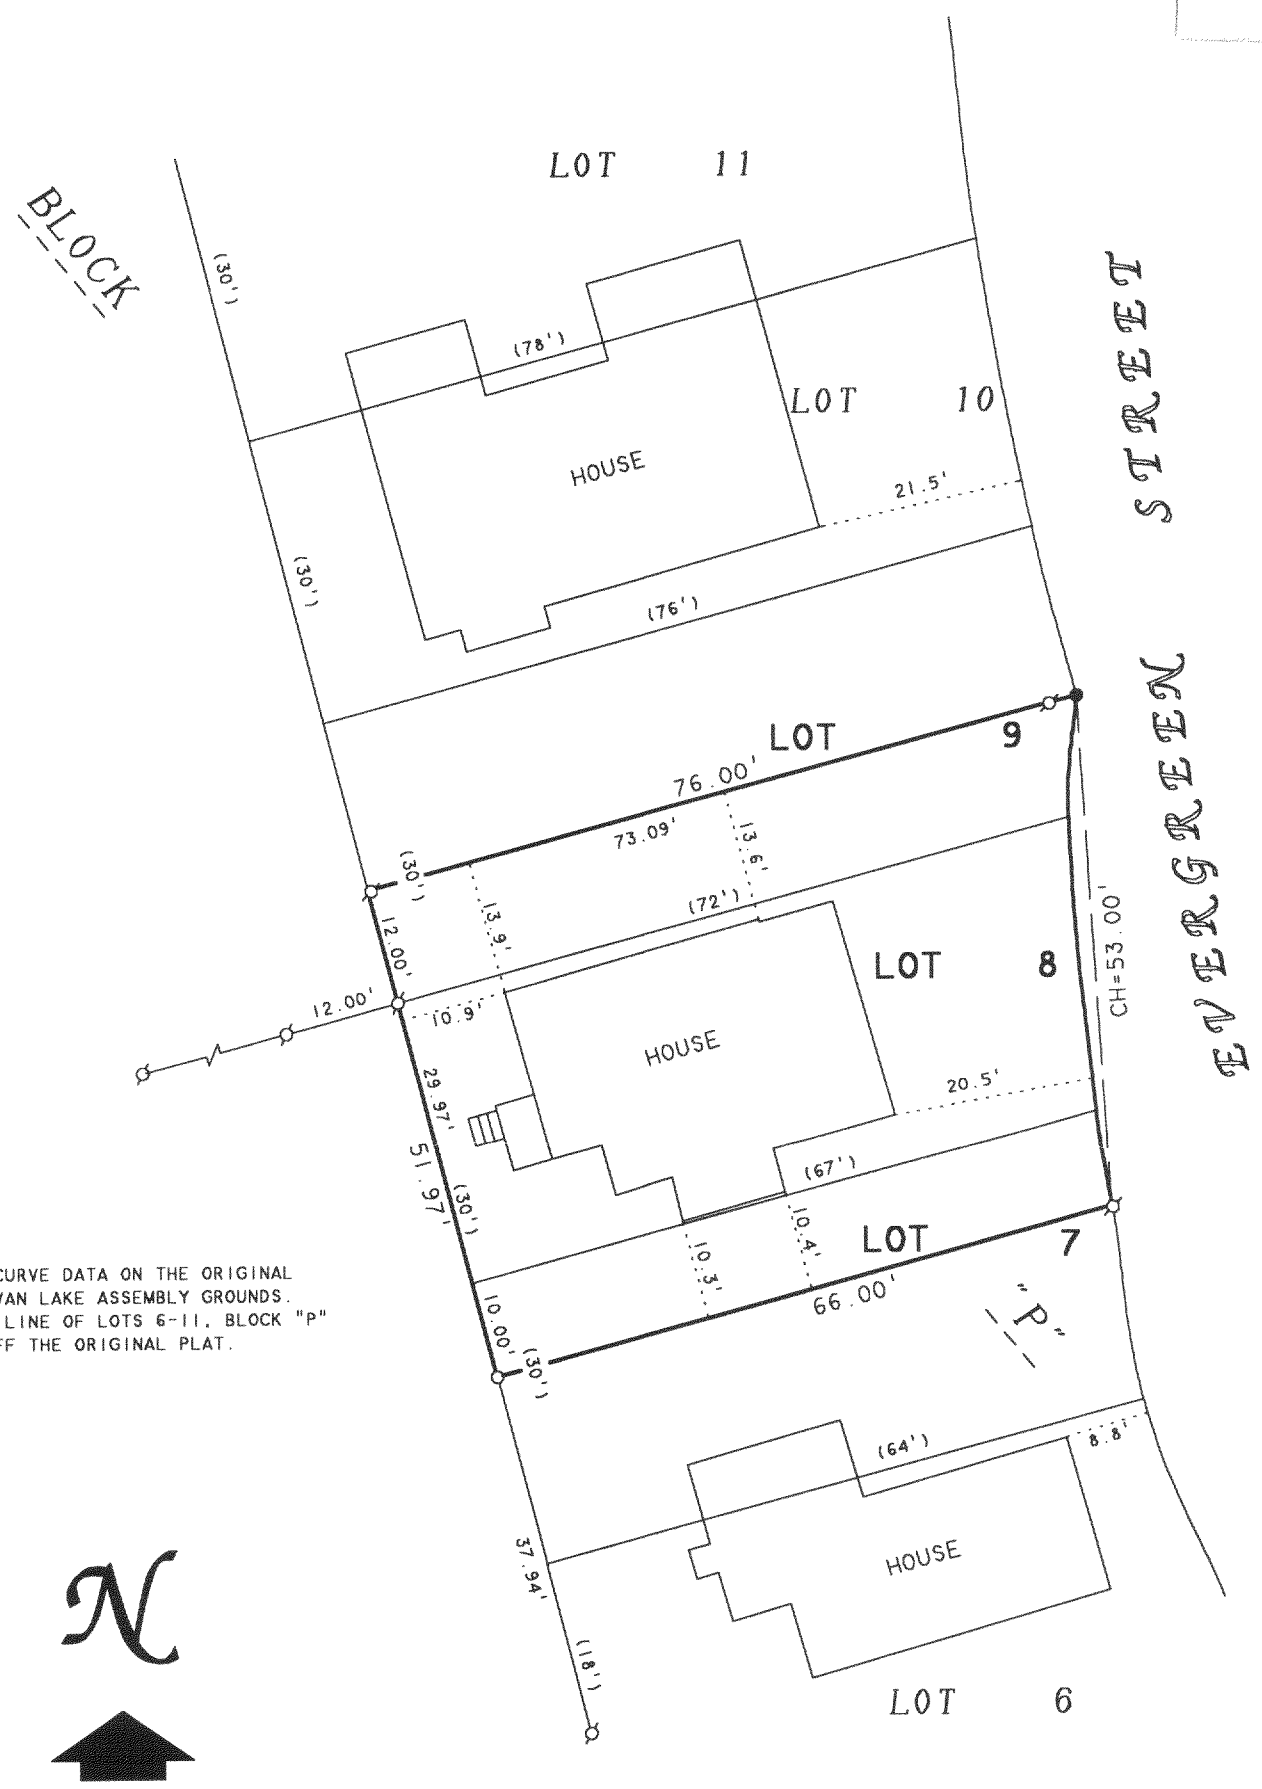

NOTE: THERE IS NO CURVE DATA ON THE ORIGINAL PLAT OF DELAVAN LAKE ASSEMBLY GROUNDS. THE EASTERLY LINE OF LOTS 6-11, BLOCK "P" WAS SCALED OFF THE ORIGINAL PLAT.

N

SCALE 1"=20'

LEGEND

- ⌀ -IRON PIPE FOUND
- ⌀ -IRON ROD FOUND
- ○ -1" DIA. IRON PIPE SET
- ● -7/8" DIA. IRON ROD SET IN BLACKTOP ROADWAY
- ( )-RECORDED AS

PLAT OF

HOUSE LOCATIONS ON LOTS 6-11, BLOCK "P", DELAVAN LAKE ASSEMBLY GROUNDS, LOCATED IN T2N, R16E, WALWORTH COUNTY, WISCONSIN.

ORDERED BY: COOK CONSTRUCTION
2666 COUNTY TRUNK "O" SOUTH
DELAVAN, WI 53115

David F. Abell

DAVID F. ABELL
WISCONSIN REGISTERED LAND SURVEYOR, S-1596

January 31, 2002

DATE JOB NUMBER - 01167A

NOTE: THIS IS NOT A CERTIFIED COPY UNLESS SEALED.

FDLA-
216-3193