NOTE: BEARINGS ARE REFERENCED TO EXISTING SURVEY RECORDS.


N

SCALE 1"=20'

LEGEND

- ○ - IRON PIPE FOUND
- ● - IRON ROD FOUND
- ⊗ - NAIL FOUND
- △ - UTILITY POLE
- —— —— - OVERHEAD UTILITY LINES
- ( )- RECORDED AS

ABELL
SURVEYING & MAPPING
1140 SEQUOIA STREET • DELAVAN, WISCONSIN 53115
262-728-6737

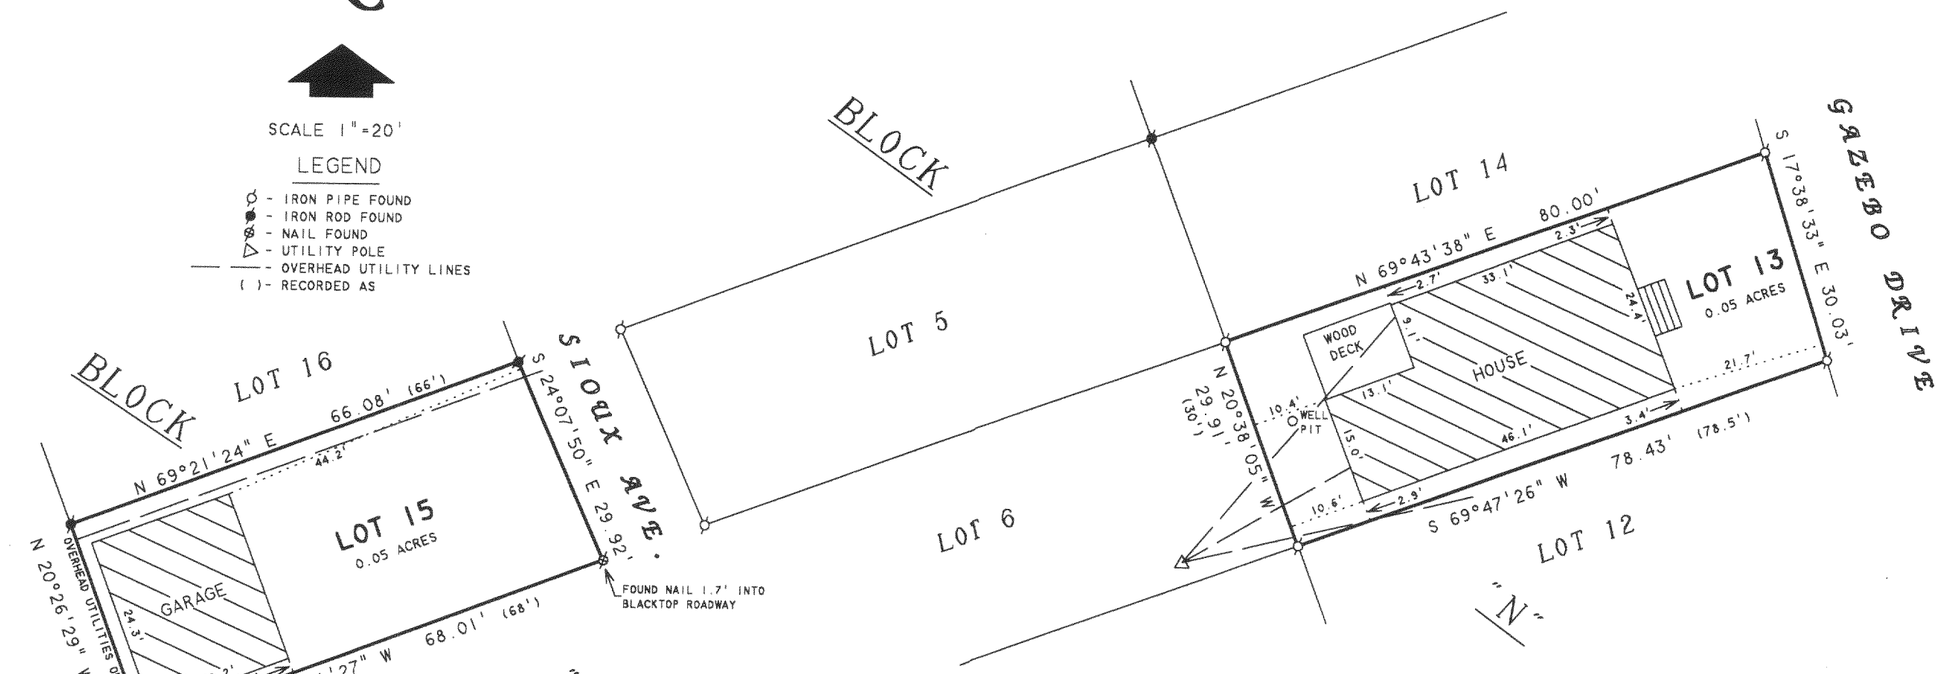

PLAT OF SURVEY OF

LOT 13, BLOCK "N" AND LOT 15, BLOCK "O", DELAVAN LAKE ASSEMBLY GROUNDS, LOCATED IN T2N,R16E, WALWORTH COUNTY, WISCONSIN.

ORDERED BY: JOANNE SORENSEN
108 TAMWORTH PLACE
SCHAUMBURG, IL 60194

RECEIVED
AUG 26 2002

I HEREBY CERTIFY THAT I HAVE SURVEYED THE ABOVE DESCRIBED PROPERTY AND THAT THE ABOVE MAP IS A TRUE REPRESENTATION THEREOF AND SHOWS THE SIZE AND LOCATION OF THE PROPERTY, ITS EXTERIOR BOUNDARIES, THE LOCATION OF ALL VISIBLE STRUCTURES AND DIMENSIONS OF ALL PRINCIPAL BUILDINGS THEREON, BOUNDARY FENCES, APPARENT EASEMENTS, ROADWAYS AND VISIBLE ENCROACHMENTS, IF ANY, TO THE BEST OF MY KNOWLEDGE AND BELIEF.

THIS SURVEY IS MADE FOR THE USE OF THE PRESENT OWNERS OF THE PROPERTY, AND ALSO THOSE WHO PURCHASE, MORTGAGE, OR GUARANTEE THE TITLE THERETO WITHIN ONE (1) YEAR FROM DATE HEREON.

David F. Abell

DAVID F. ABELL
WISCONSIN REGISTERED LAND SURVEYOR, S-1596

March 11, 2002

DATE JOB NUMBER - 02027

NOTE: THIS IS NOT A CERTIFIED COPY UNLESS SEALED.

FDLA 00140 FDLA 153

216-3228