

Detail
1"=20'

Delavan
Lake

Delavan
Lake

Plat of Survey

of

Lot 1 of Wallis Subdivision Addition No. 1,

a redivision of Lot 1 of Certified Survey Map No. 3138, located in Government Lots 1 and 2 and the Northeast 1/4 of Section 33, Town 2 North, Range 16 East, Town of Delavan, Walworth County, Wisconsin.

Surveyed for: **Edward A. Brennan Trust**
400 North Michigan Avenue
Chicago, Illinois 60611

c/o
Montsma Builders, Inc.
Delavan, Wisconsin 53115

Lot 1
C.S.M. 172

Readings referenced to the Wisconsin
State Plane Coordinate System,
South Zone.

Scale in Feet
1" = 40'





Jensen & Olson Land Surveying, LLC
45 South Wisconsin Street P.O. Box 322
Elkhorn, Wisconsin 53121
Telephone: (262) 723-3434
Facsimile: (262) 723-8044

Legend
Found Concrete Monument
Found Iron Pipe with Brass Cap
Found Iron Pipe
Found Iron Pipe
Recorded Information
Utility Pole
Manhole
Apparent Surface
Wire Fence
Deciduous tree & dia

Sheet 1 of 1 Sheets.
Job Reference Number
2001.099

2001.099
2001.099.570

216-3259

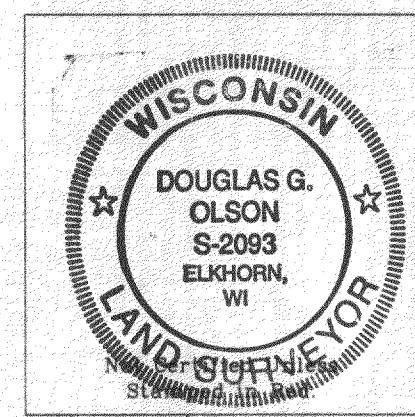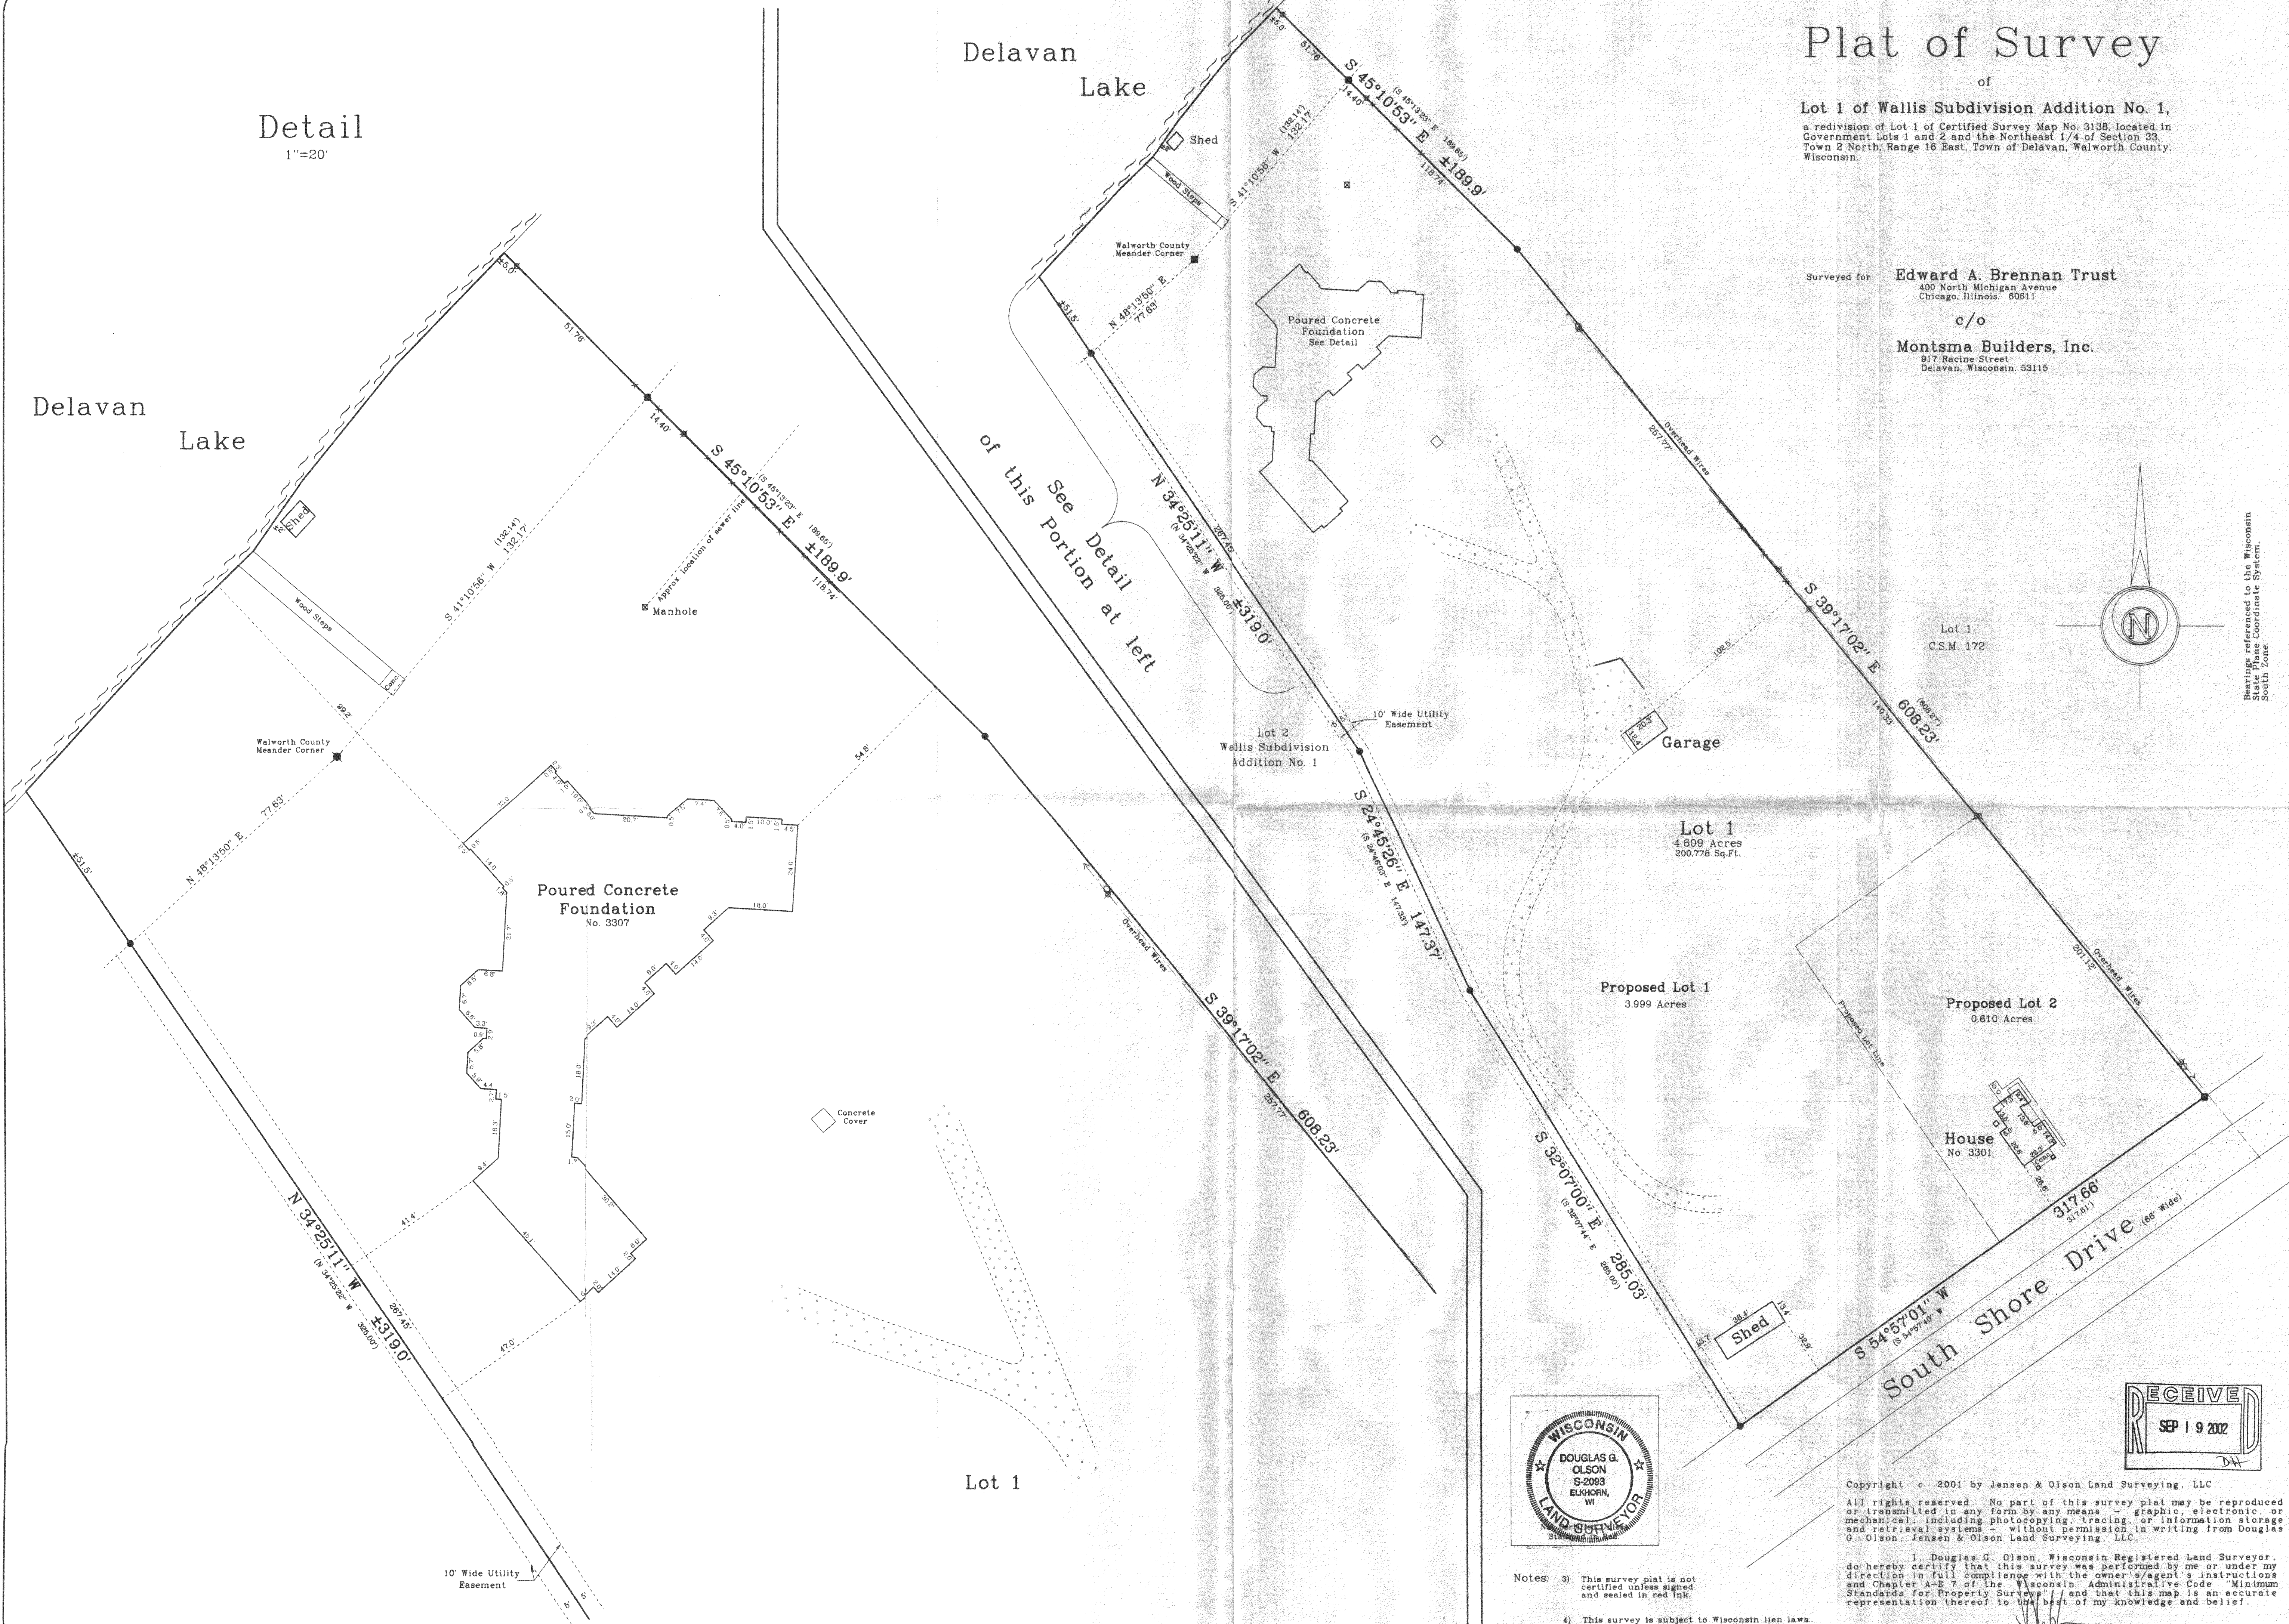

Notes: 3) This survey plat is not certified unless signed and sealed in red ink.
4) This survey is subject to Wisconsin lien laws. This Plat of Survey is the notice of intent to file lien. Lien waiver required.

Copyright © 2001 by Jensen & Olson Land Surveying, LLC.
All rights reserved. No part of this survey plat may be reproduced or transmitted in any form by any means - graphic, electronic, or mechanical, including photocopying, tracing, or information storage and retrieval systems - without permission in writing from Douglas G. Olson, Jensen & Olson Land Surveying, LLC.
I, Douglas G. Olson, Wisconsin Registered Land Surveyor, do hereby certify that this survey was performed by me or under my direction in full compliance with the owner's/agent's instructions and Chapter A-E 7 of the Wisconsin Administrative Code "Minimum Standards for Property Surveys" and that this map is an accurate representation thereof to the best of my knowledge and belief.
Douglas G. Olson
Wisconsin Registered Land Surveyor - 2093