
ABELL
SURVEYING & MAPPING

1140 SEQUOIA STREET · DELAVAN, WISCONSIN 53115

262-728-6737

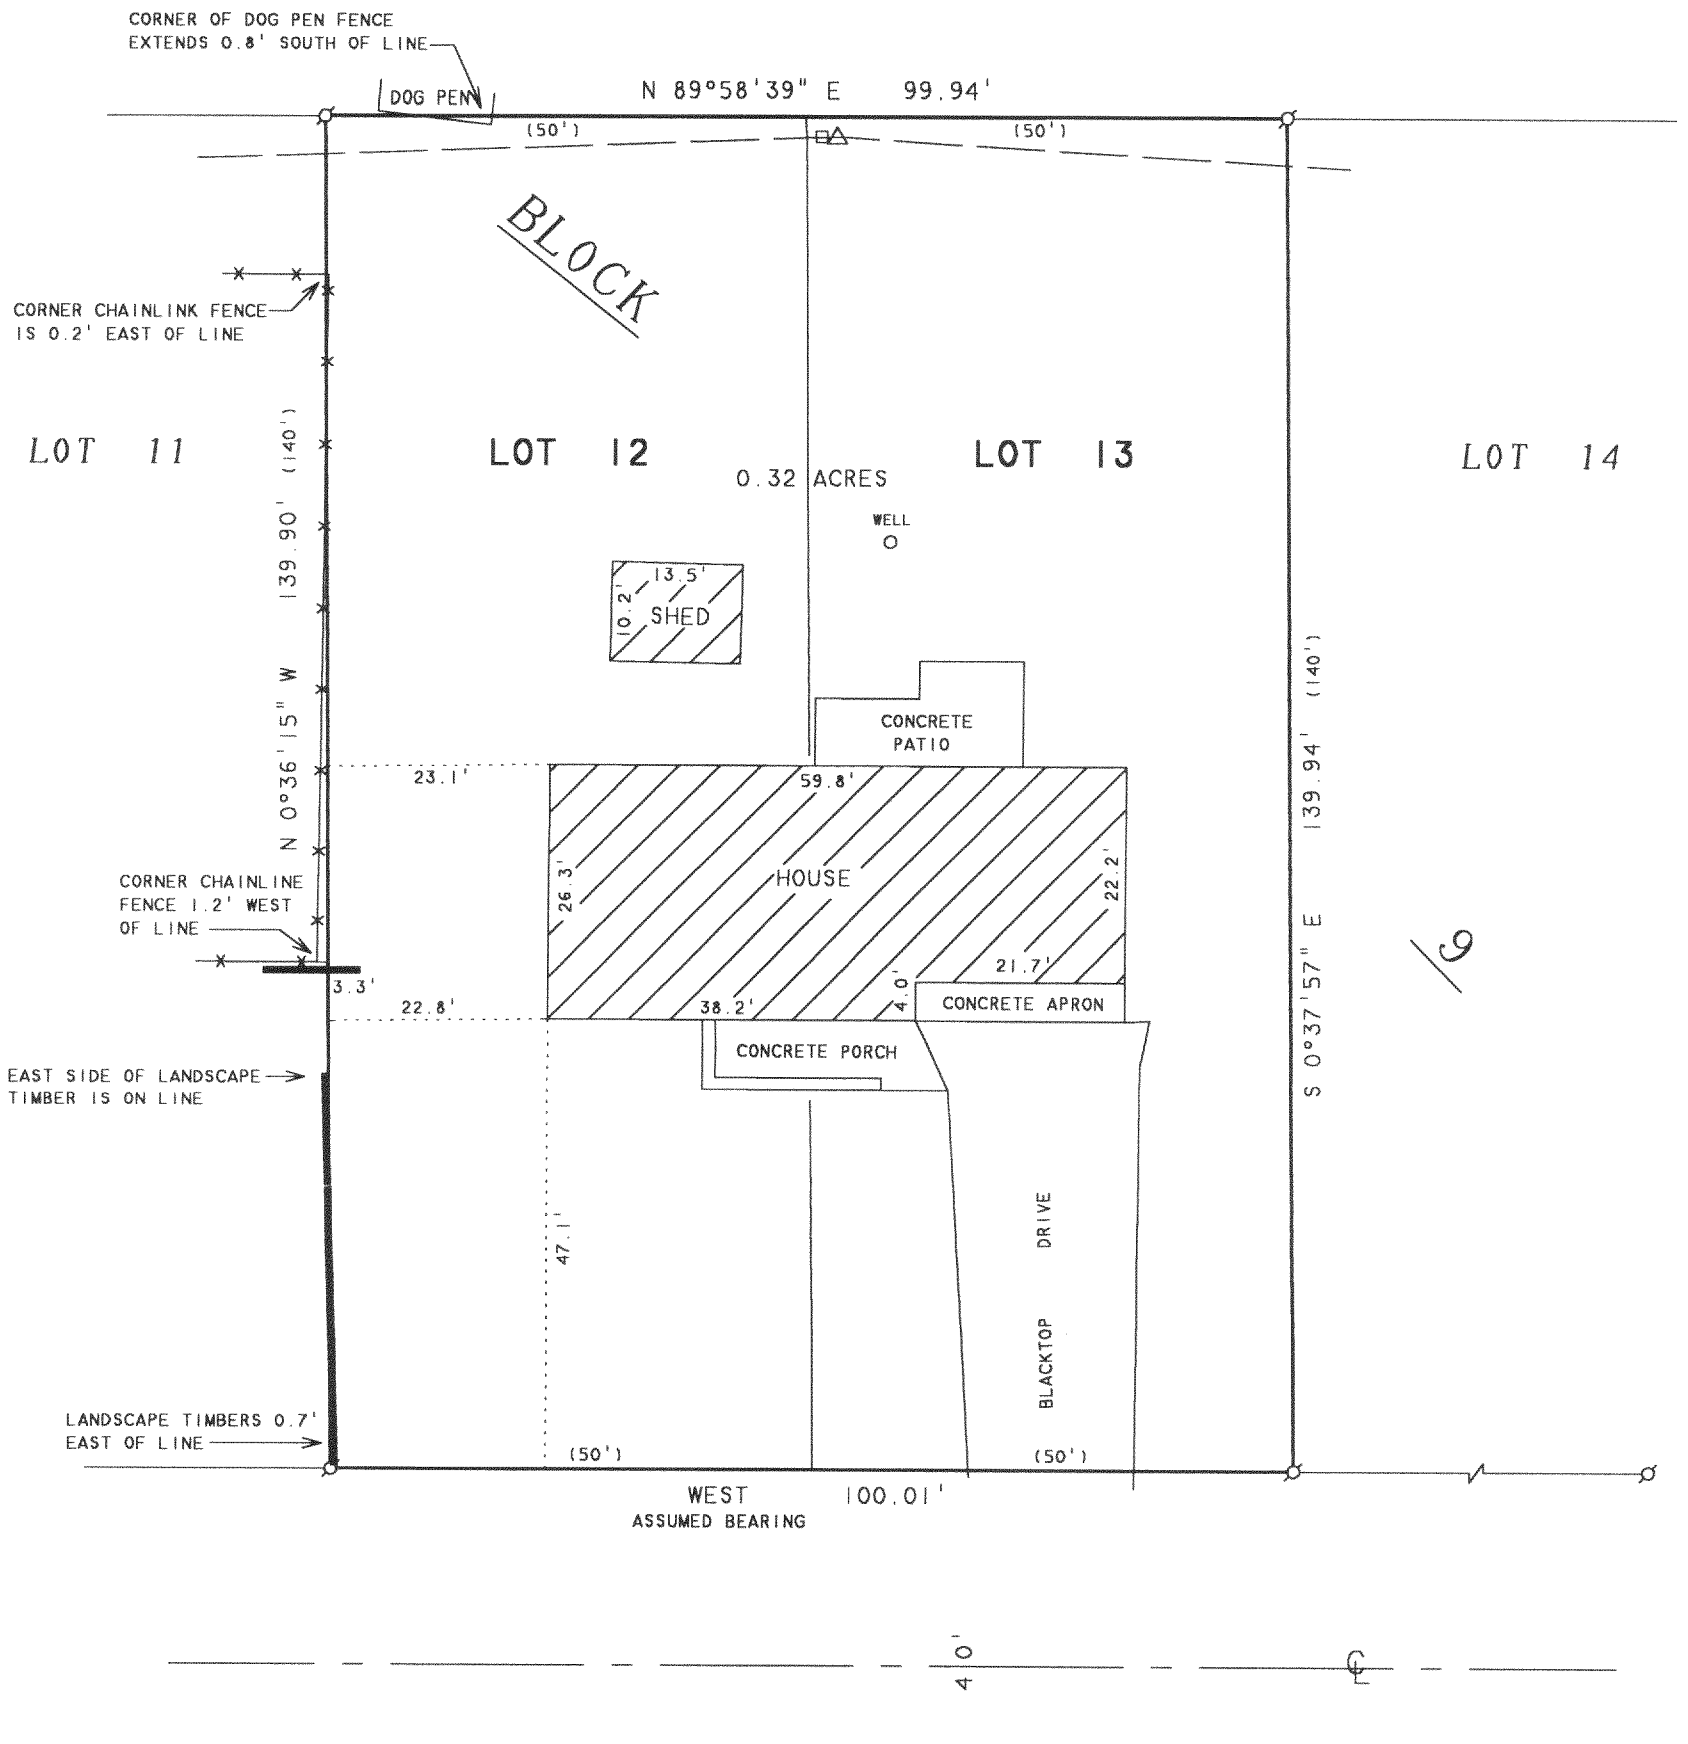

NOV 1 2 2002

DH

PLAT OF SURVEY OF

LOTS 12 AND 13, BLOCK 9, INLET OAKS SUBDIVISION NO. 4, LOCATED IN T2N,R16E, WALWORTH COUNTY, WISCONSIN.

ORDERED BY: JAN TWING
510 SCHROEDER AVE.
DELAVAN, WI 53115

N

SCALE 1"=20'

LEGEND

- ⌀ - IRON PIPE FOUND
- △ - UTILITY POLE
- □ - UTILITY PED
- ——— ——— - OVERHEAD UTILITY LINES
- -x-x-x- - CHAINLINK FENCE
- ( ) - RECORDED AS

I HEREBY CERTIFY THAT I HAVE SURVEYED THE ABOVE DESCRIBED PROPERTY AND THAT THE ABOVE MAP IS A TRUE REPRESENTATION THEREOF AND SHOWS THE SIZE AND LOCATION OF THE PROPERTY, ITS EXTERIOR BOUNDARIES, THE LOCATION OF ALL VISIBLE STRUCTURES AND DIMENSIONS OF ALL PRINCIPAL BUILDINGS THEREON, BOUNDARY FENCES, APPARENT EASEMENTS, ROADWAYS AND VISIBLE ENCROACHMENTS, IF ANY, TO THE BEST OF MY KNOWLEDGE AND BELIEF.

THIS SURVEY IS MADE FOR THE USE OF THE PRESENT OWNERS OF THE PROPERTY, AND ALSO THOSE WHO PURCHASE, MORTGAGE, OR GUARANTEE THE TITLE THERETO WITHIN ONE (1) YEAR FROM DATE HEREON.

David F. Abell

DAVID F. ABELL
WISCONSIN REGISTERED LAND SURVEYOR, S-1596

September 4, 2002

DATE JOB NUMBER - 02128

NOTE: THIS IS NOT A CERTIFIED COPY UNLESS SEALED.

FIN4-77C

216-3280