
DUNHAM SURVEYING, S.C.

SURVEYING & SUBDIVIDING
DELAVAN, WISCONSIN 53115

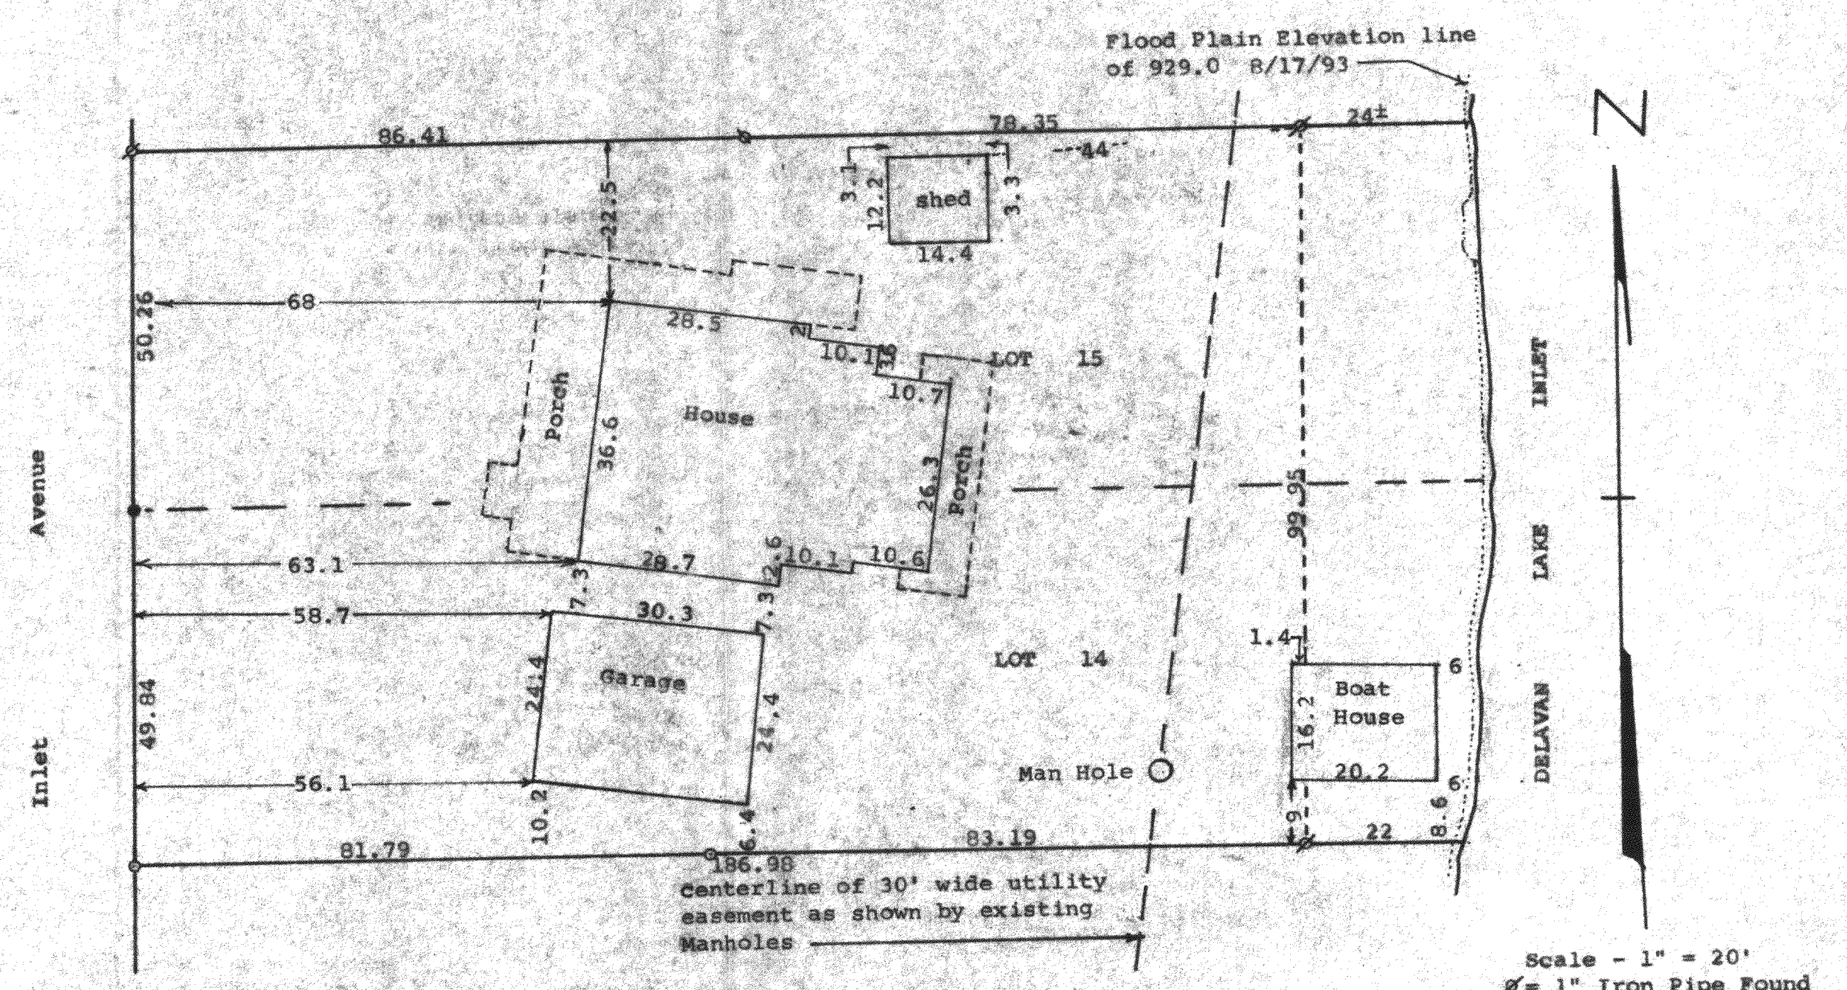

Scale - 1" = 20'
ø = 1" Iron Pipe Found
o = 3/4" Iron Pipe Found
x = ½" Iron Pipe Found
● = 1¼" Iron Pipe Found

Survey ordered by:
George Duncan
P.O. Box 34
Delavan, WI 53115
Updated and recertified to
this 2nd day of April, 2001
Ordered by:
Century 21 Affiliated
50 West Geneva
Williams Bay, WI 53191

STATE OF WISCONSIN)
COUNTY OF WALWORTH) SS

I, George T. Dunham, Surveyor, certify that I have surveyed the property described as follows:

Lots 14 and 15, Block 1 of The Inlet Oaks, a subdivision located in Section 22, T 2 N, R 16 E, Walworth County, Wisconsin

and that the plat shown hereon is a correct representation thereof and shows the size and location of the property, its exterior boundaries, the location of all visible structures and dimensions of all principal buildings thereon, boundary fences, apparent easements, roadways and visible encroachments, if any, and that I have surveyed the property hereon described, according to the official records, to the best of my knowledge and belief.

May 10. 1991
Revised May 21, 1991
Revised August 17, 1993 to show Elevation 929.0 line. Flood plain line
Updated and recertified to this 2nd day of April, 2001

George T. Dunham, Surveyor

RECEIVED
MAY 9 2003
DRD

WISCONSIN
GEORGE T. DUNHAM
S-306
DELAVAN WIS.
LAND SURVEYOR

FIN-8

216-3392