
DUNHAM SURVEYING, S.C.

SURVEYING & SUBDIVIDING
DELAVAN, WISCONSIN 53115

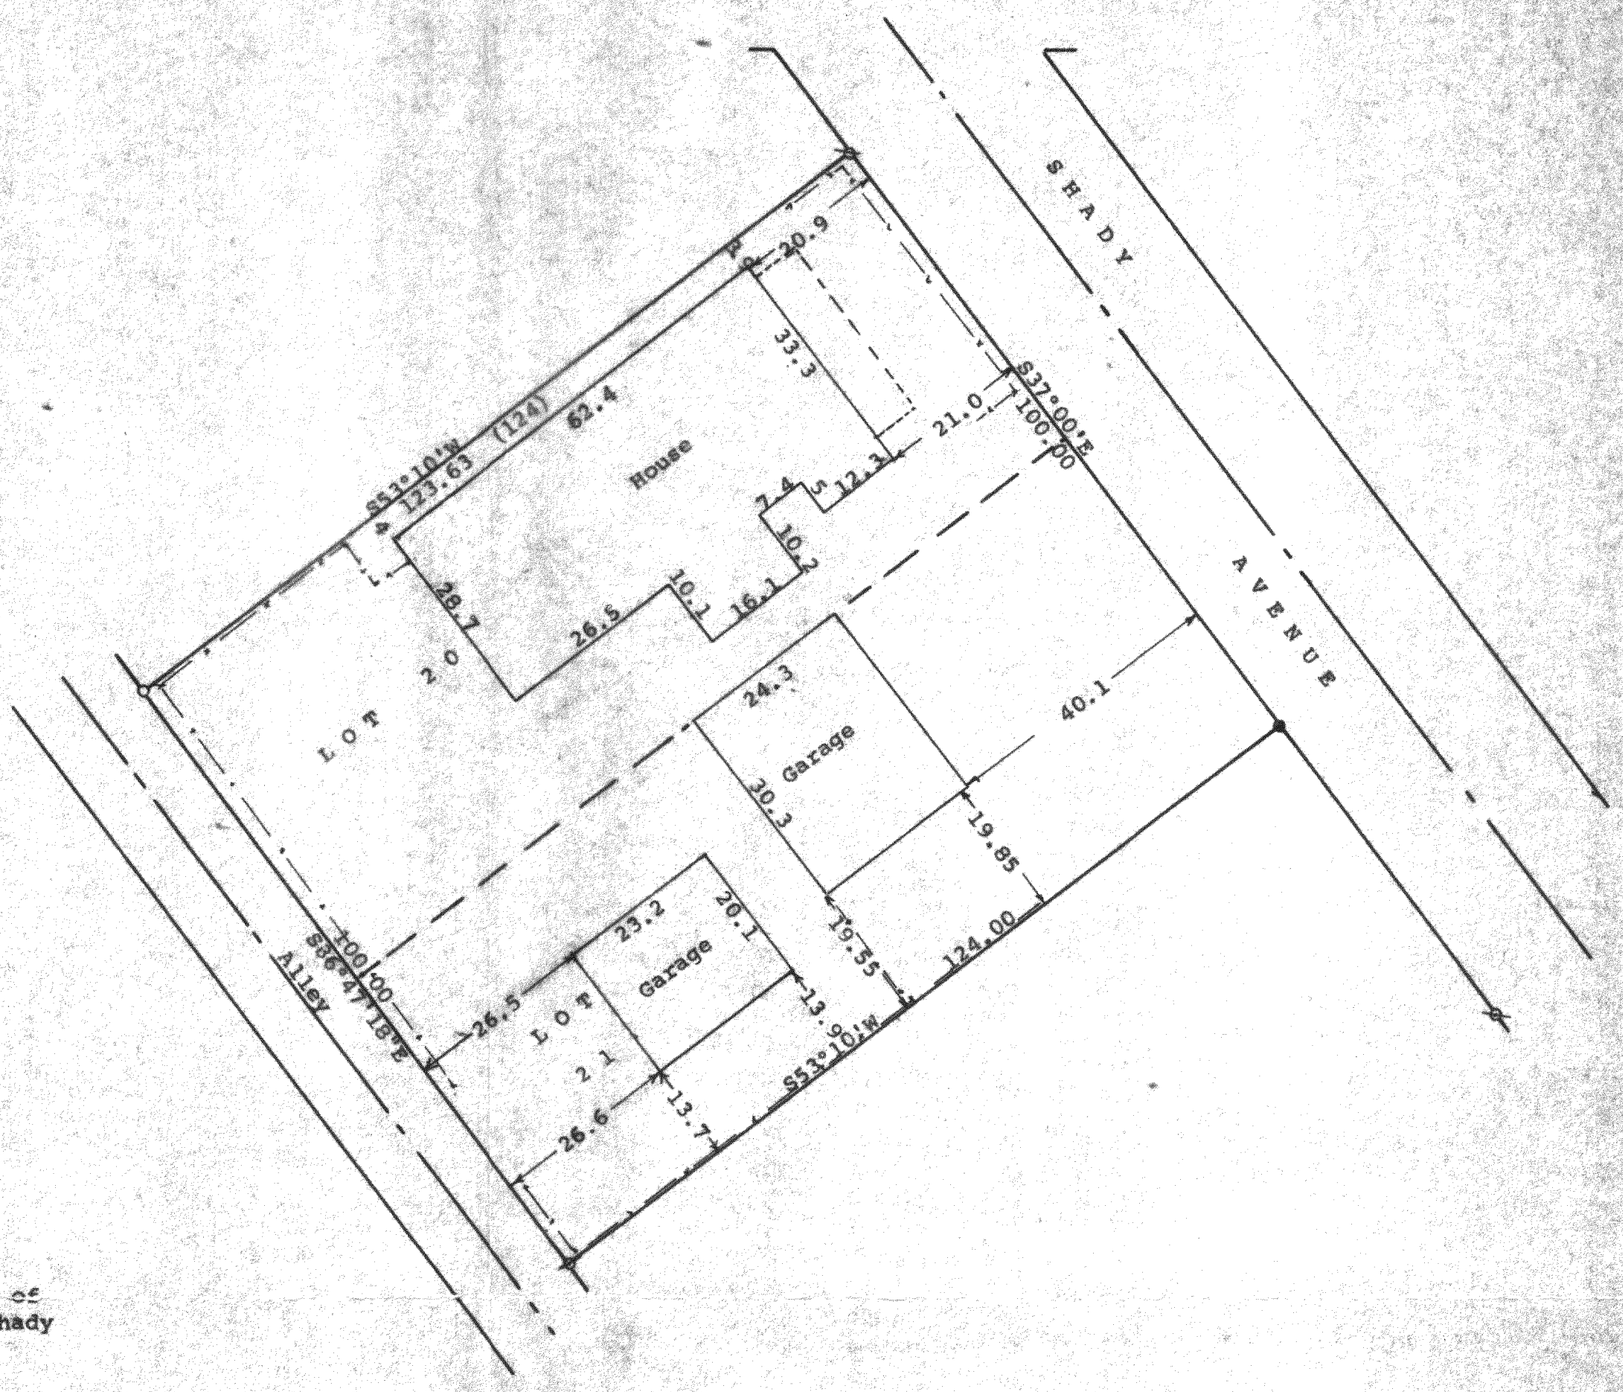

Scale - 1" = 20'
⊗ = 1½" Iron Pipe Found
⌀ = 1" Iron Pipe Found
○ = 3/4" Iron Pipe Found
● = 3/4" Square iron rod found
(0.00) = recorded distance
-x—x- = fence line

Bearings referenced to the assumed bearing of S37°00'E along the southwesterly line of Shady Avenue

Survey ordered by: Mrs Raymond Alberth
837 Shady Avenue
Delavan, WI 53115

STATE OF WISCONSIN)
COUNTY OF WALWORTH) SS

I, George T. Dunham, Surveyor, certify that I have surveyed the property described as follows:

Lots 20 and 21 in Block 2 of Inlet Oaks, a subdivision located in Section 22, T 2 N, R 16 E, Walworth County, Wisconsin.

and that the plat shown hereon is a correct representation thereof and shows the size and location of the property, its exterior boundaries, the location of all visible structures and dimensions of all principal buildings thereon, boundary fences, apparent easements, roadways and visible encroachments, if any, and that I have surveyed the property hereon described, according to the official records, to the best of my knowledge and belief.

April 5, 1991
Updated and recertified to this
31st day of October, 2000

George T. Dunham, Surveyor

WISCONSIN
GEORGE T. DUNHAM
S-306
DELAVAN WIS.
LAND SURVEYOR

RECEIVED
MAY 9 2003
DRP

F I N - 1 8

816-3393

GMB 1020