
DUNHAM SURVEYING, S.C.
SURVEYING & SUBDIVIDING
DELAVAN, WISCONSIN 53115



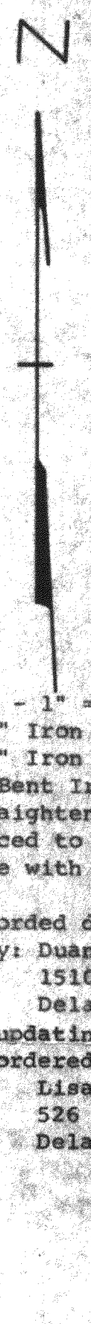

Scale - 1" = 20'
● = 5/8" Iron Rod Found
○ = 3/4" Iron Pipe Set
ø = 1" Bent Iron Pipe Found
Straightened and reset
Bearings referenced to the north line of Valencia Drive with the recorded bearing of East
(0.00) = recorded distance
Survey ordered by: Duane Altergott
1510 S. Shore Drive
Delavan, WI 53115
May 23rd, 2000, updating and recertification ordered by:
Lisa Altergott
526 Valencia Drive
Delavan, WI 53115

STATE OF WISCONSIN) SS
COUNTY OF WALWORTH)

I, George T. Dunham, Surveyor, certify that I have surveyed the property described as follows:

Lot 11 in Block 14 of Inlet Oaks Subdivision No. 5, located in Section 15, T 2 N, R 16 E, Walworth County, Wisconsin,

and that the plat shown hereon is a correct representation thereof and shows the size and location of the property, its exterior boundaries, the location of all visible structures and dimensions and location of the proposed house to be built on said lot, apparent easements, roadways and visible encroachments, if any, and that I have surveyed the property hereon described, according to the official records, to the best of my knowledge and belief.

May 21, 1994
Revised July 11, 1994 to show location of existing foundation
Updated and recertified to this 23rd day of May, 2000

George T. Dunham, Surveyor

RECEIVED
MAY 9 2003

WISCONSIN
GEORGE T. DUNHAM
S-306
DELAVAN WIS.
LAND SURVEYOR

F1N549

216-3404