


DUNHAM SURVEYING, S.C.
SURVEYING & SUBDIVIDING
DELAVER, WISCONSIN 53115

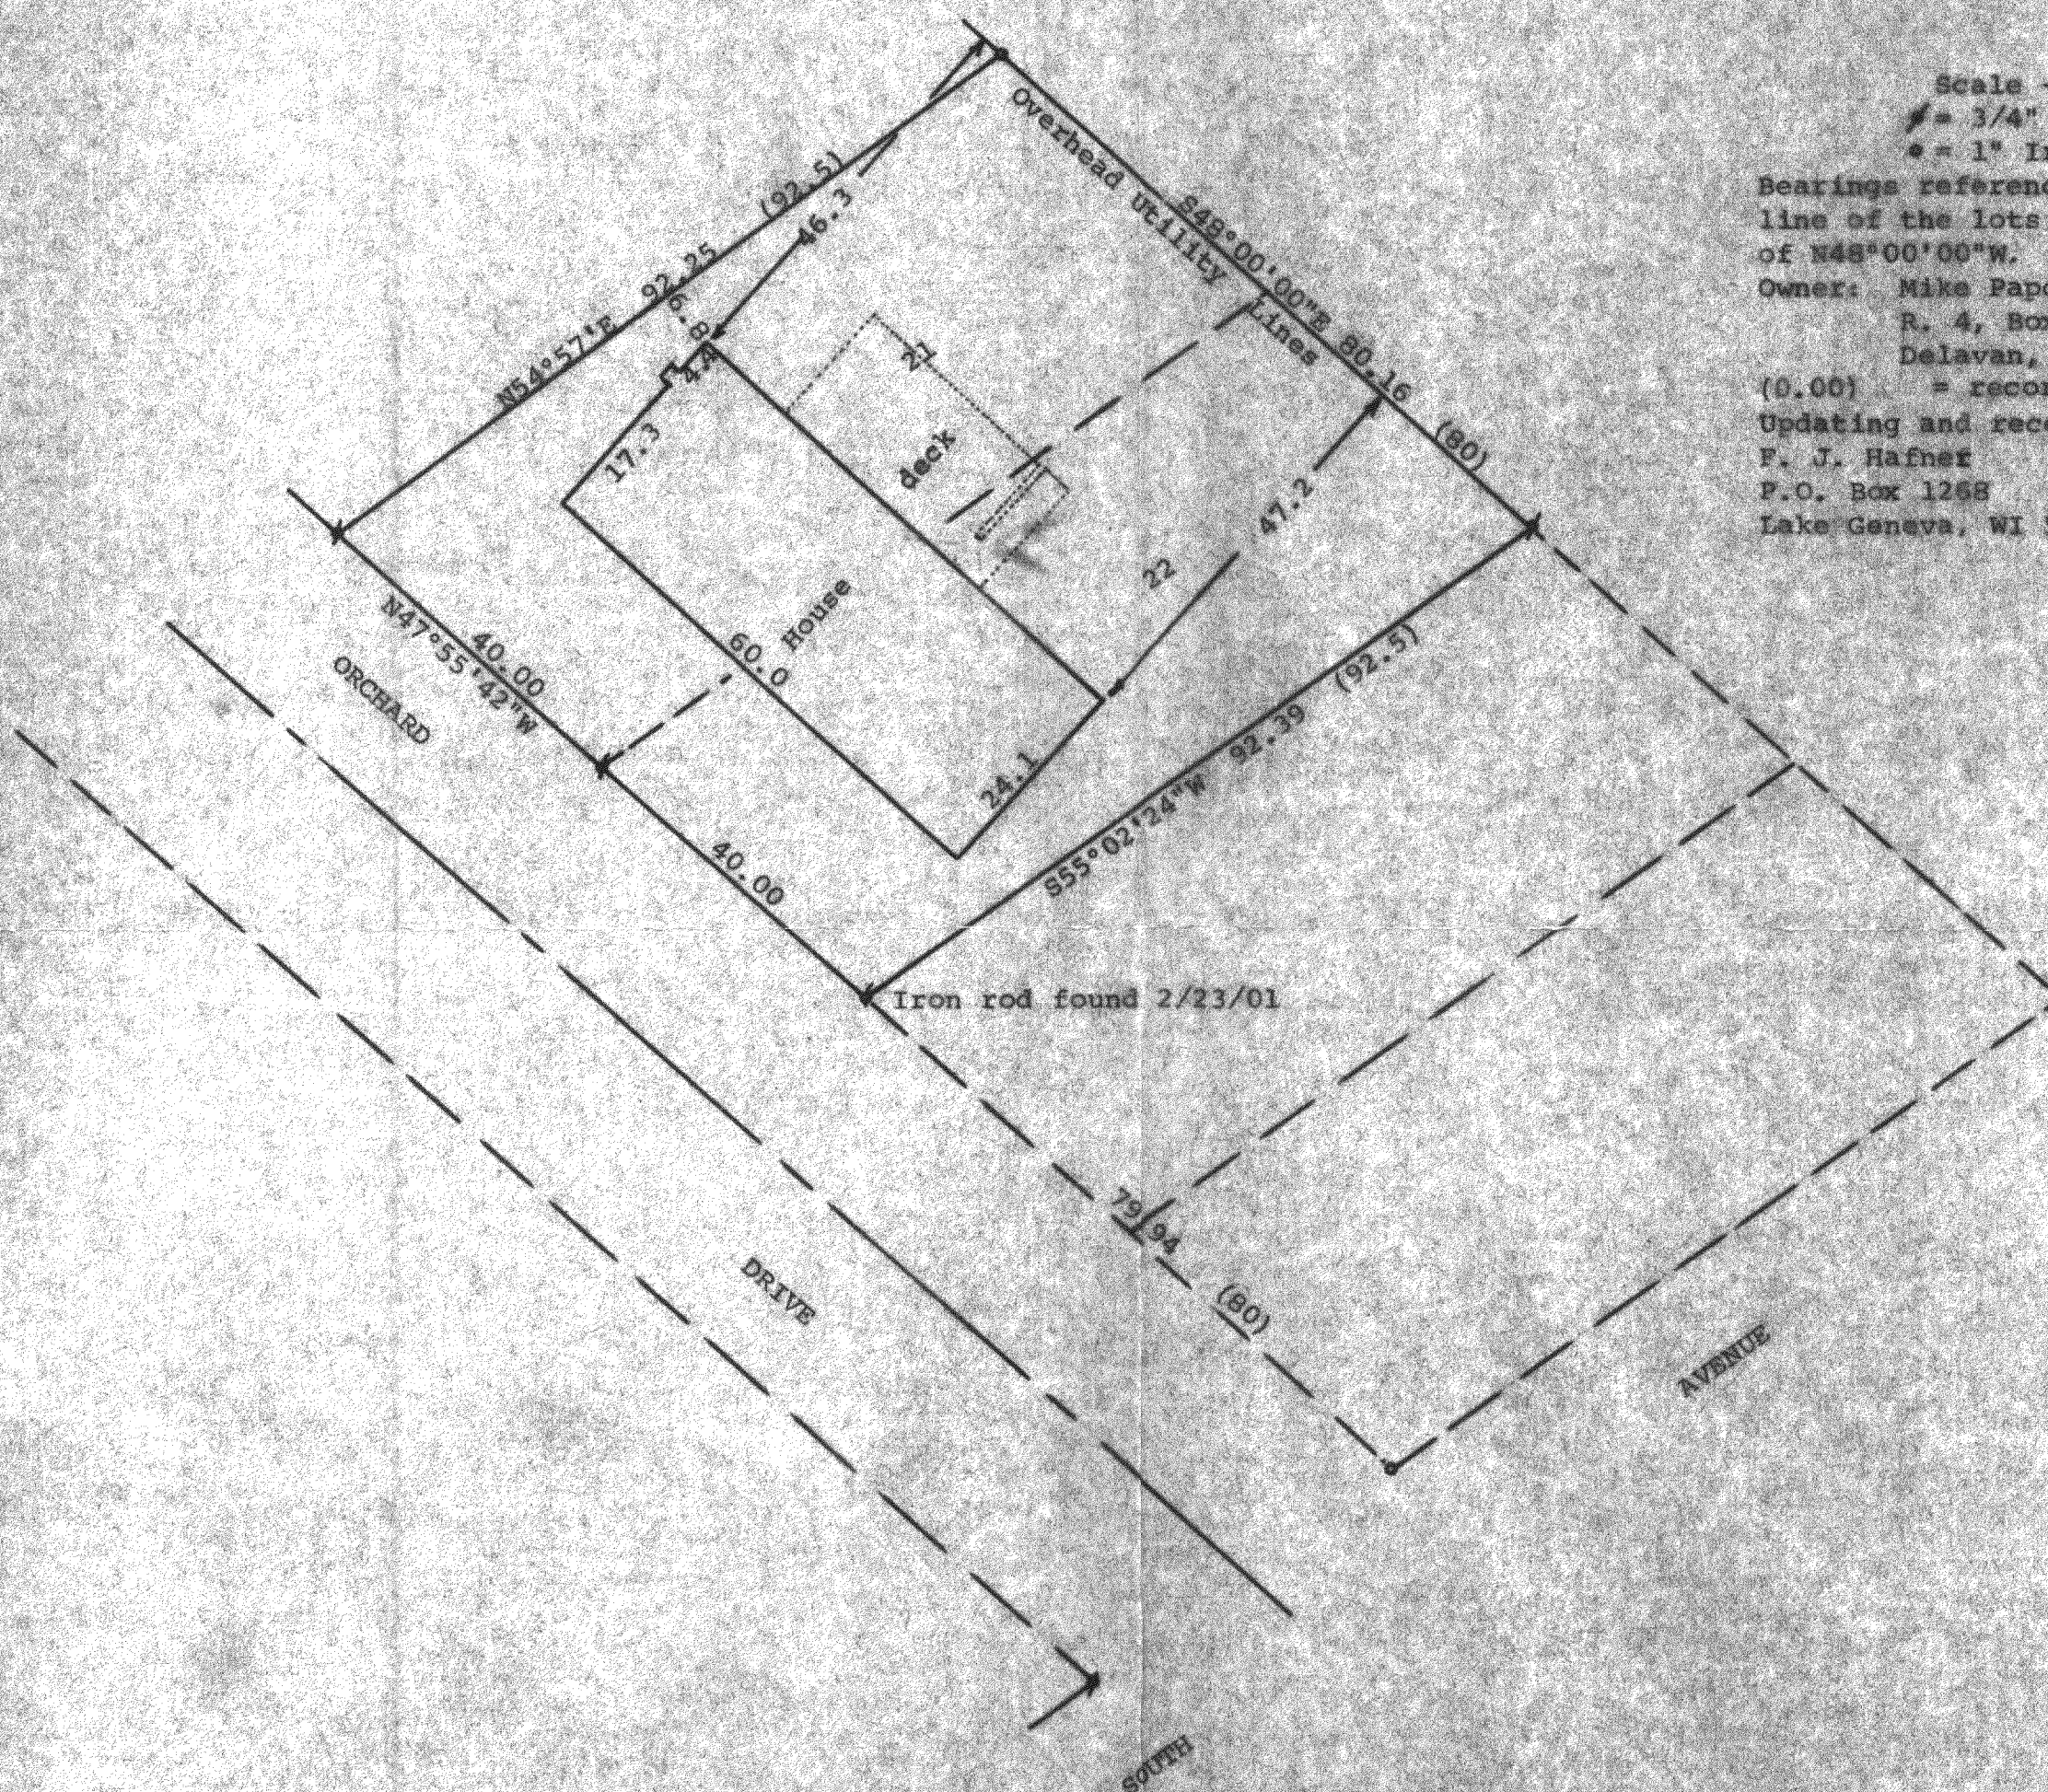

Scale - 1" = 20'
 3/4" Iron Pipe Found
 1" Iron Pipe Found
 Bearings referenced to the northeasterly
 line of the lots with the assumed bearing
 of N48°00'00"W.
 Owner: Mike Papcke
 R. 4, Box 438C
 Delavan, WI 53115
 (0.00) = recorded distance
 Updating and recertification ordered by:
 F. J. Hafner
 P.O. Box 1268
 Lake Geneva, WI 53147

STATE OF WISCONSIN)
 COUNTY OF WALWORTH)
 I, George T. Dunham, Surveyor, certify that I have surveyed the
 property described as follows:
 Lots 21 and 22 in Block 7 in South Shore Manor, a subdivision
 located in the Southeast Fractional 1/4 of Section 32, T 2 N,
 R 16 E, Walworth County, Wisconsin,
 and that the map shown above is a true representation thereof and shows
 the size and location of the property, its exterior boundaries, the location
 of all visible structures and dimensions of all principal buildings thereon,
 boundary fences, apparent easements, roadways and visible encroachments, if
 any, and that I have surveyed the property hereon described according to the
 official records, to the best of my knowledge and belief.
 October 2, 1985
 Revised January 9, 1986
 Updated and recertified to this February,
 23rd, 2001

George T. Dunham
 George T. Dunham, Surveyor

