


DUNHAM SURVEYING, S.C.
SURVEYING & SUBDIVIDING
DELAVER, WISCONSIN 53115

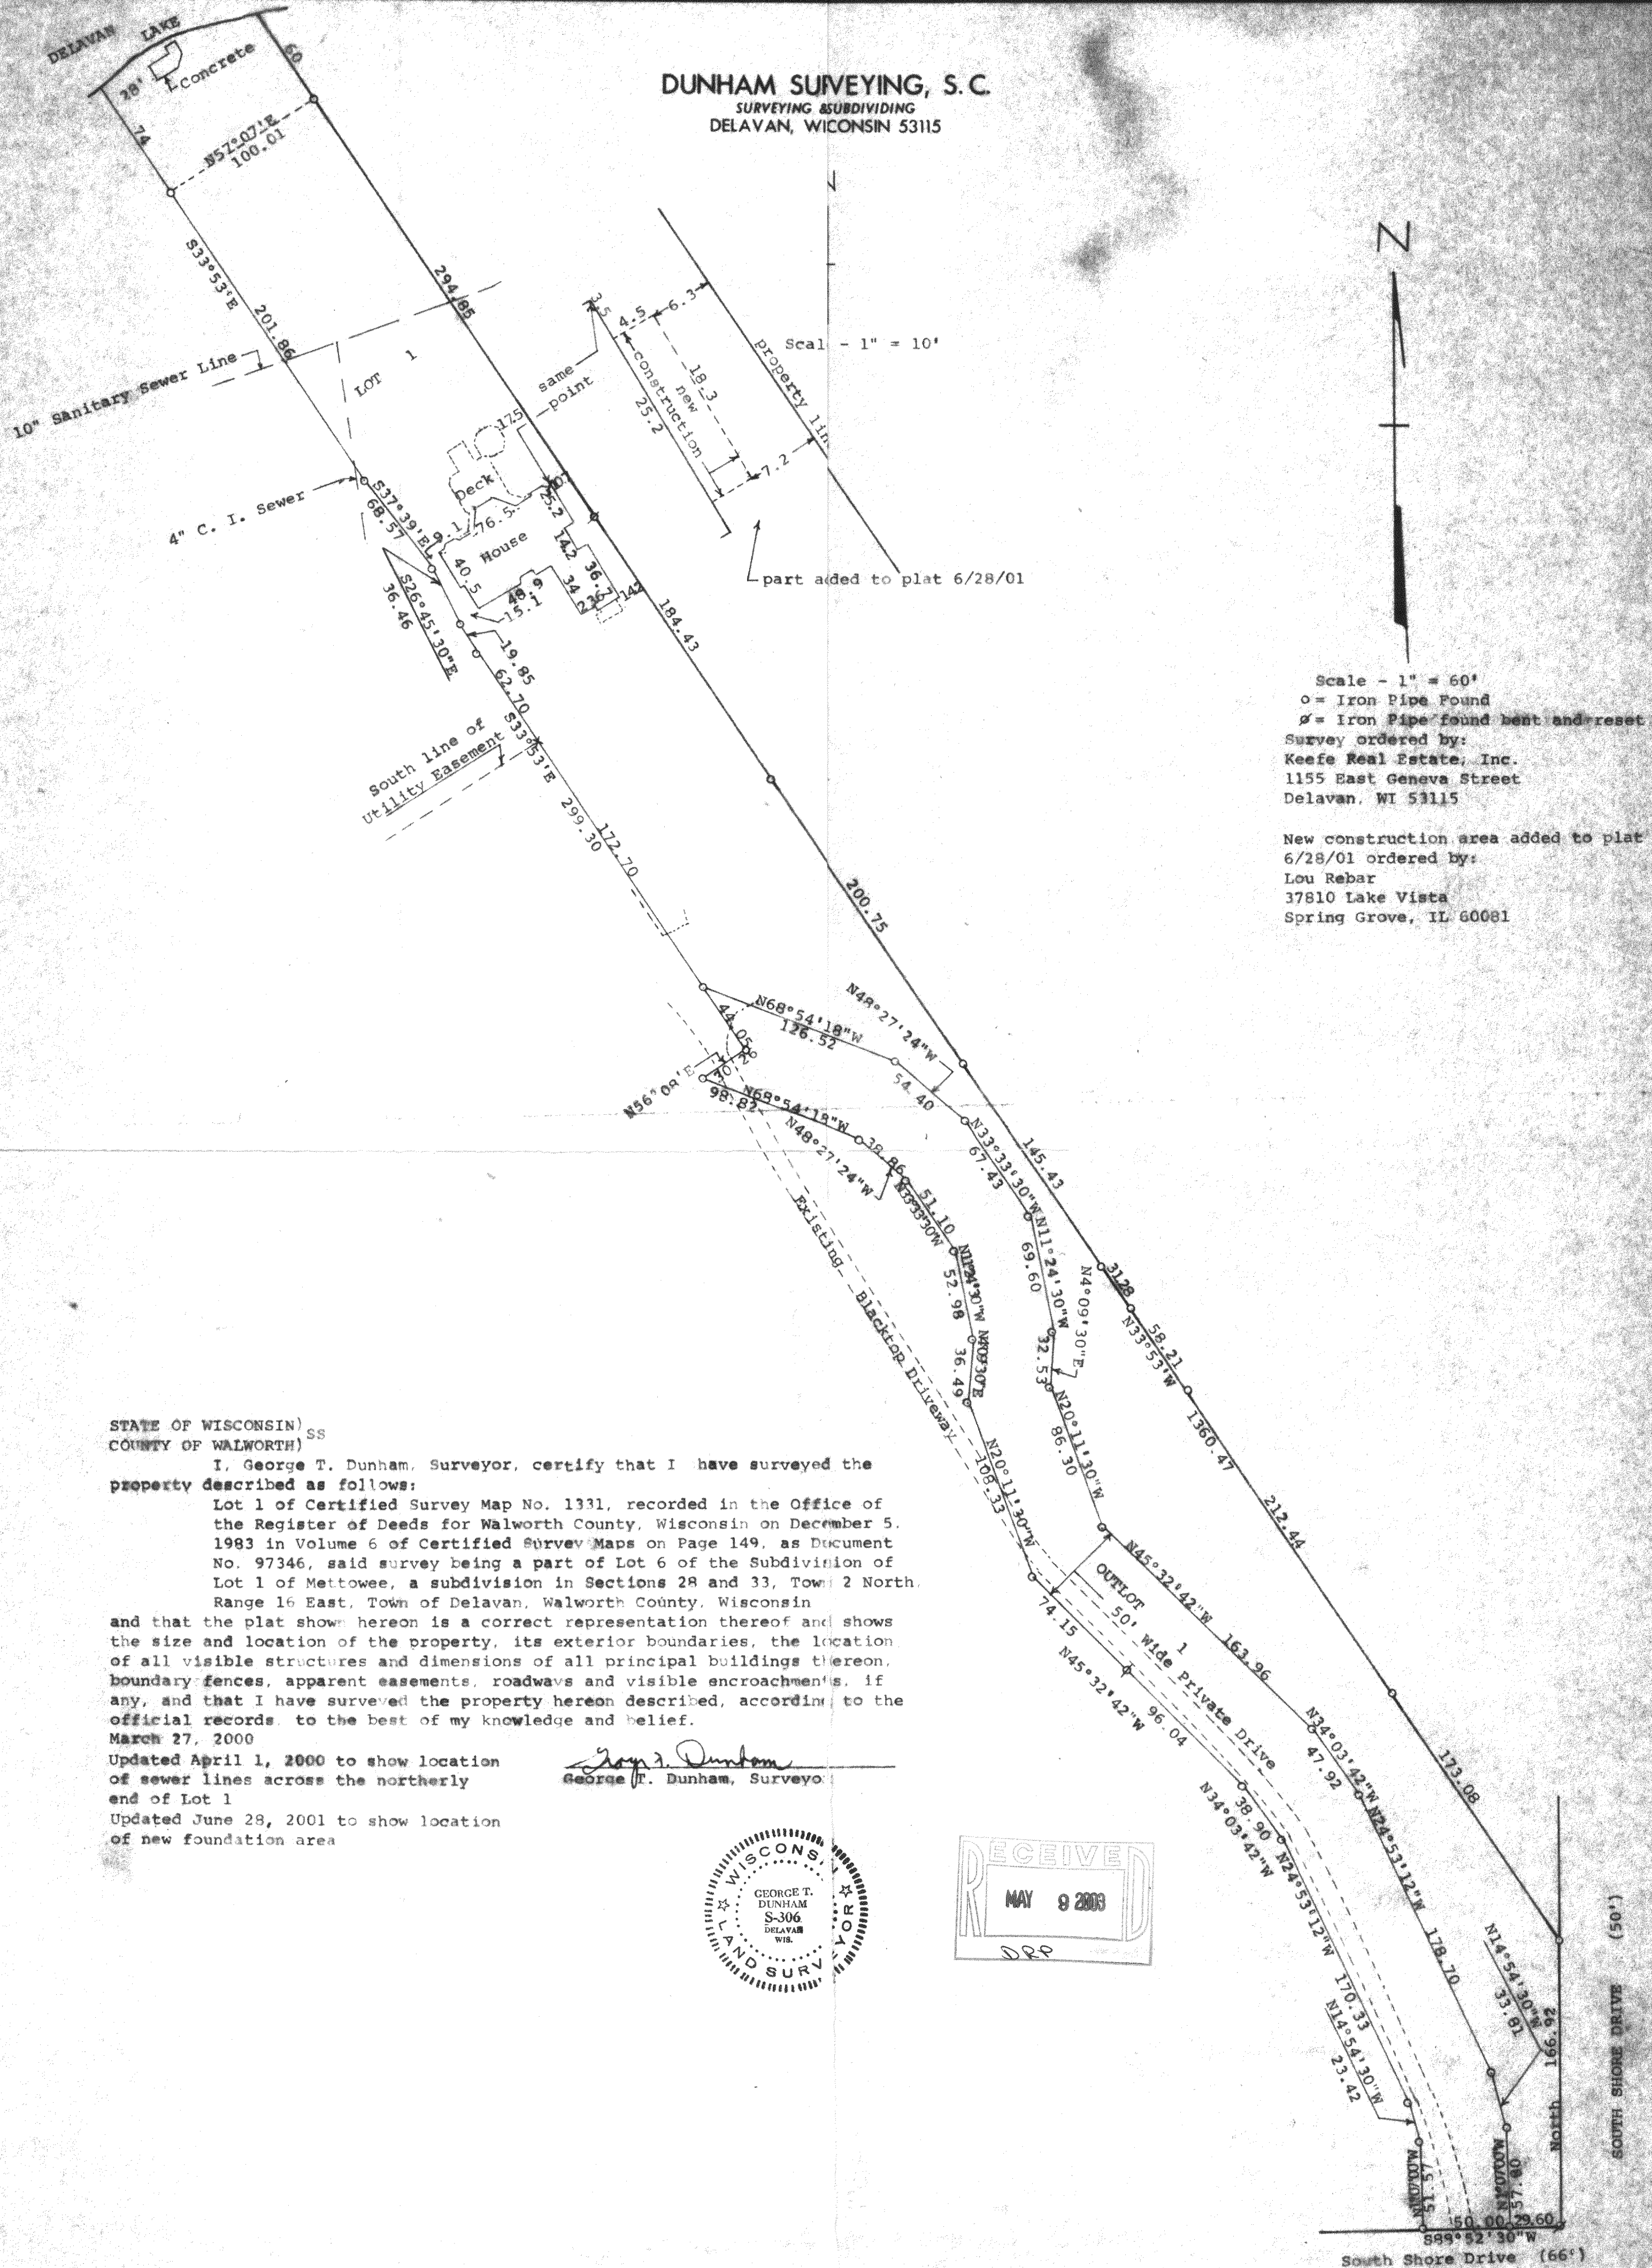

STATE OF WISCONSIN) SS
COUNTY OF WALWORTH)

I, George T. Dunham, Surveyor, certify that I have surveyed the property described as follows:

Lot 1 of Certified Survey Map No. 1331, recorded in the Office of the Register of Deeds for Walworth County, Wisconsin on December 5, 1983 in Volume 6 of Certified Survey Maps on Page 149, as Document No. 97346, said survey being a part of Lot 6 of the Subdivision of Lot 1 of Mettewee, a subdivision in Sections 28 and 33, Town 2 North, Range 16 East, Town of Delavan, Walworth County, Wisconsin

and that the plat shown hereon is a correct representation thereof and shows the size and location of the property, its exterior boundaries, the location of all visible structures and dimensions of all principal buildings thereon, boundary fences, apparent easements, roadways and visible encroachments, if any, and that I have surveyed the property hereon described, according to the official records, to the best of my knowledge and belief.

March 27, 2000

Updated April 1, 2000 to show location of sewer lines across the northerly end of Lot 1

Updated June 28, 2001 to show location of new foundation area

George T. Dunham
George T. Dunham, Surveyor

